


#4

Application No. 63914  
Permit No. 48686

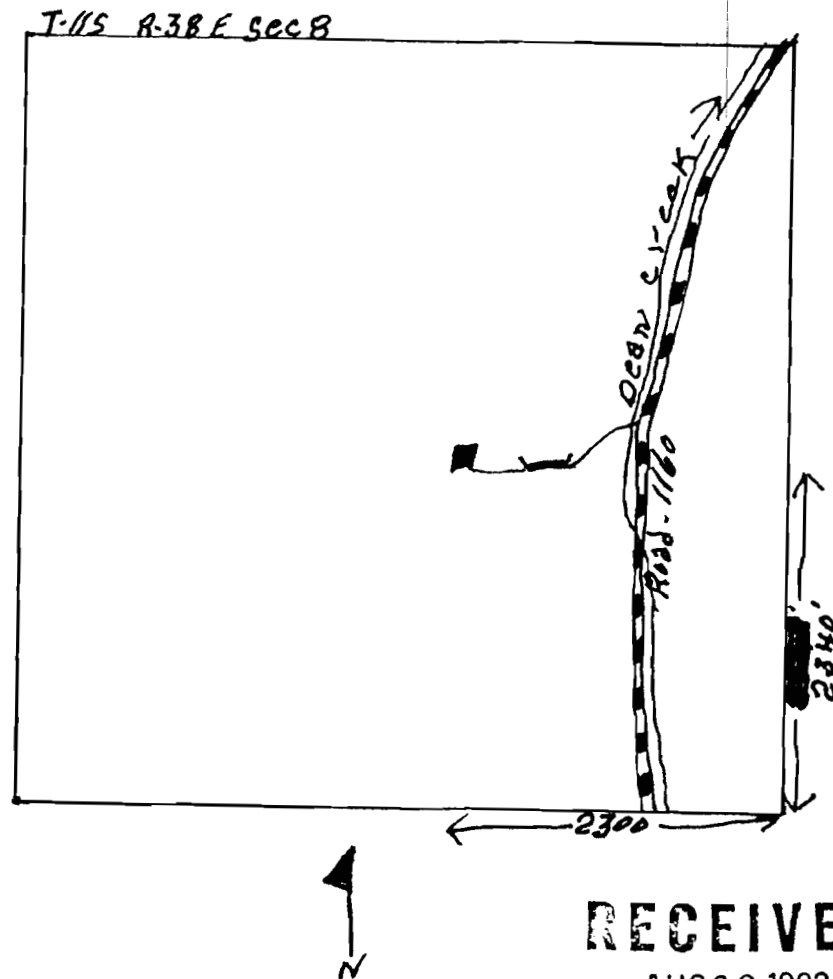

4" = 1 mile

**RECEIVED**

AUG 23 1982

WATER RESOURCES DEPT.  
SALEM, OREGON

**RECEIVED**

APR 29 1983

WATER RESOURCES DEPT.  
SALEM, OREGON