


Application No. 63916
Permit No. 48688

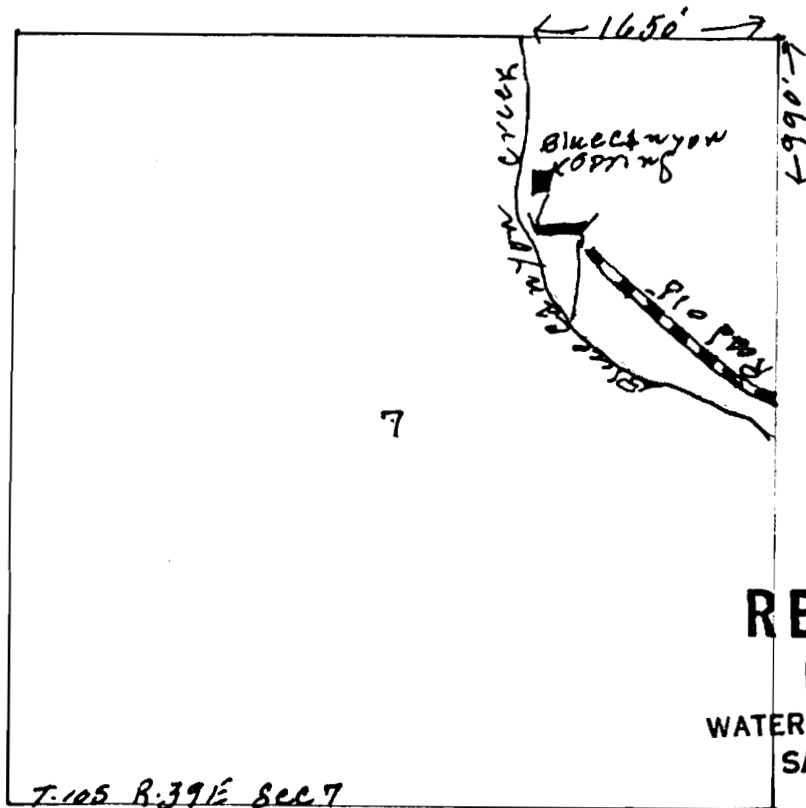

RECEIVED

MAR 25 1983

WATER RESOURCES DEPT.
SALEM, OREGON

RECEIVED

AUG 23 1982

WATER RESOURCES D. T.
SALEM, OREGON