


COMPUTATION SHEET

Application No. 63917
Permit No. 48689

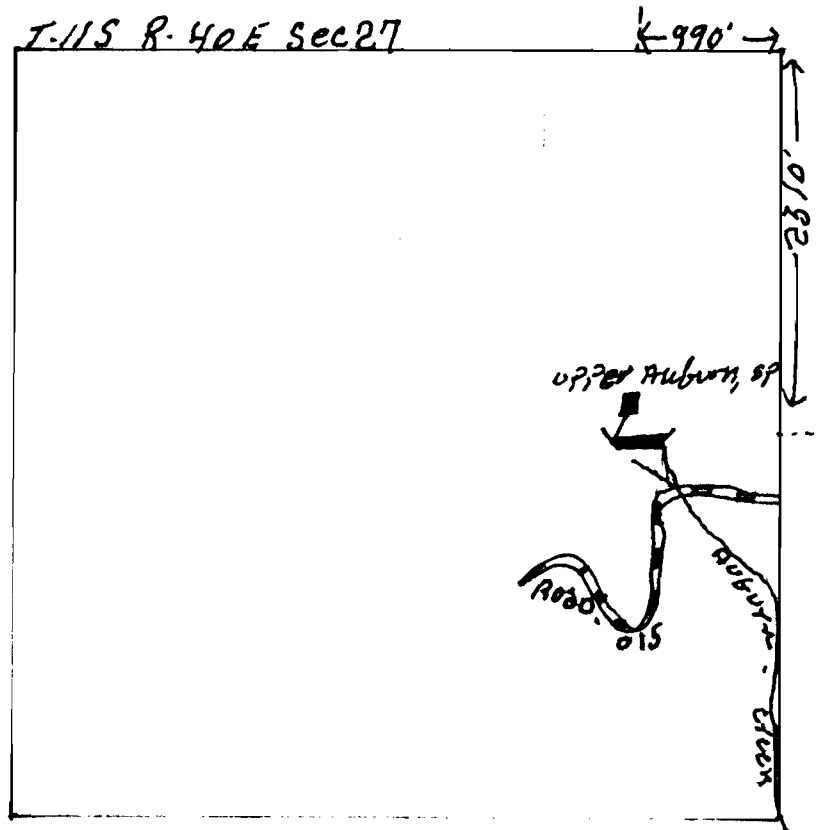

RECEIVED

MAR 25 1983

WATER RESOURCES DEPT. 4" = 1 Mile
SALEM, OREGON



RECEIVED

AUG 23 1982

WATER RESOURCES D. T.
SALEM, OREGON