


T. 27 S. R. 17 E. W. M.

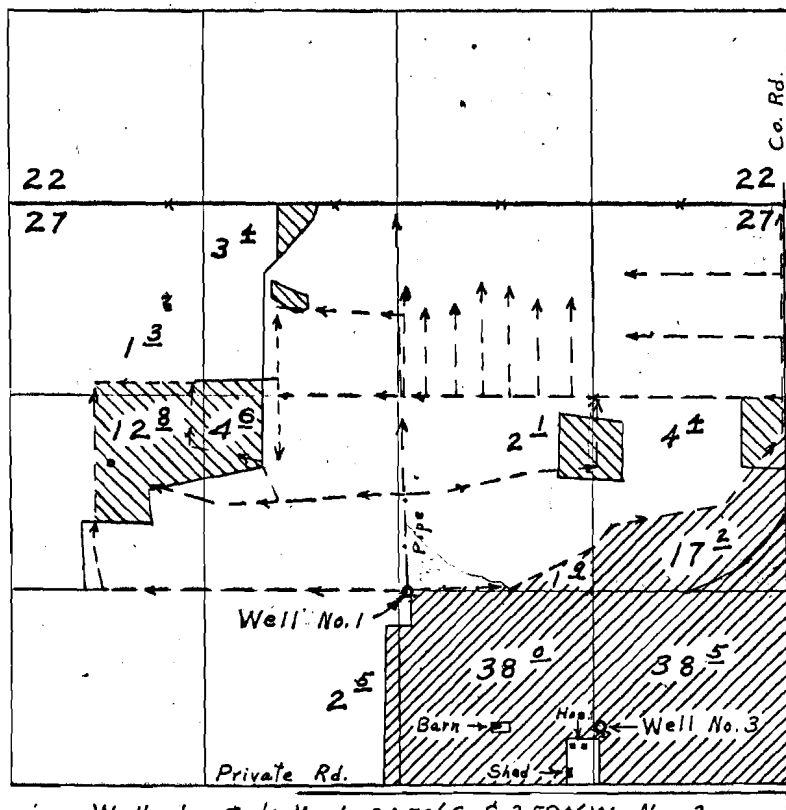

Wells located; No. 1, 2650' S. & 2590' W., No. 3, 3570' S. & 1290' W. both from N.E. Cor. Sec. 27

WELL No. 1 
 WELL No. 3 

FINAL PROOF SURVEY
 UNDER


Application No. G-2292. Permit No. G-2165
 IN NAME OF
 CENTURY RANCH (LOSSIE HOWARD)

Surveyed July 30, 1968, by L. E. Gould

G-2165

See T 6614
65888

36201
51864
75280

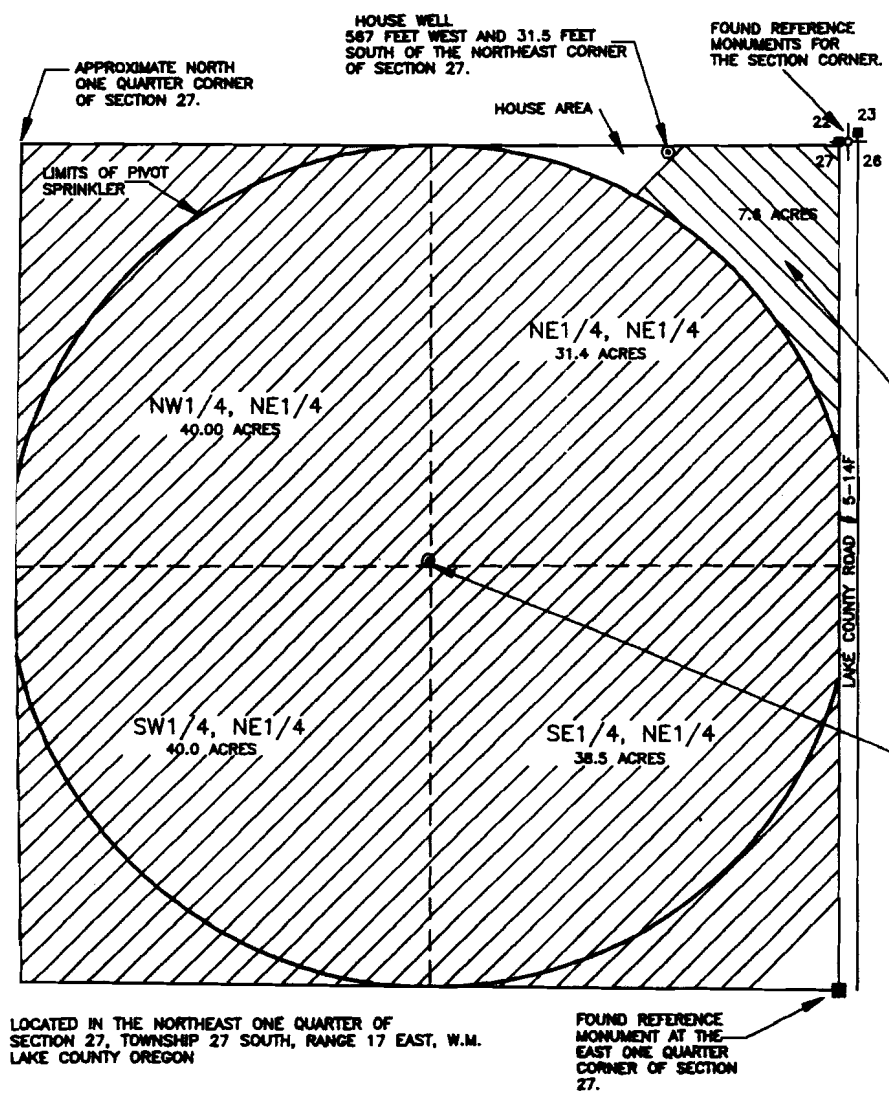

FINAL PROOF SURVEY
AND
CLAIM OF BENEFICIAL USE
UNDER TRANSFER 6614
CHANGE IN POINT OF APPROPRIATION ONLY
IN THE NAME OF
JULIA ANN WHEELER

ORIGINAL WATER RIGHTS PERFECTED UNDER
PERMITS U-487 AND G-2165

SCALE 1"=400'


AREA IRRIGATED FROM HAND SPRINKLER LINES
FROM HOUSE WELL

- AREA BEING IRRIGATED UNDER PIVOT WELL
- AREA BEING IRRIGATED UNDER HOUSE WELL

PIVOT WELL
1337.4 FEET WEST AND 1337.5 FEET
SOUTH OF THE NORTHEAST CORNER
OF SECTION 27.

CORNER AREAS NOT UNDER PIVOT ARE BEING IRRIGATED WITH HAND LINE SPRINKLERS
3 INCH HAND LINE CAN ATTACH TO END OF PIVOT
SEE ATTACHED SITE REPORT FOR FURTHER INFORMATION

LOCATED IN THE NORTHEAST ONE QUARTER OF
SECTION 27, TOWNSHIP 27 SOUTH, RANGE 17 EAST, W.M.
LAKE COUNTY OREGON

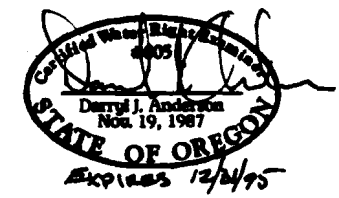

PREPARATION OF THIS MAP IS FOR WATER RIGHT CONSIDERATIONS ONLY AND DOES NOT
INDICATE PROPERTY OR OWNERSHIP LINES

REVISIONS	BY
8/30/95	DJA

AMERICAN ENGINEERING & SURVEYING
P.O. BOX 434
CHRISTMAS VALLEY, OREGON 97630
(503) 947-4497
FAX 947-4551

AS

PREPARED FOR: JULIA ANN WHEELER
P.O. BOX 434
CHRISTMAS VALLEY, OR 97641

DATE: JULY 1995
SCALE: 1" = 400'
DWG. BY: DJA
JOB # 95082
DWG. FILE: 95082

SHEET
1
OF 1 SHEETS