


COMPUTATION SHEET

Application No. 63920
Permit No. 48692

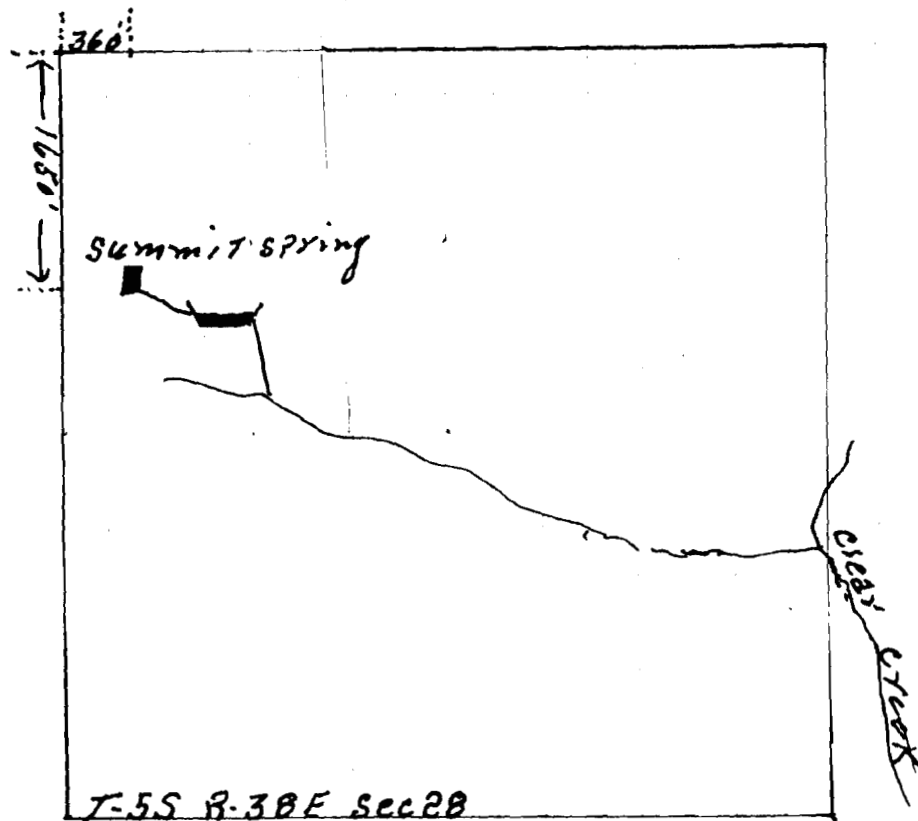

RECEIVED

MAR 25 1983

WATER RESOURCES DEPT. = 1 Mile
SALEM, OREGON



RECEIVED

AUG 23 1982

WATER RESOURCES DEPT.
SALEM, OREGON