


Application No. 63923
Permit No. 48695

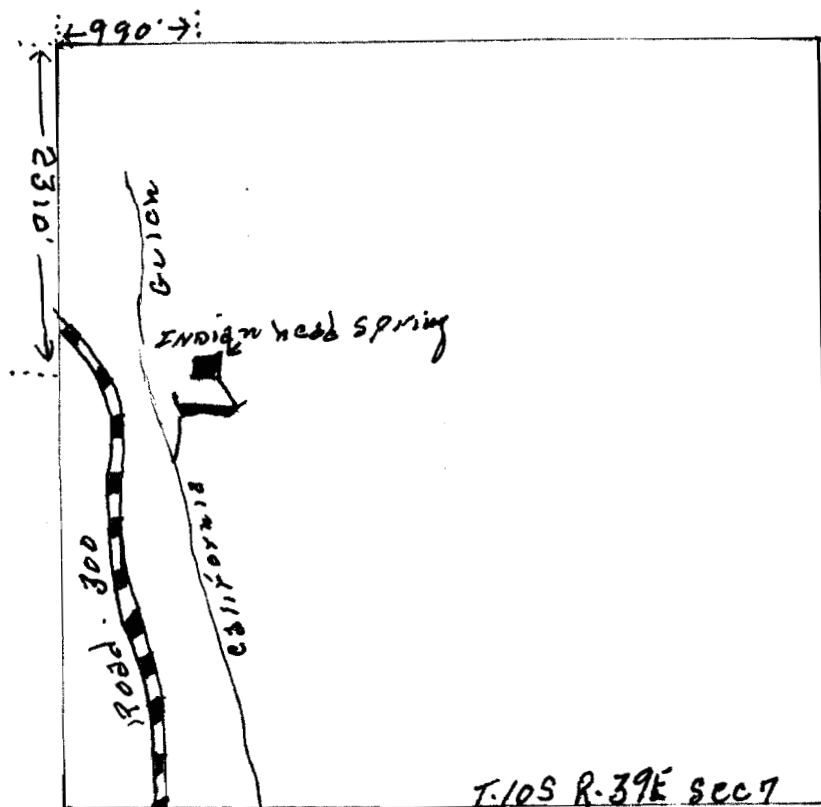

N
4" = 1 Mile

RECEIVED

AUG 23 1982

WATER RESOURCES DEPT.
SALEM, OREGON

RECEIVED

MAR 25 1983

WATER RESOURCES DEPT.
SALEM, OREGON