


Application No. 63924
Permit No. 48696

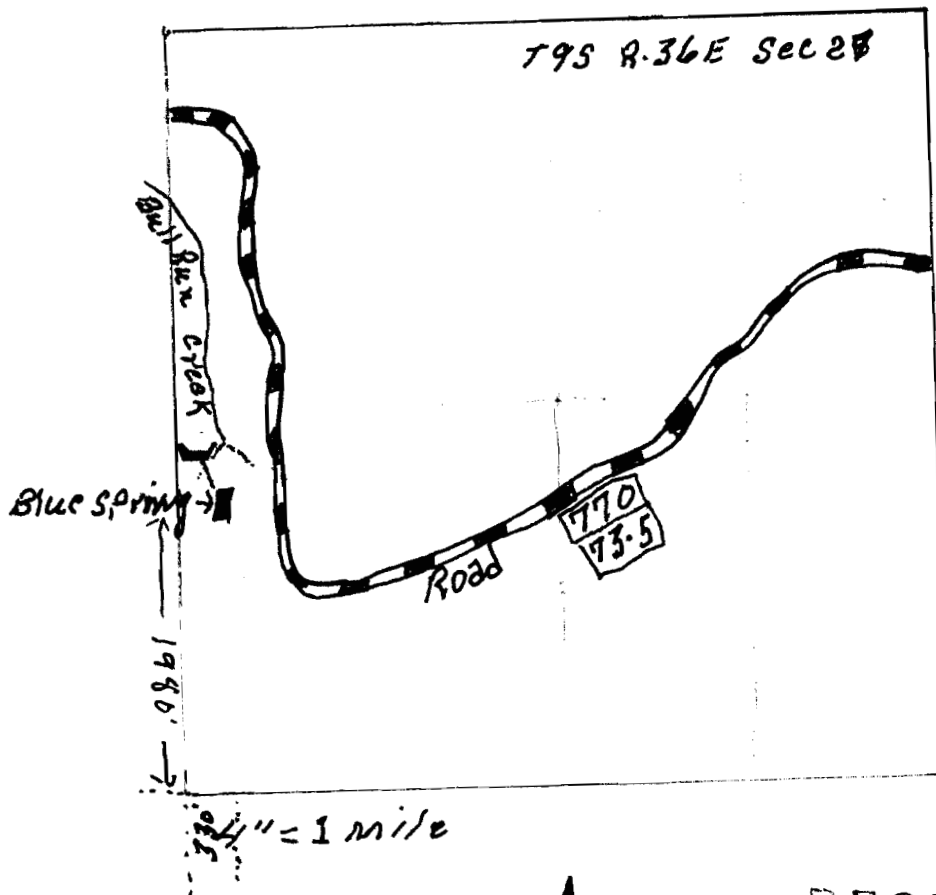

RECEIVED

AUG 23 1982

WATER RESOURCES DEPT.
SALEM, OREGON

RECEIVED

APR 29 1983

WATER RESOURCES DEPT.
SALEM, OREGON

RECEIVED

MAR 25 1983

WATER RESOURCES DEPT.
SALEM, OREGON