


Application No. 63925
Permit No. 48697

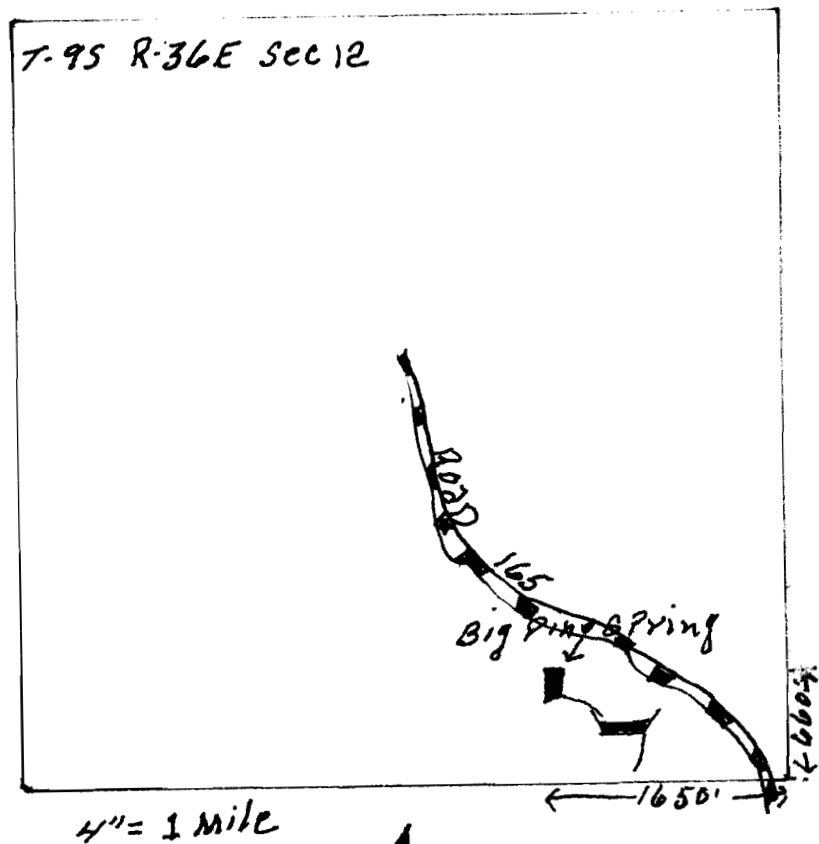

RECEIVED

MAR 25 1983

WATER RESOURCES DEPT.
SALEM, OREGON

RECEIVED

AUG 23 1982

WATER RESOURCES
SALEM, OREGON