


COMPUTATION SHEET

Application No. 63926
Permit No. 48698

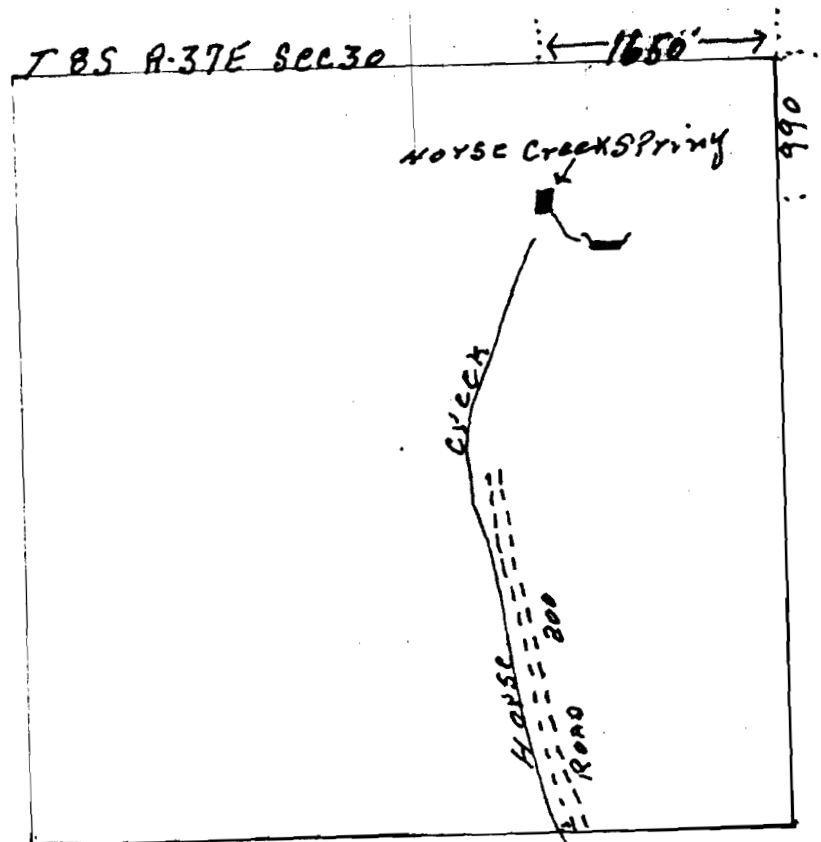

RECEIVED

AUG 23 1982

WATER RESOURCES DEPT.
SALEM, OREGON

RECEIVED

APR 29 1983

WATER RESOURCES DEPT.
SALEM, OREGON

RECEIVED

MAR 25 1983

WATER RESOURCES DEPT.
SALEM, OREGON