


COMPUTATION SHEET

Application No. 63928
Permit No. 48700

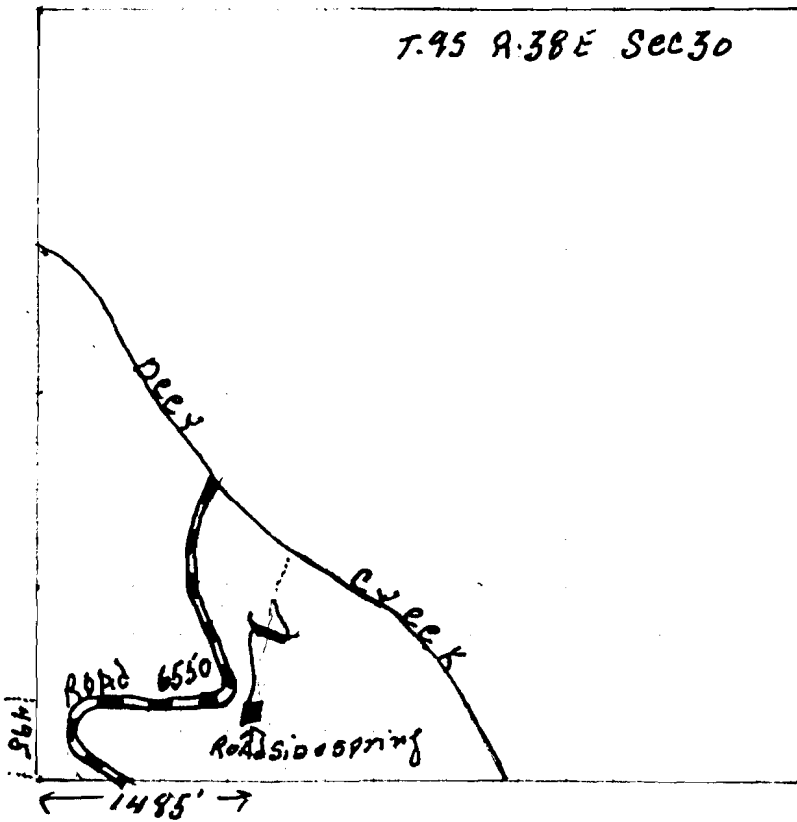

N
4" = 1 mile

RECEIVED

AUG 23 1982

WATER RESOURCES DEPT.
SALEM, OREGON

RECEIVED

MAR 25 1983

WATER RESOURCES DEPT.
SALEM, OREGON