


CONVEYANCE SHEET

Application No. 63930
Permit No. 48702

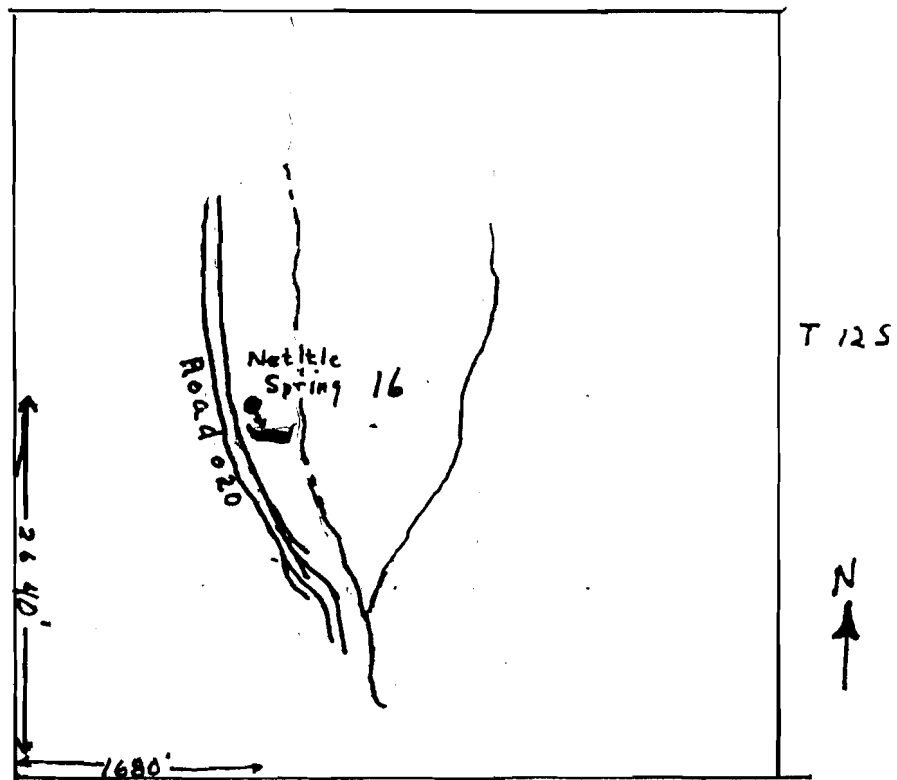

R 40 E Sec. 16

4" = 1 mile

RECEIVED

APR 29 1983

**WATER RESOURCES DEPT.
SALEM, OREGON**