


COMPUTATION SHEET

Application No. 63931
Permit No. 48703

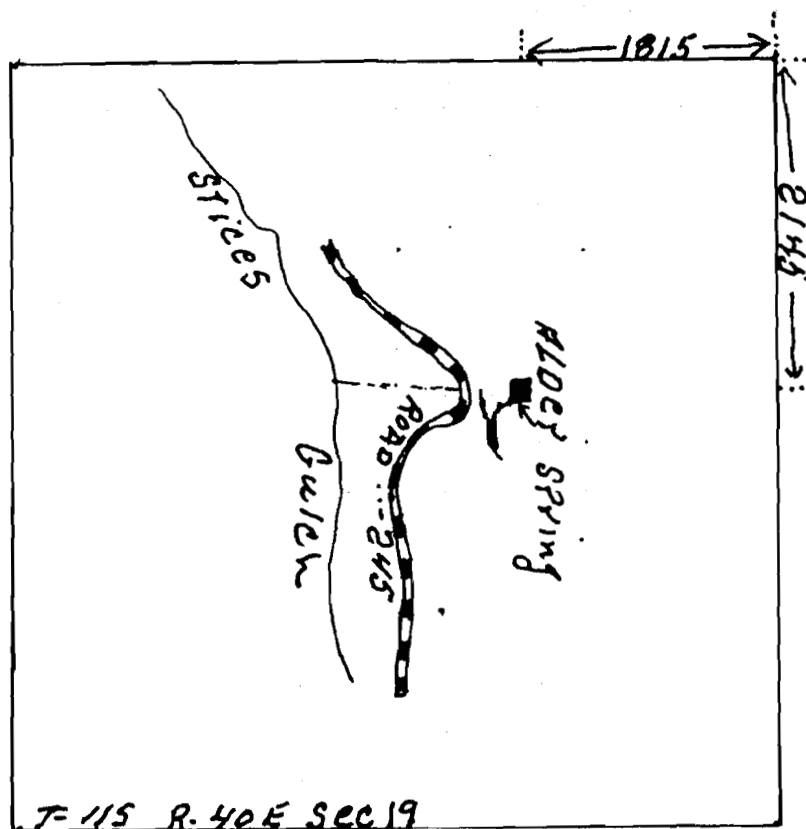

N

4" = 1 mi/b

RECEIVED

MAR 25 1983
WATER RESOURCES DEPT.
SALEM, OREGON

RECEIVED

AUG 23 1982
WATER RESOURCES DEPT.
SALEM, OREGON