


Application No. 63932
Permit No. 48704

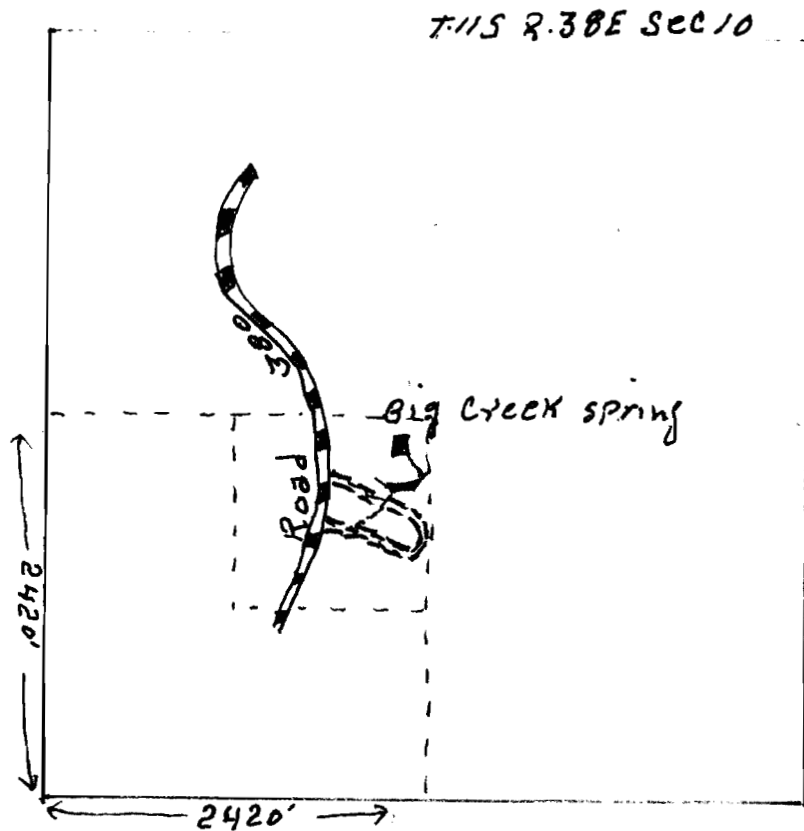

RECEIVED

APR 29 1983

WATER RESOURCES DEPT.
SALEM, OREGON

RECEIVED

MAR 25 1983

WATER RESOURCES DEPT.
SALEM, OREGON

RECEIVED

AUG 23 1982

WATER RESOURCES DEPT.
SALEM, OREGON