


Application No. 63934
Permit No. 48706

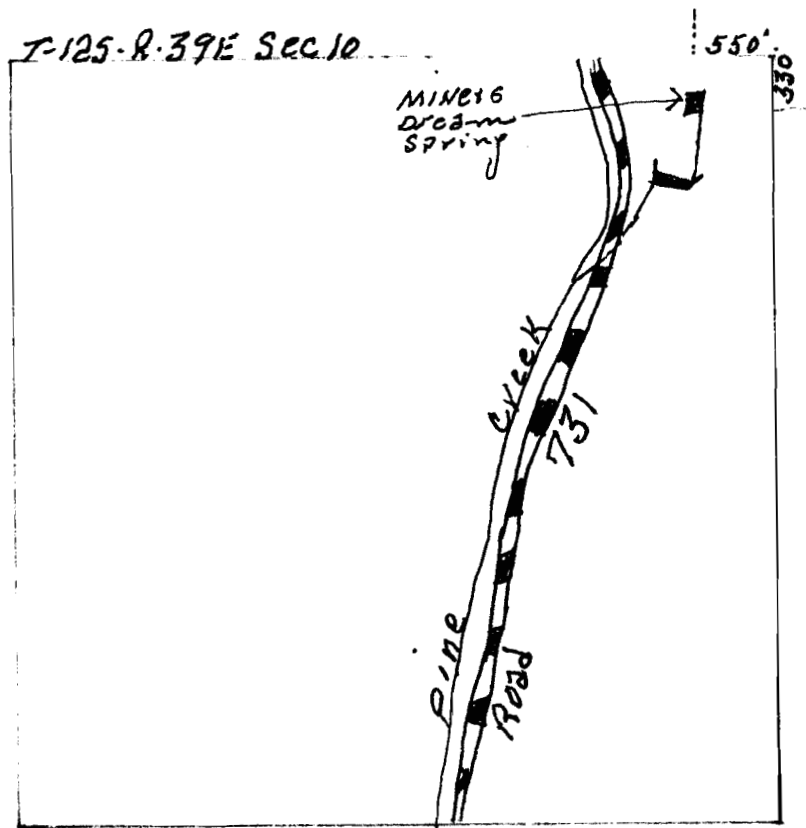

↑
4" = 1 mile

RECEIVED

AUG 23 1982

RECEIVED WATER RESOURCES DEPT.
SALEM, OREGON

MAR 25 1983

WATER RESOURCES DEPT.
SALEM, OREGON