


COMPUTATION SHEET

Application No. 64482
Permit No. 48707

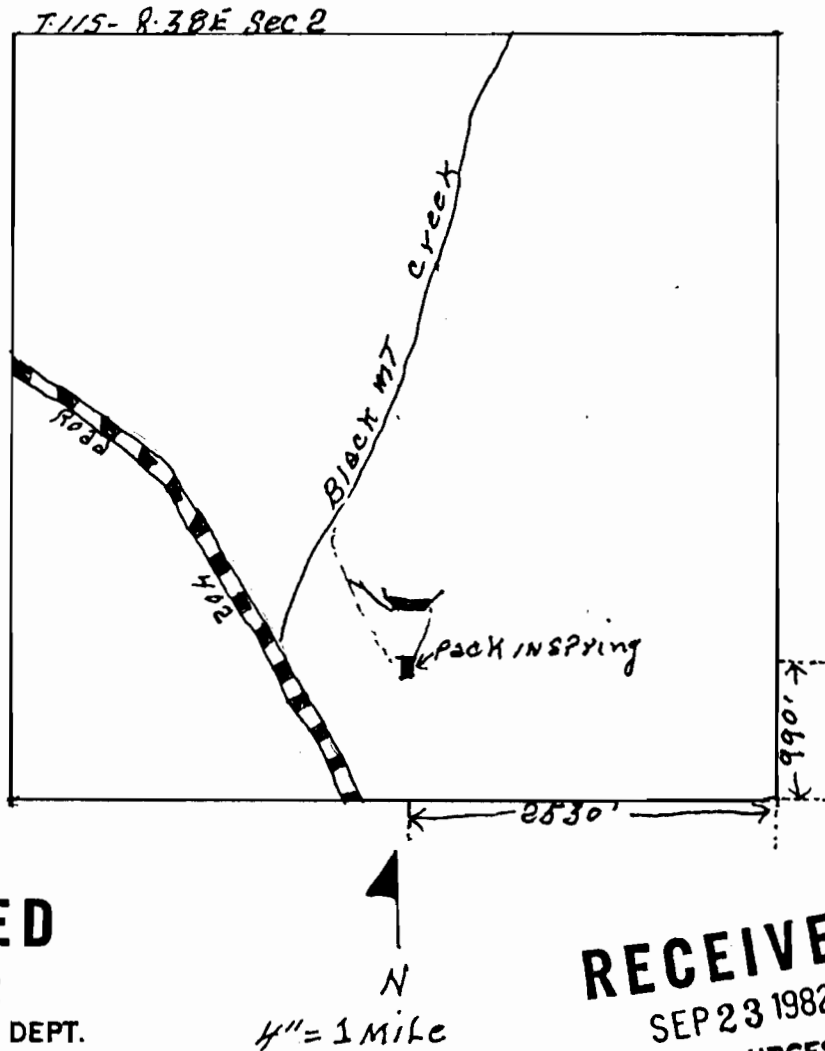

RECEIVED
OCT 20 1982
WATER RESOURCES DEPT.
SALEM, OREGON

RECEIVED
SEP 23 1982
WATER RESOURCES DEPT.
SALEM, OREGON