


T. 9 S., R. 38 E., W.M. RECEIVED


AUG 25 1983

WATER RESOURCES DEPT.
SALEM, OREGON

SECTION 18

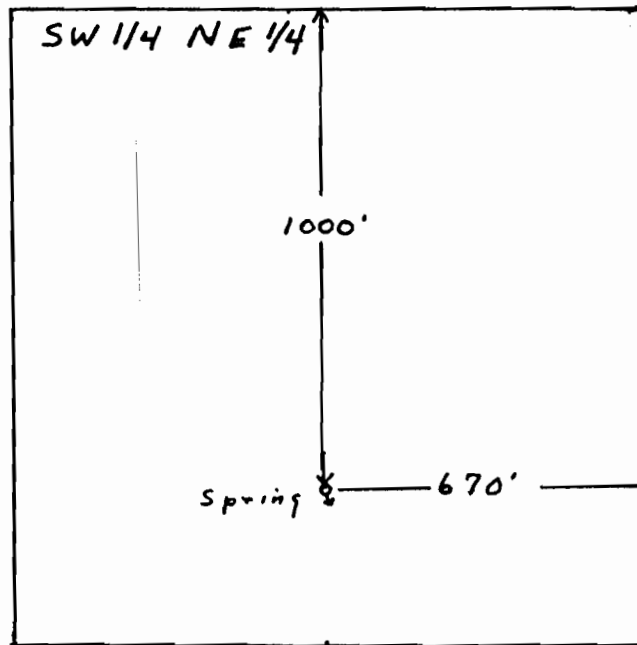

SCALE 1" = 400'

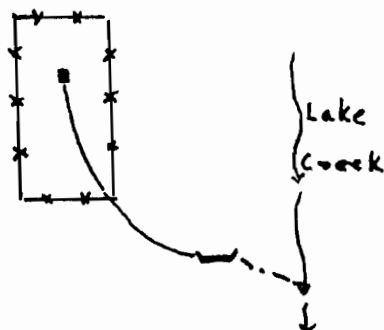

<u>Water</u>	<u>Development</u>
■	Spring Box
xx	Protection Fence
—	Pipe 1 1/2"
- - -	Overflow Pipe
~~~~~	Water trough

Scale of Water Development  
Schematic 1" = 100'

Application No. 64487  
Permit No. 48708

Application # 31

DEPARTMENT OF AGRICULTURE  
FOREST SERVICE  
FIELD MAP SHEET

Scale _____ inches = 1 mile.

T. 9S R. 38E Sec. 18

Mag. Dec. _____ Acres _____

(Case designation)

Unit _____

Application No. 64487  
Permit No. 48708

RECEIVED


OCT 20 1982

WATER RESOURCES DEPT.  
SALEM, OREGON

RECEIVED

AUG 25 1983

WATER RESOURCES DEPT.  
SALEM, OREGON

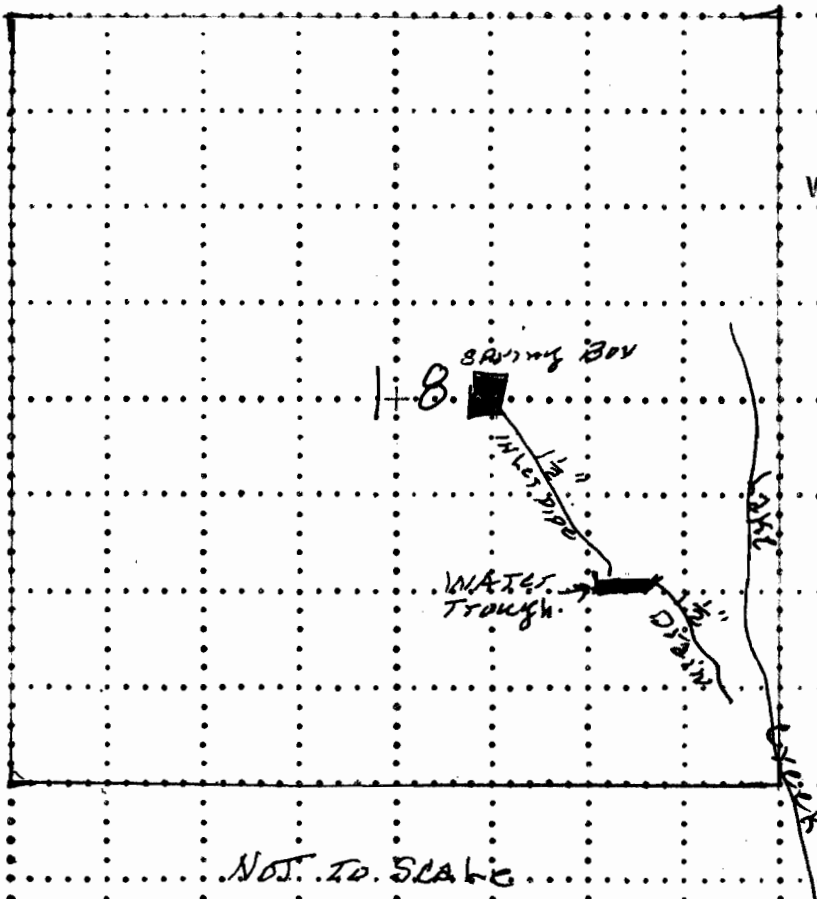

Field work by _____ Date _____ Platted by _____

Remarks _____

Approved _____ 19 _____