


T. 9 S., R. 38 E., W.M.

SECTION 20

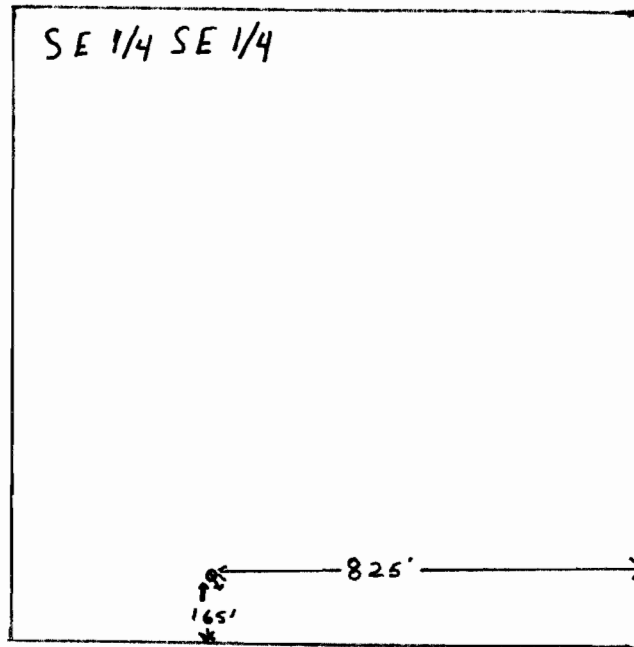


RECEIVED

AUG 25 1983

WATER RESOURCES DEPT.
SALEM, OREGON

SCALE 1" = 400'

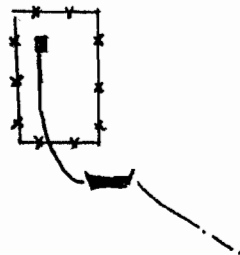

Water Development

Bull Spring

- Spring Box
- ++ Protection Fence
- 1 1/2" Water Transport Pipe
- - - Drain Pipe
- └ Water Trough

Scale of Drawing

1" = 100 ft.

Application No. 64489

Permit No. 48710

Application # 83

DEPARTMENT OF AGRICULTURE
FOREST SERVICE
FIELD MAP SHEET

Scale inches = 1 mile.

T. 9S R. 38E Sec. 20

Mag. Dec. Acres

Unit

(Case designation)

Application No. 64489
Permit No. 48710

RECEIVED


OCT 20 1982

WATER RESOURCES DEPT.
SALEM, OREGON.

RECEIVED

AUG 25 1983

WATER RESOURCES DEPT.
SALEM, OREGON

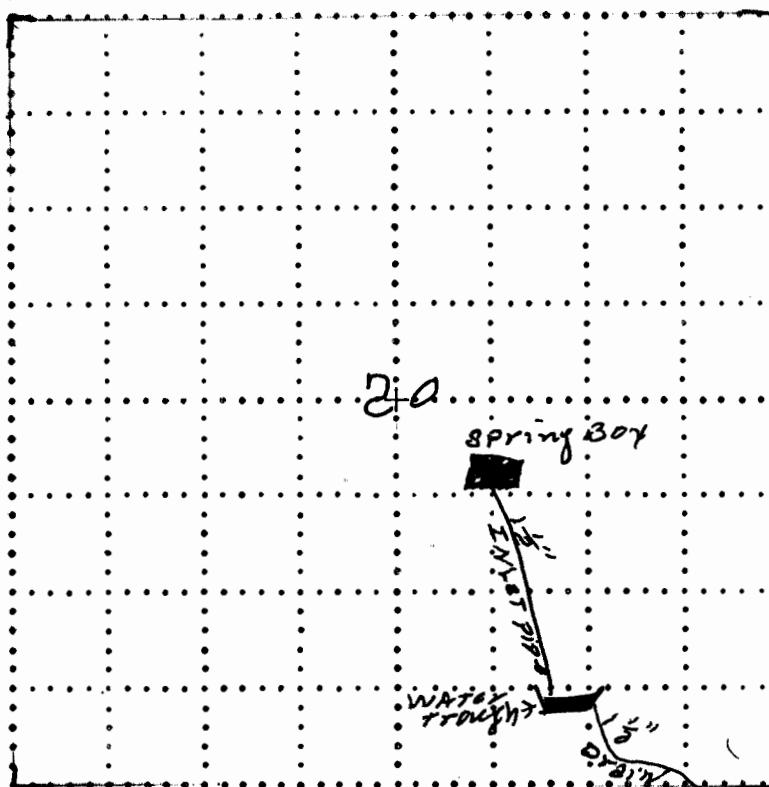

NOT TO SCALE

Field work by Date Platted by

Remarks

Approved 19

10-18 (11/83)

GRO 889999

Approving Officer.

Application # 33

DEPARTMENT OF AGRICULTURE
FOREST SERVICE
FIELD MAP SHEET

Scale 4 inches = 1 mile.

T. 9S R. 38E Sec. 20

Mag. Dec. Acres

(Case designation)

Unit

Application No. 64189
Permit No. 48710

RECEIVED

AUG 25 1983

WATER RESOURCES DEPT.
SALEM, OREGON

2+0

Road 150

Road 250

Spring

1-825

RECEIVED

OCT 20 1982

WATER RESOURCES DEPT.
SALEM, OREGON

RECEIVED

SEP 23 1982

WATER RESOURCES DEPT.
SALEM, OREGON

Field work by Date Platted by

Remarks

Approved 19