


T. 9 S., R. 38 E., W.M.

SECTION 16


RECEIVED

AUG 25 1983

WATER RESOURCES DEPT.
SALEM, OREGON

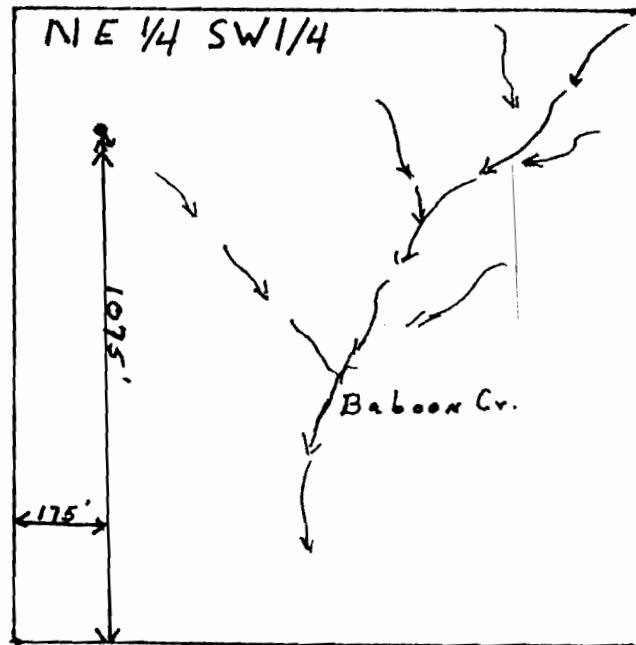

SCALE 1" = 400'

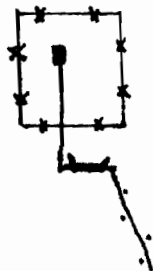

Water Development

Lime Quarry Springs

- Spring Box
- ✕✕ Protection Fence
- Water Transport Pipe
1 1/2"
- Drain Pipe
- Stock Tank

Application No. 64490

Permit No. 48711

APPLICATION # 34

DEPARTMENT OF AGRICULTURE
FOREST SERVICE
FIELD MAP SHEET

Scale _____ inches=1 mile.

T. 9.5 R. 38.5 Sec. 16

Mag. Dec. _____ Acres _____

Unit _____

(Case designation)

Application No. 64490
Permit No. 48711

RECEIVED


OCT 20 1982

WATER RESOURCES DEPT.
SALEM, OREGON

RECEIVED

AUG 25 1983

WATER RESOURCES DEPT.
SALEM, OREGON

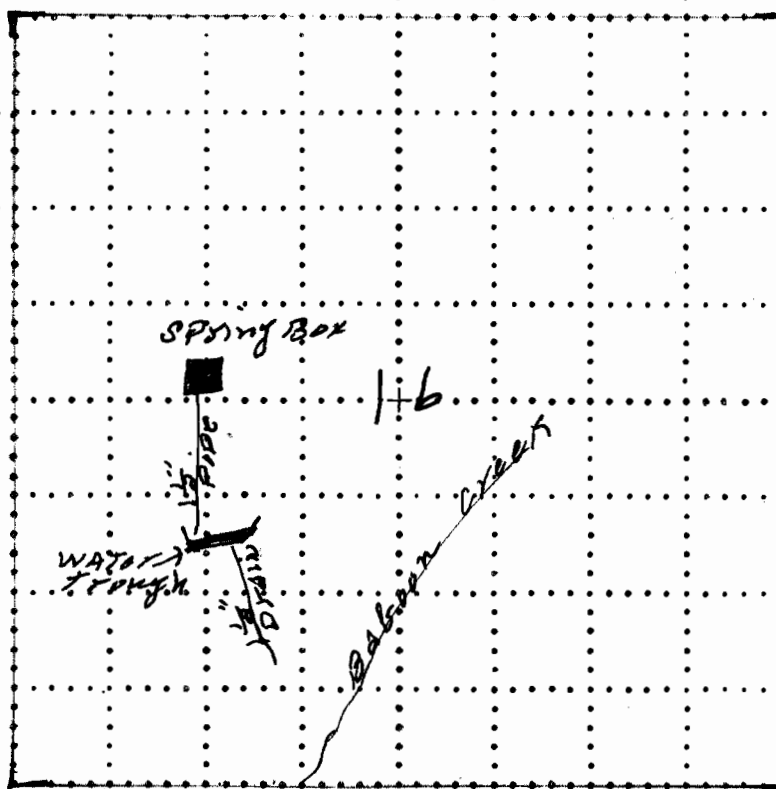

NOT TO SCALE

Field work by _____ Date _____ Platted by _____

Remarks _____

Approved _____, 19____

10-19 (10/59)

GPO 899999

Approving Officer.

application 34

DEPARTMENT OF AGRICULTURE
FOREST SERVICE
FIELD MAP SHEET

Scale 4 inches = 1 mile.
T. 9S R. 38E Sec. 16
Mag. Dec. Acres 110 AC

(Case designation)

Unit Stovepipe allotment


Application No. 64490
Permit No. 48711

T. 9S R. 38E Sec. 16

RECEIVED

AUG 25 1983

WATER RESOURCES DEPT.
SALEM, OREGON

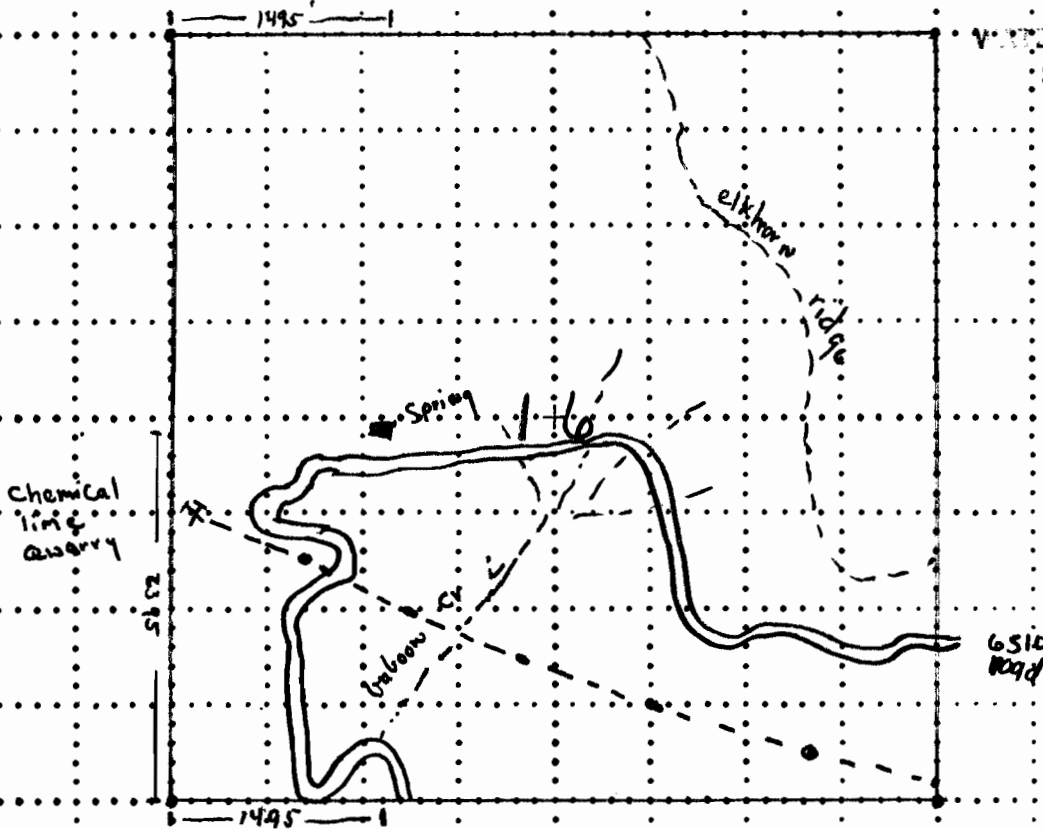

RECEIVED

OCT 20 1982

WATER RESOURCES DEPT.
SALEM, OREGON

RECEIVED

SEP 23 1982

WATER RESOURCES DEPT.
SALEM, OREGON

Field work by _____ Date _____ Platted by _____

Remarks _____

Approved _____, 19 _____