


T. 9 S., R. 38 E., W.M.


SECTION 20

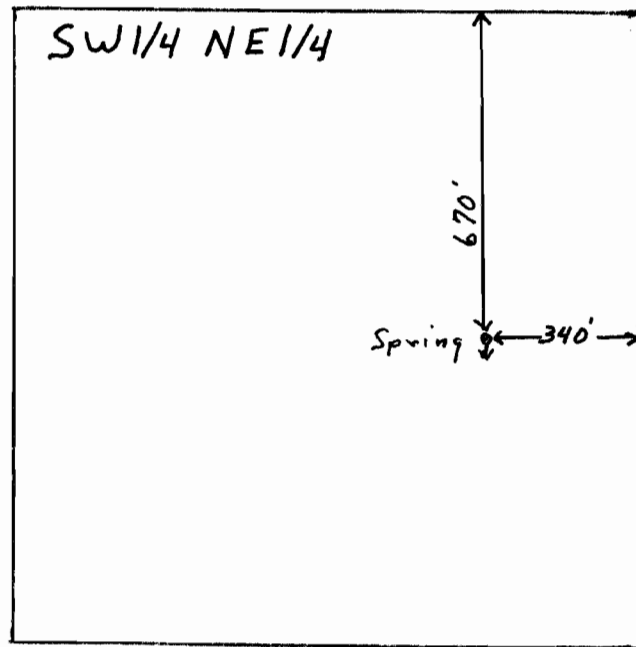

RECEIVED

AUG 25 1983
WATER RESOURCES DEPT.
SALEM, OREGON

SCALE 1" = 400'

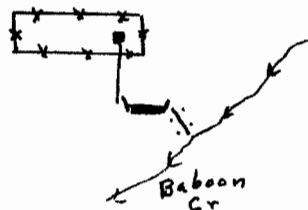

Water Development

Baboon Springs

- Spring Box
- Intake Pipe 1 1/2"
- - - Overflow Pipe
- U Stock Tank
- x - Protection Fence

Scale
1" = 100'

Application No. 64492
Permit No. 48712