

application # 38

DEPARTMENT OF AGRICULTURE
FOREST SERVICE
FIELD MAP SHEET

Scale 4 inches = 1 mile.


T. 9S R. 38E Sec. 30

Mag. Dec. Acres 410 AC

(Case designation)

Unit

Application No. 64493
Permit No. 48713

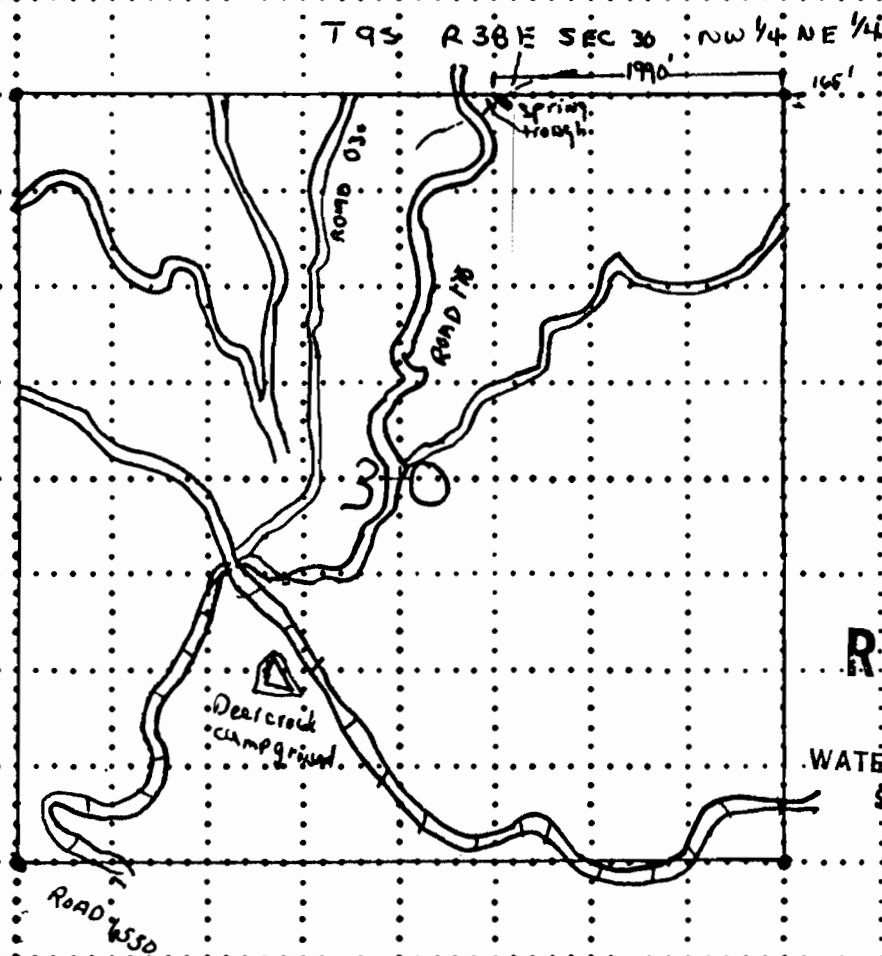

RECEIVED

OCT 20 1982

WATER RESOURCES DEPT.
SALEM, OREGON

RECEIVED

SEP 23 1982

WATER RESOURCES DEPT.
SALEM, OREGON

Field work by Date Platted by

Remarks

Approved 19