

RECEIVED

AUG 25 1983

WATER RESOURCES DEPT.
SALEM, OREGON


RECEIVED

JAN - 1 1988

WATER RESOURCES DEPT.
SALEM, OREGON

T. 9 S., R. 38 E., W.M.

SECTION 18

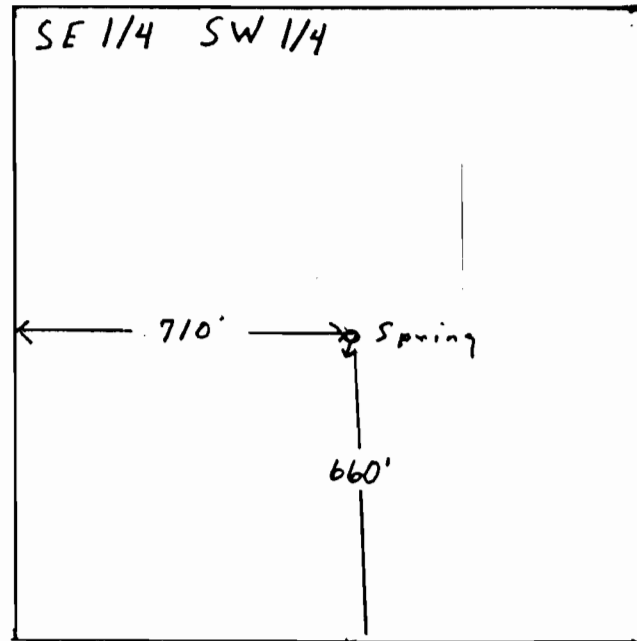

SCALE 1" = 400'



Water Development

- Spring Box
- ++ Protection Fence
- Stock Tank
- Water Intake Pipe
- Drain Pipe

Scale 1" = 100'

Application No. 64494

Permit No. 48714

Application # 38

DEPARTMENT OF AGRICULTURE
FOREST SERVICE
FIELD MAP SHEET

Scale _____ inches=1 mile.

T. _____ R. _____ Sec. _____

Mag. Dec. _____ Acres _____

(Case designation)

Unit _____

Application No. 4494
Permit No. 48714


RECEIVED

AUG 25 1983

WATER RESOURCES DEPT.
SALEM, OREGON

T-9S R-38E SEC-18

1+8

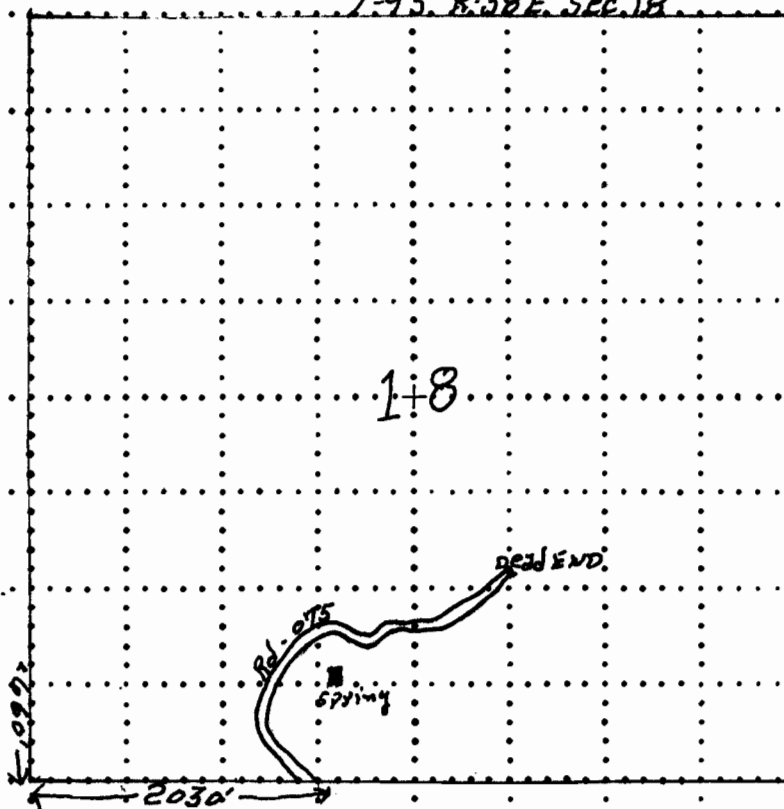

RECEIVED

OCT 20 1982

WATER RESOURCES DEPT.
SALEM, OREGON

RECEIVED

SEP 23 1982

WATER RESOURCES DEPT.
SALEM, OREGON

4" mile

Field work by _____ Date _____ Platted by _____

Remarks _____

Approved _____, 19 _____