


T.10 S., R.37 E., W.M.

SECTION 36

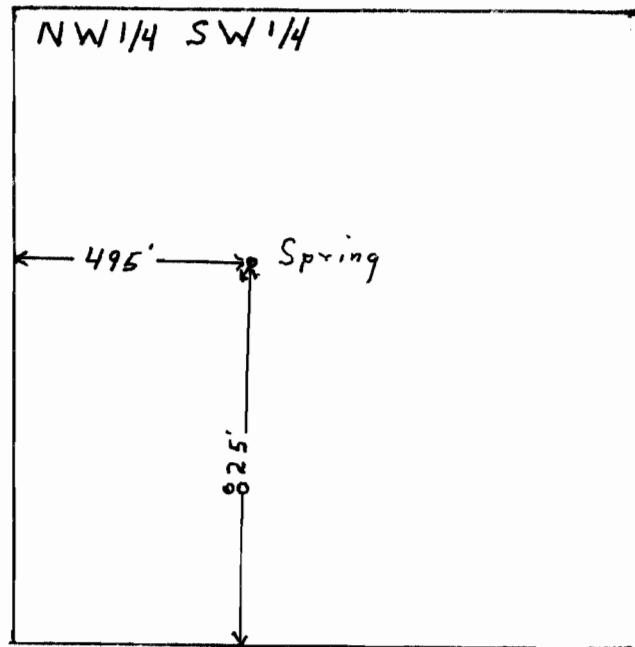

SCALE 1" = 400'



Water Development

- Spring Box
- ⊠ Protection Fence
- ▭ Stock Tank
- Water Transport Pipe
- - - Drain Pipe
- ←← Drainage

Scale
1" = 100'

Application No. 64495
Permit No. 48715

RECEIVED
AUG 25 1983
WATER RESOURCES DEPT.
SALEM, OREGON

Application # 39


DEPARTMENT OF AGRICULTURE
FOREST SERVICE
FIELD MAP SHEET

Scale _____ inches = 1 mile.
T. _____ R. _____ Sec. _____
Mag. Dec. _____ Acres _____

(Case designation) _____ Unit _____

Application No. 184194
Permit No. 48715

T. 10S R. 32E SEC 34

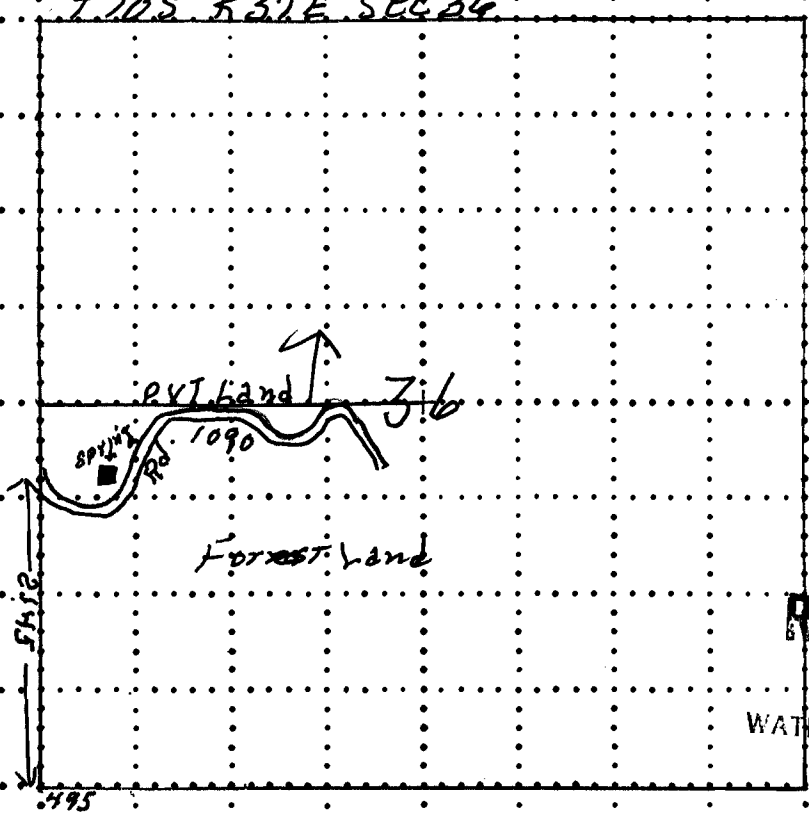

RECEIVED

AUG 25 1983

WATER RESOURCES DEPT.
SALEM, OREGON

RECEIVED

OCT 20 1982

WATER RESOURCES DEPT.
SALEM, OREGON

RECEIVED

SEP 23 1982

WATER RESOURCES DEPT.
SALEM, OREGON

4" mile

Field work by _____ Date _____ Platted by _____

Remarks _____

Approved _____, 19____