

STATE OF OREGON WATER RESOURCES DEPARTMENT
 APPLICATION FOR PERMIT TO APPROPRIATE SURFACE WATER

RECEIVED

NOV 4 1981


APPLICANT: USDA FOREST SERVICE, MT. HOOD NATIONAL FOREST

WATER RESOURCES DEPT
 SALEM, OREGON


Township 3S Range 11E Section 32

Spring Name Raven

Application No. 63018
 Permit No. 48729

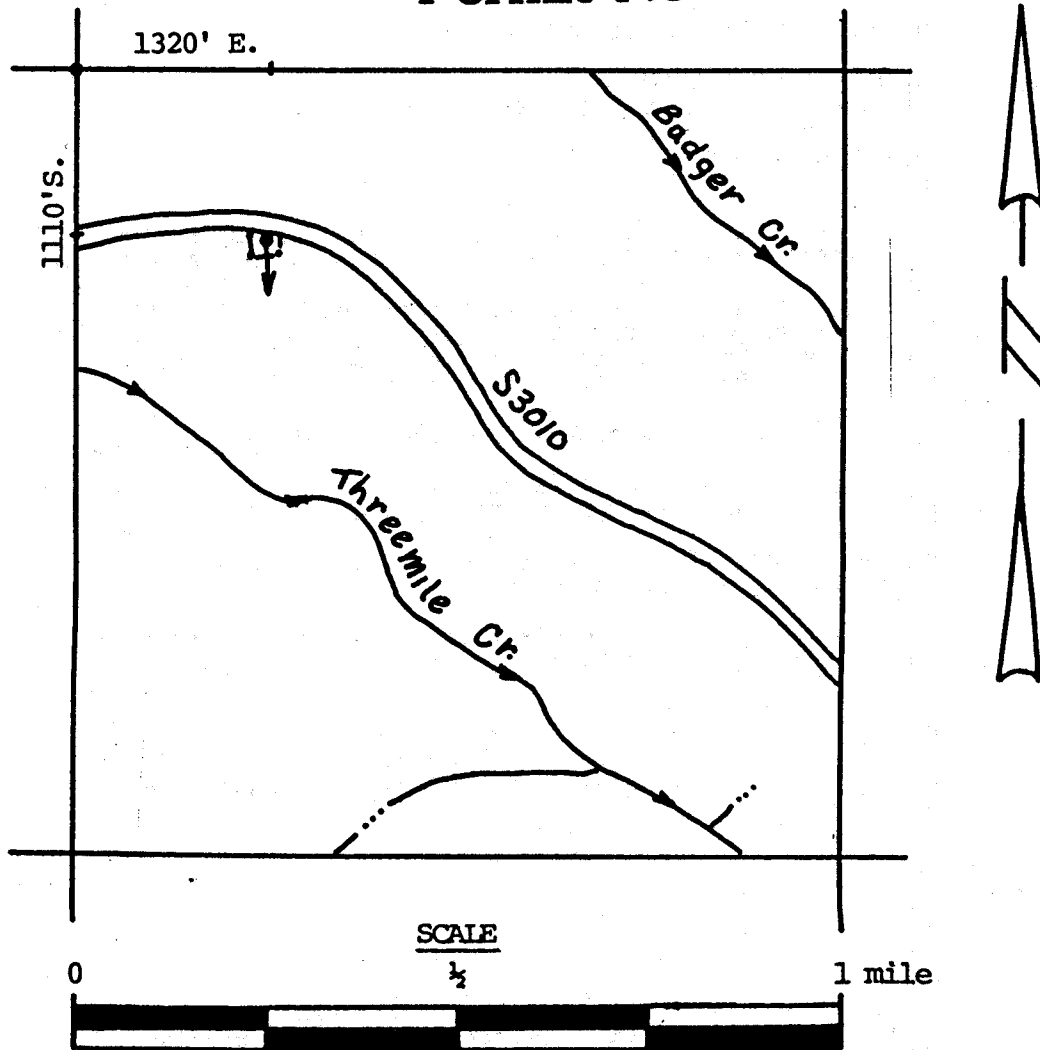

TYPICAL DEVELOPMENT

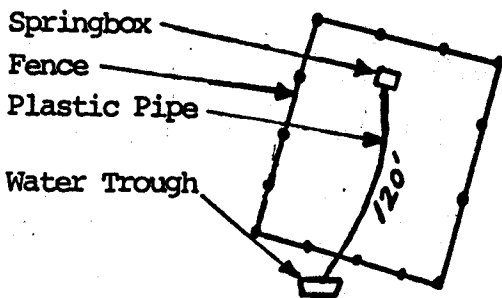

LEGEND

- Int. Stream ... — ...
- Creek ———>>>
- Spring & Direction of Flow ● —>
- Road ———
- Pasture Fence x — x —

Area Enclosed: Approximately 1 acre.