


TOWNSHIP 1s, RANGE 36E, SECTION 24, W.M.

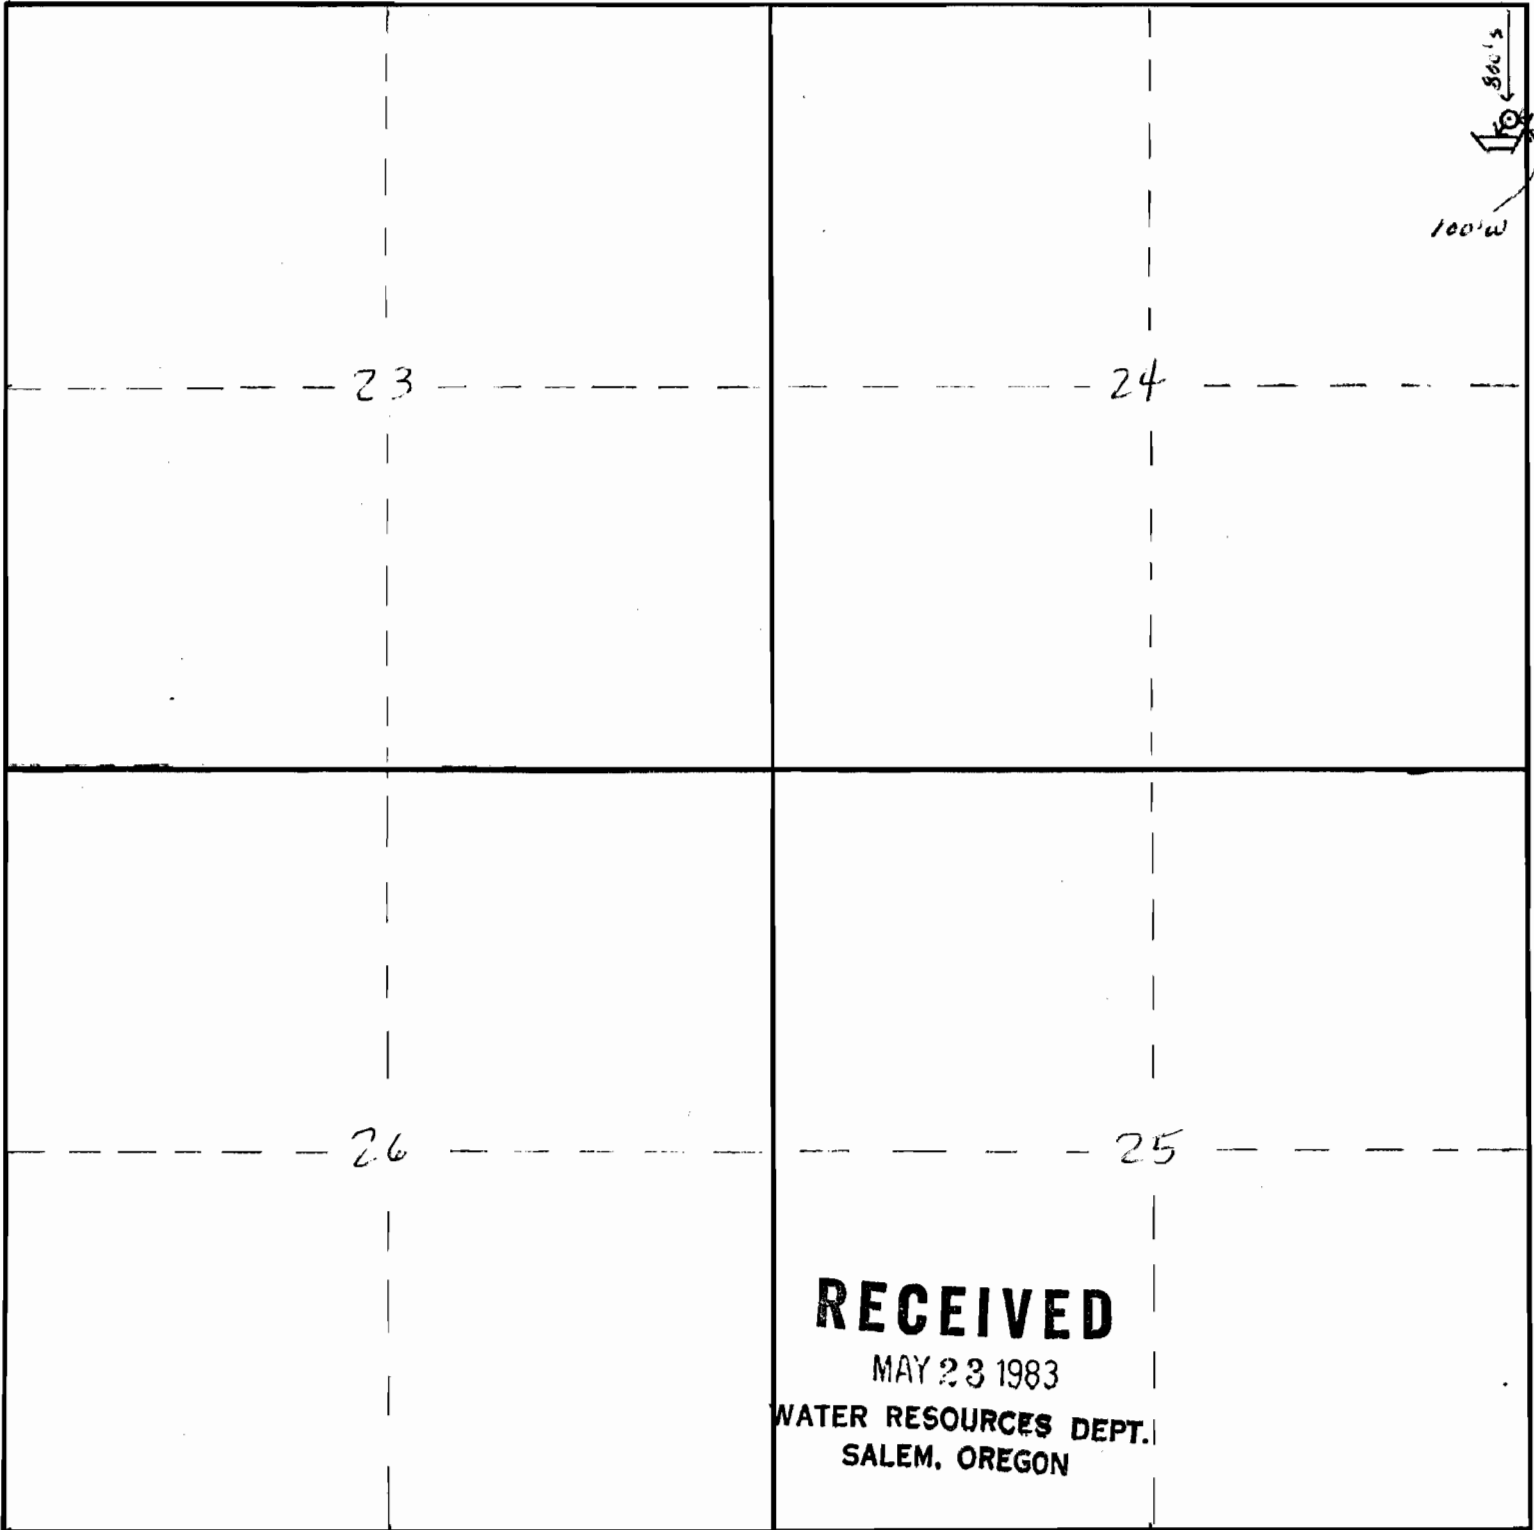

NAME North Flat Spring COUNTY Umatilla

App No 63631
Permit No. **48772**