


TOWNSHIP 1 S, RANGE 36 E, SECTION 27, W.M.

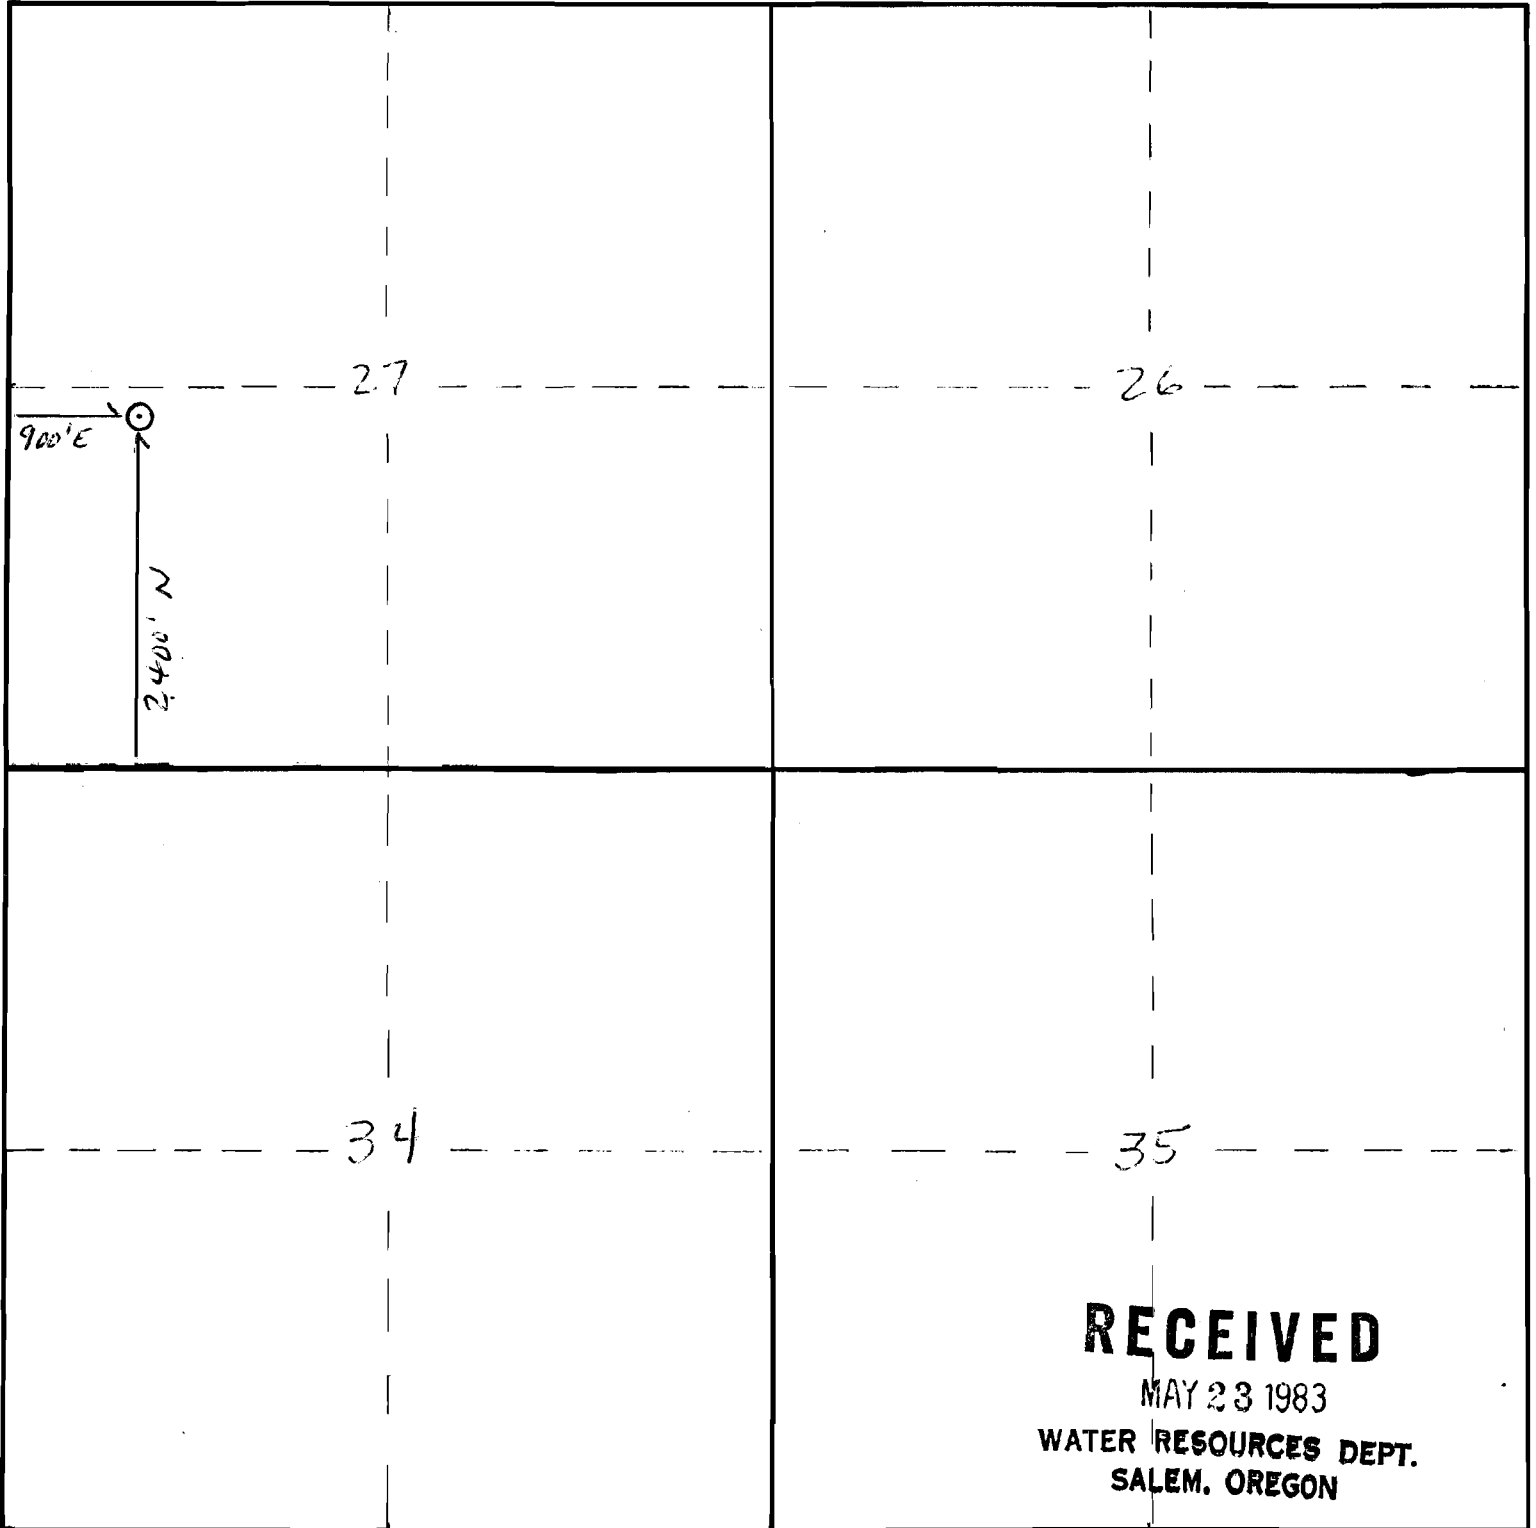

**RECEIVED**  
MAY 23 1983  
WATER RESOURCES DEPT.  
SALEM, OREGON

NAME Wells Spring COUNTY Umatilla

APP. NO. 63633  
198774

**Permit No.**