


TOWNSHIP 5N, RANGE 42E, SECTION 19, W.M.

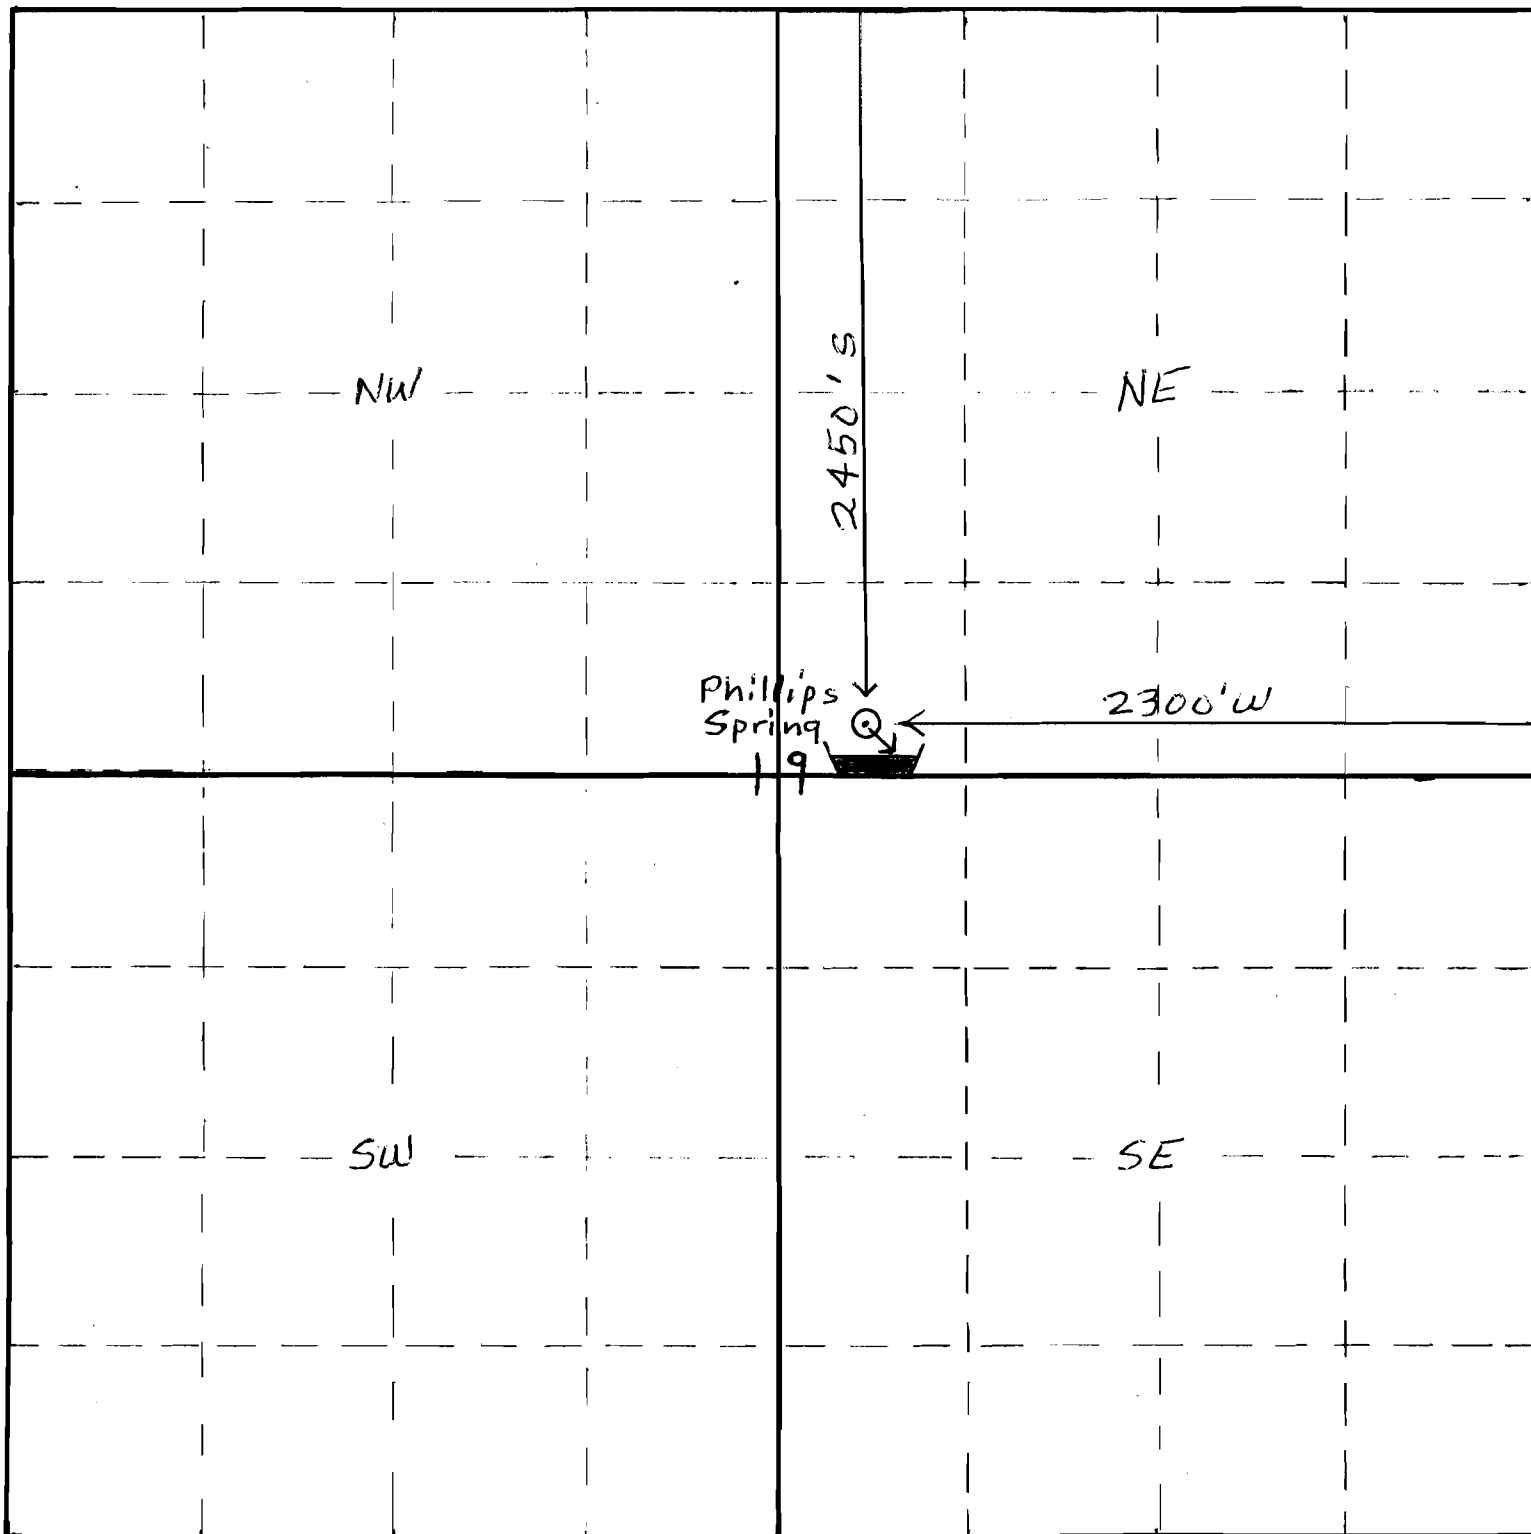

NAME Phillips Spring COUNTY Wallowa
DISTRICT Walla Walla ALLOTMENT Eden C & H

Application No. 63636

Scale 8 Inches = 1 Mile

Permit No. 48777

N