


TOWNSHIP 1 N., RANGE 37 E, SECTION 26, W.M.

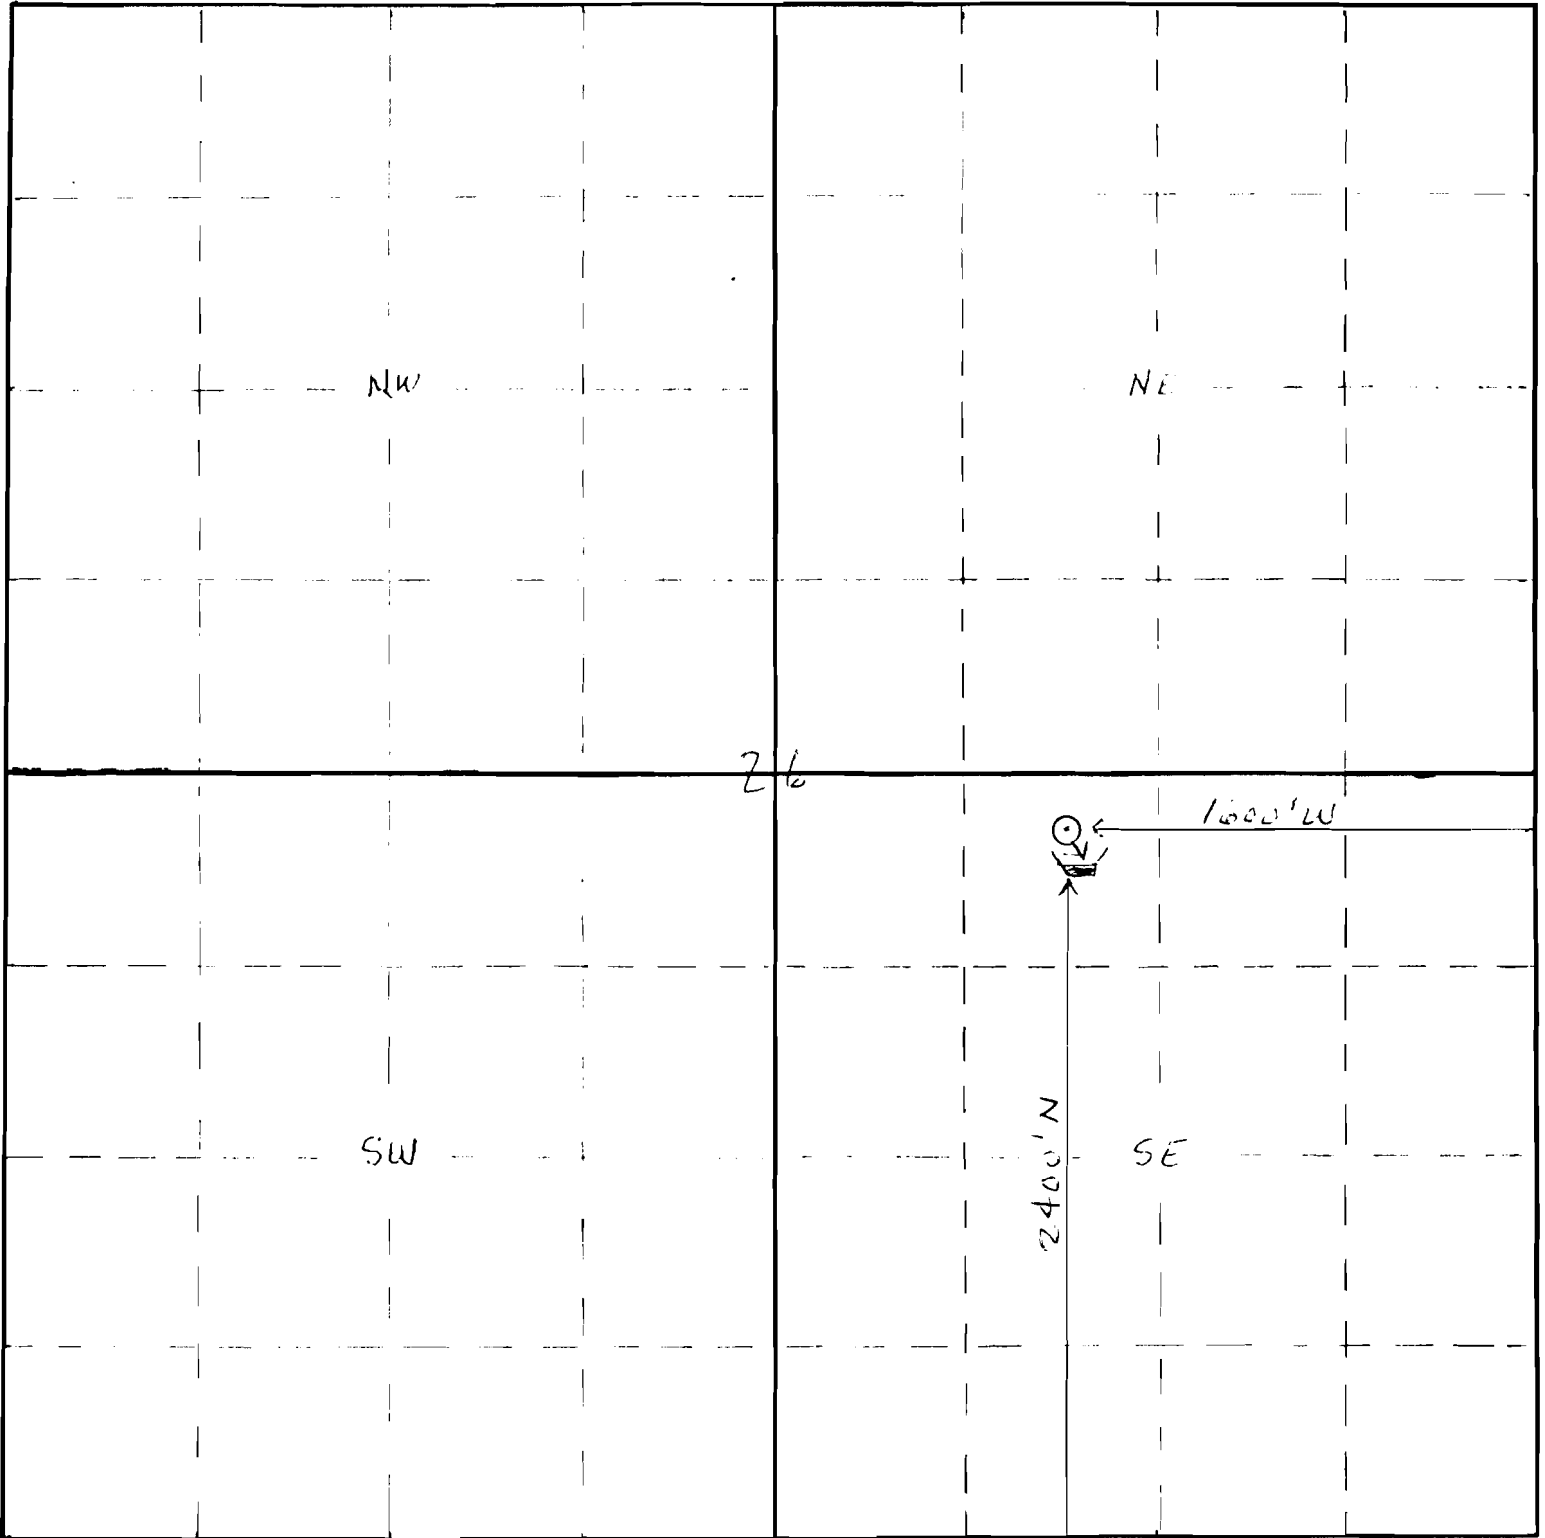

NAME Walla Walla

COUNTY Umatilla

DISTRICT Walla Walla

ALLOTMENT

Application No. 63638 Scale 8 Inches = 1 Mile

Permit No. 48779

