


TOWNSHIP 1N, RANGE 36E, SECTION 28, W.M.

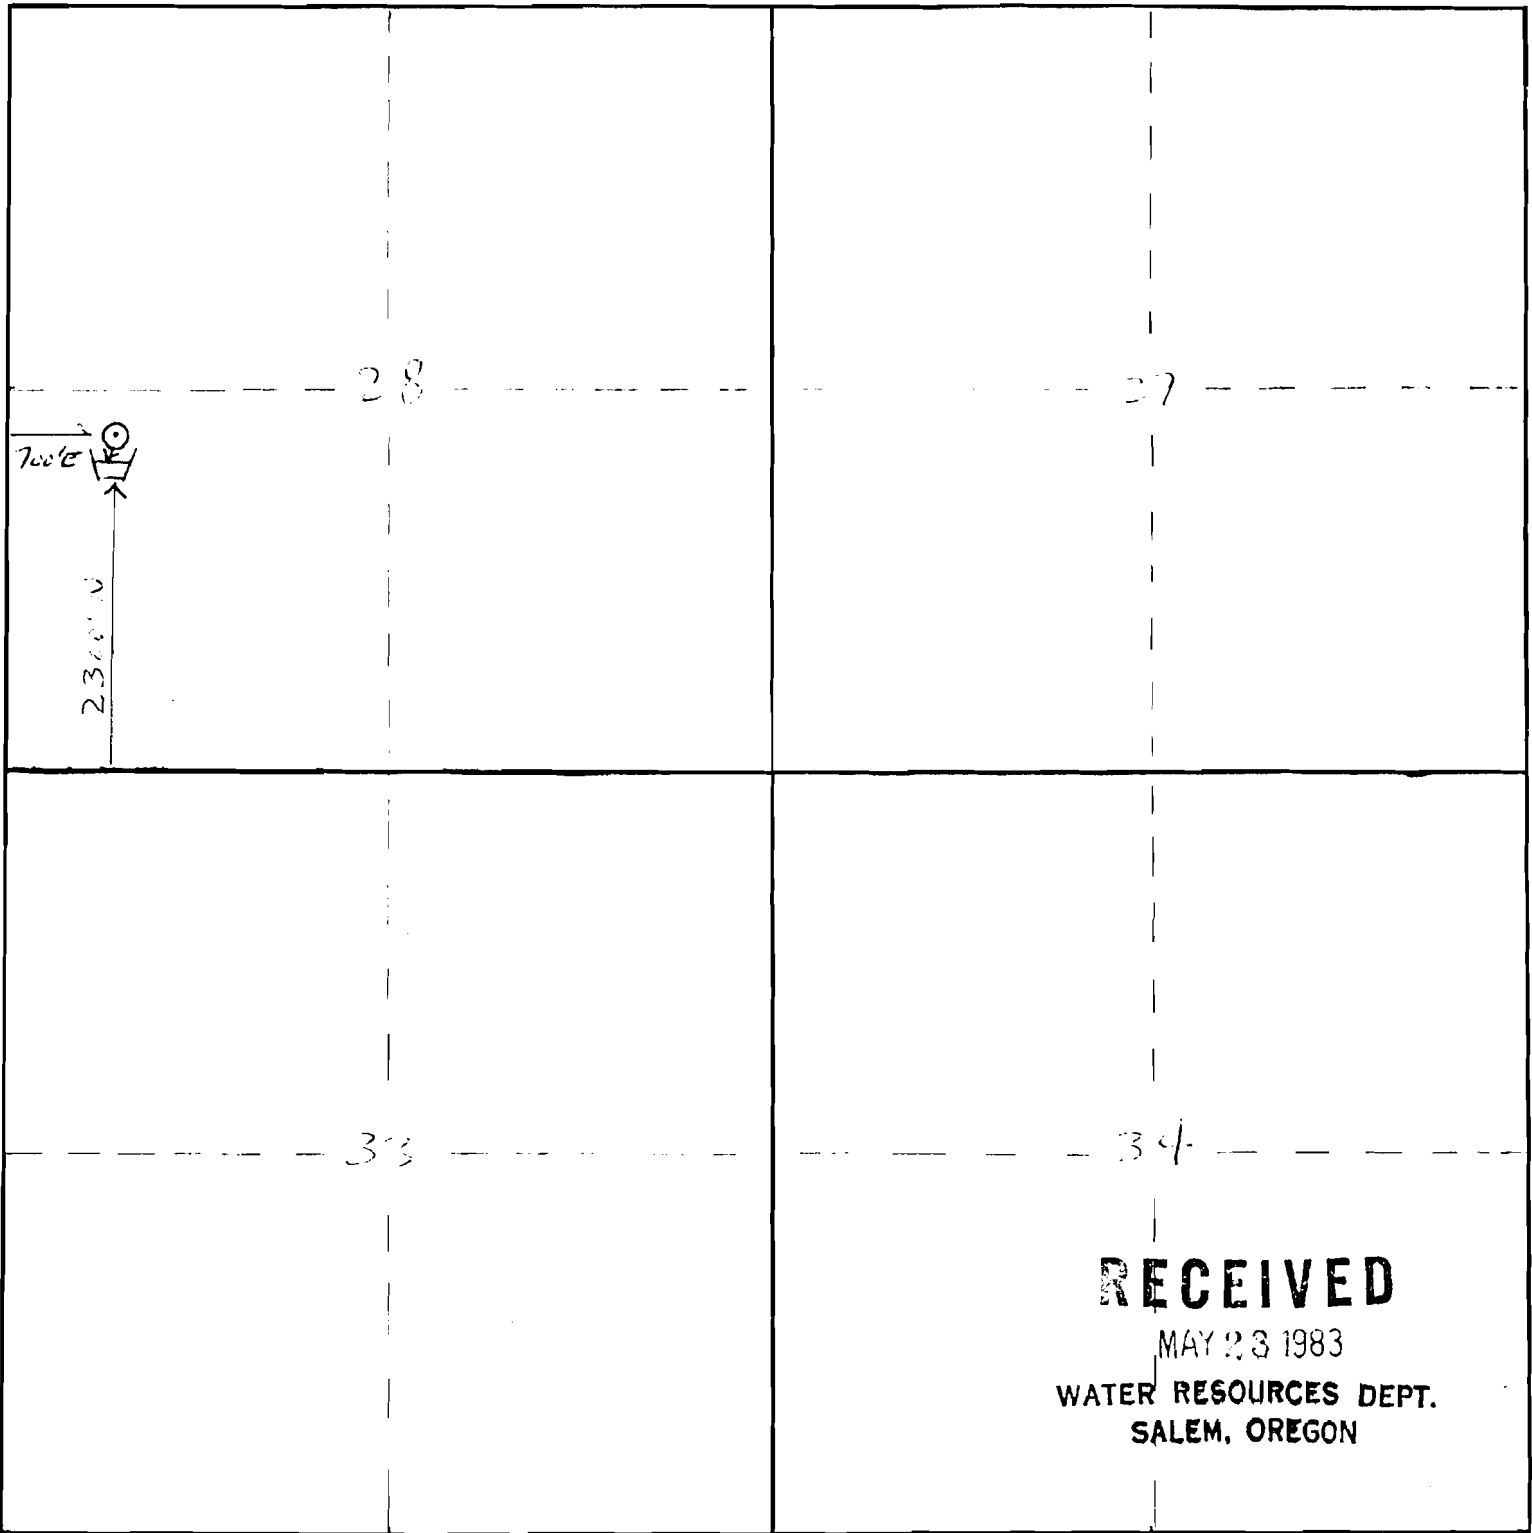

NAME Horseshoe Spring COUNTY Umatilla

Application No. 63639

Permit No. **48780**