


TOWNSHIP 7S, RANGE 25E, SECTION , W.M.

23

24

Application No. 63679
Permit No. 48786

26

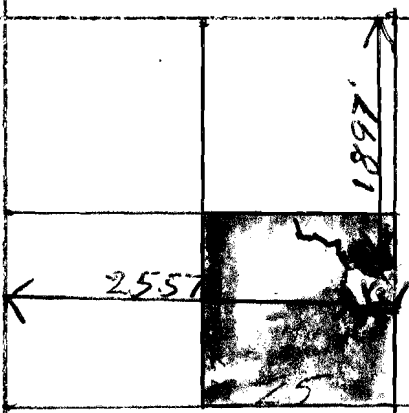

RECEIVED

NAME Kahler Spring

COUNTY Wheeler

DEC 7 1983
WATER RESOURCES DEPT.
SALEM, OREGON