


RECEIVED

SEP 7 1982

**WATER RESOURCES DEPT.
SALEM, OREGON**

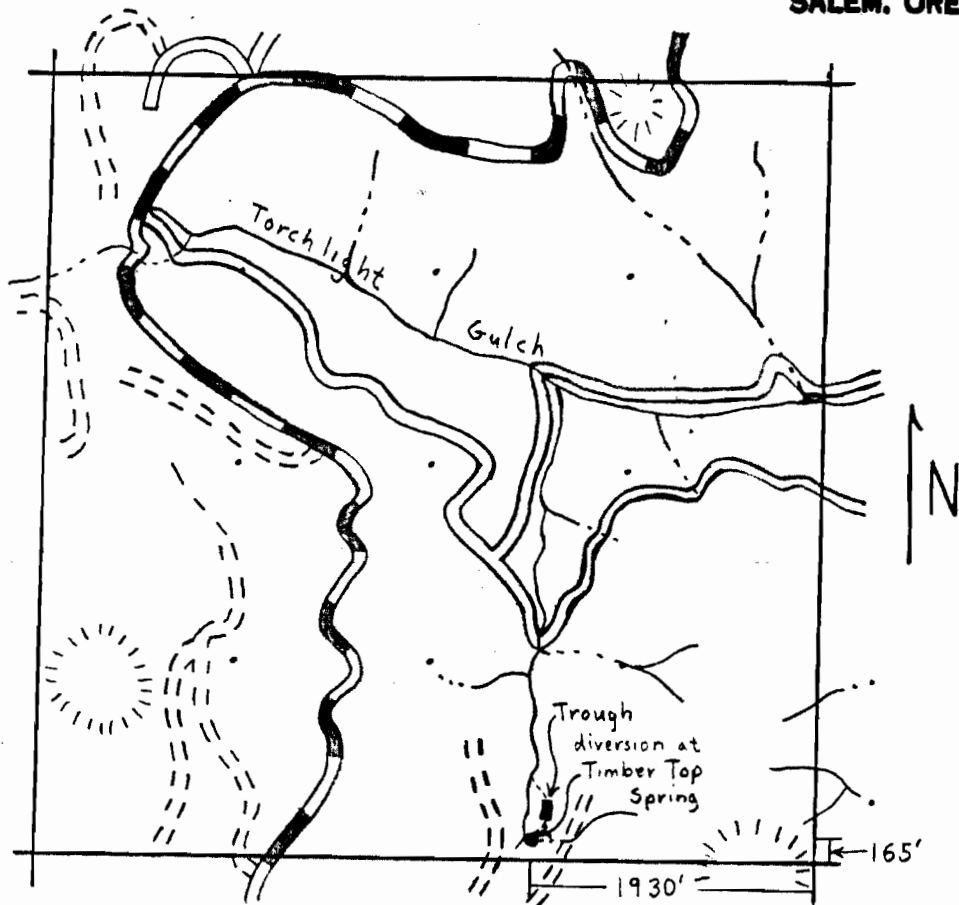

4 inches = 1 mile

T7S R44E Sec18

Application No. 64070

Permit No. 48900