


RECEIVED

SEP 8 1983

WATER RESOURCES DEPT.
SALEM, OREGON

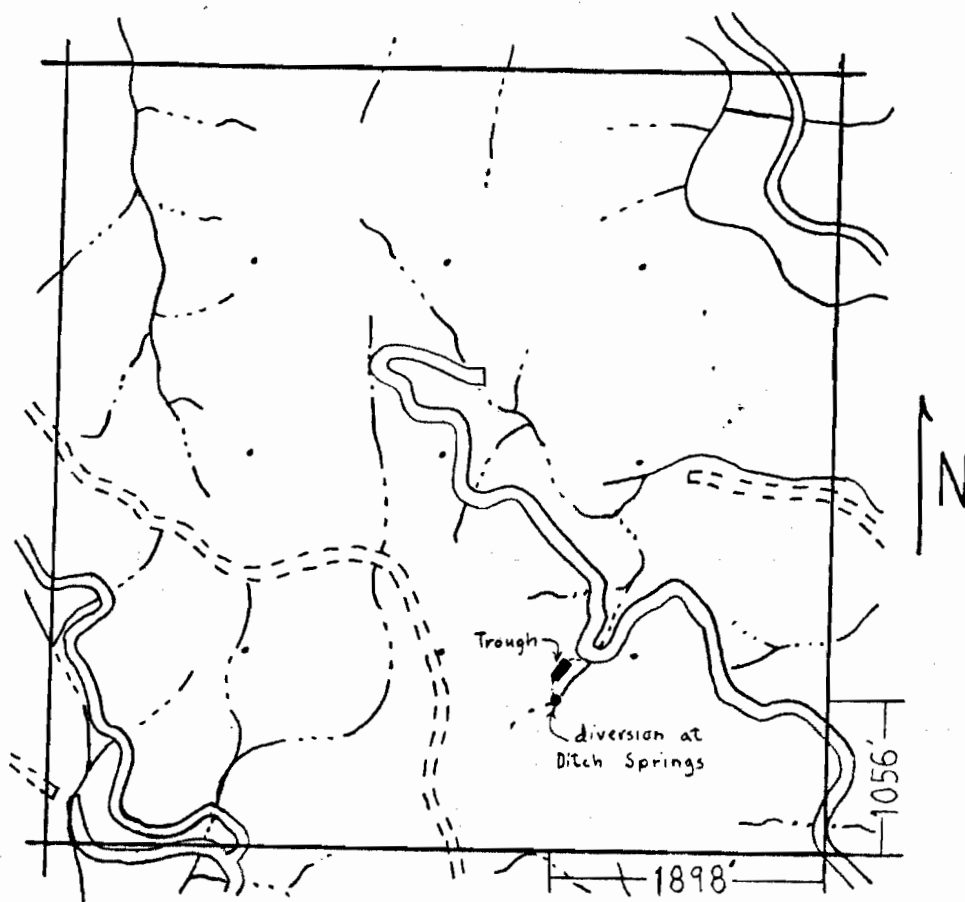

4 inches = 1 mile

T7S R43E Sec 1

Application No. 64071

Permit No. 48901