


RECEIVED

SEP 8 1983

**WATER RESOURCES DEPT.
SALEM, OREGON**

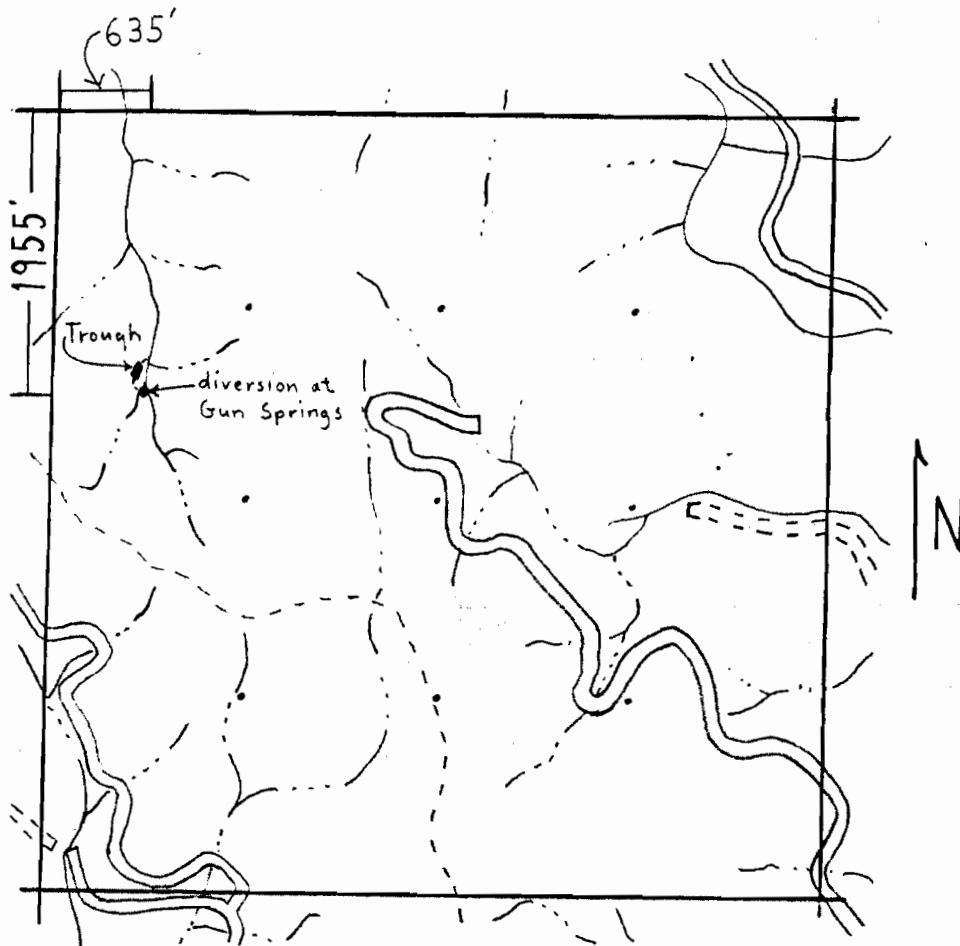

4 inches = 1 mile

T7S R43E Sec1

Application No. 64072

Permit No. 48902