


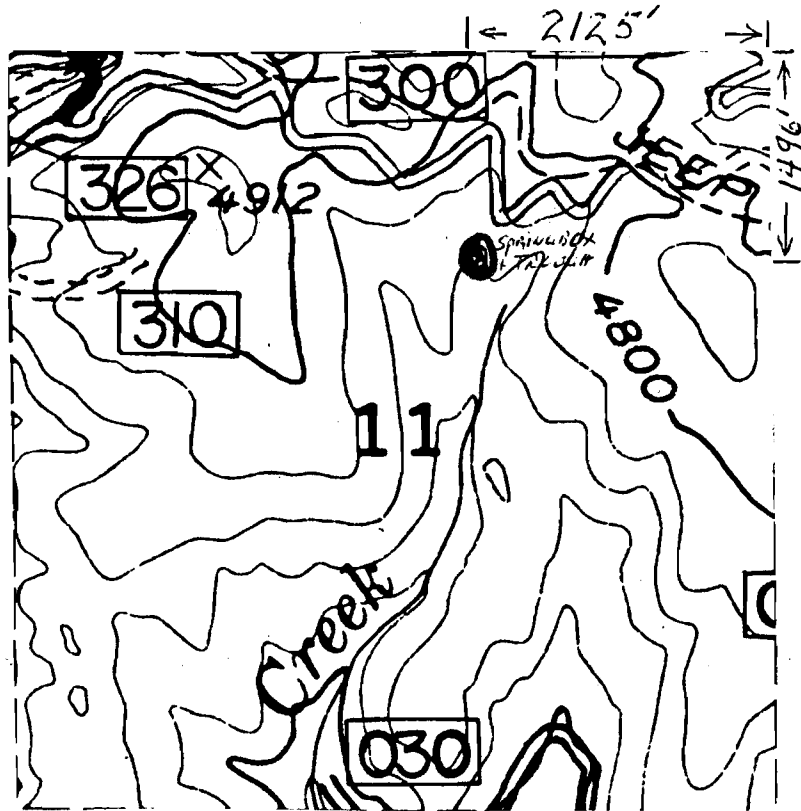

4 inches = 1 mile T.7 S., R. 43 E.

Section 11

RECEIVED
DEC 12 1983
WATER RESOURCES DEPT.
SALEM, OREGON

Application No. 64073
Permit No. 48903