


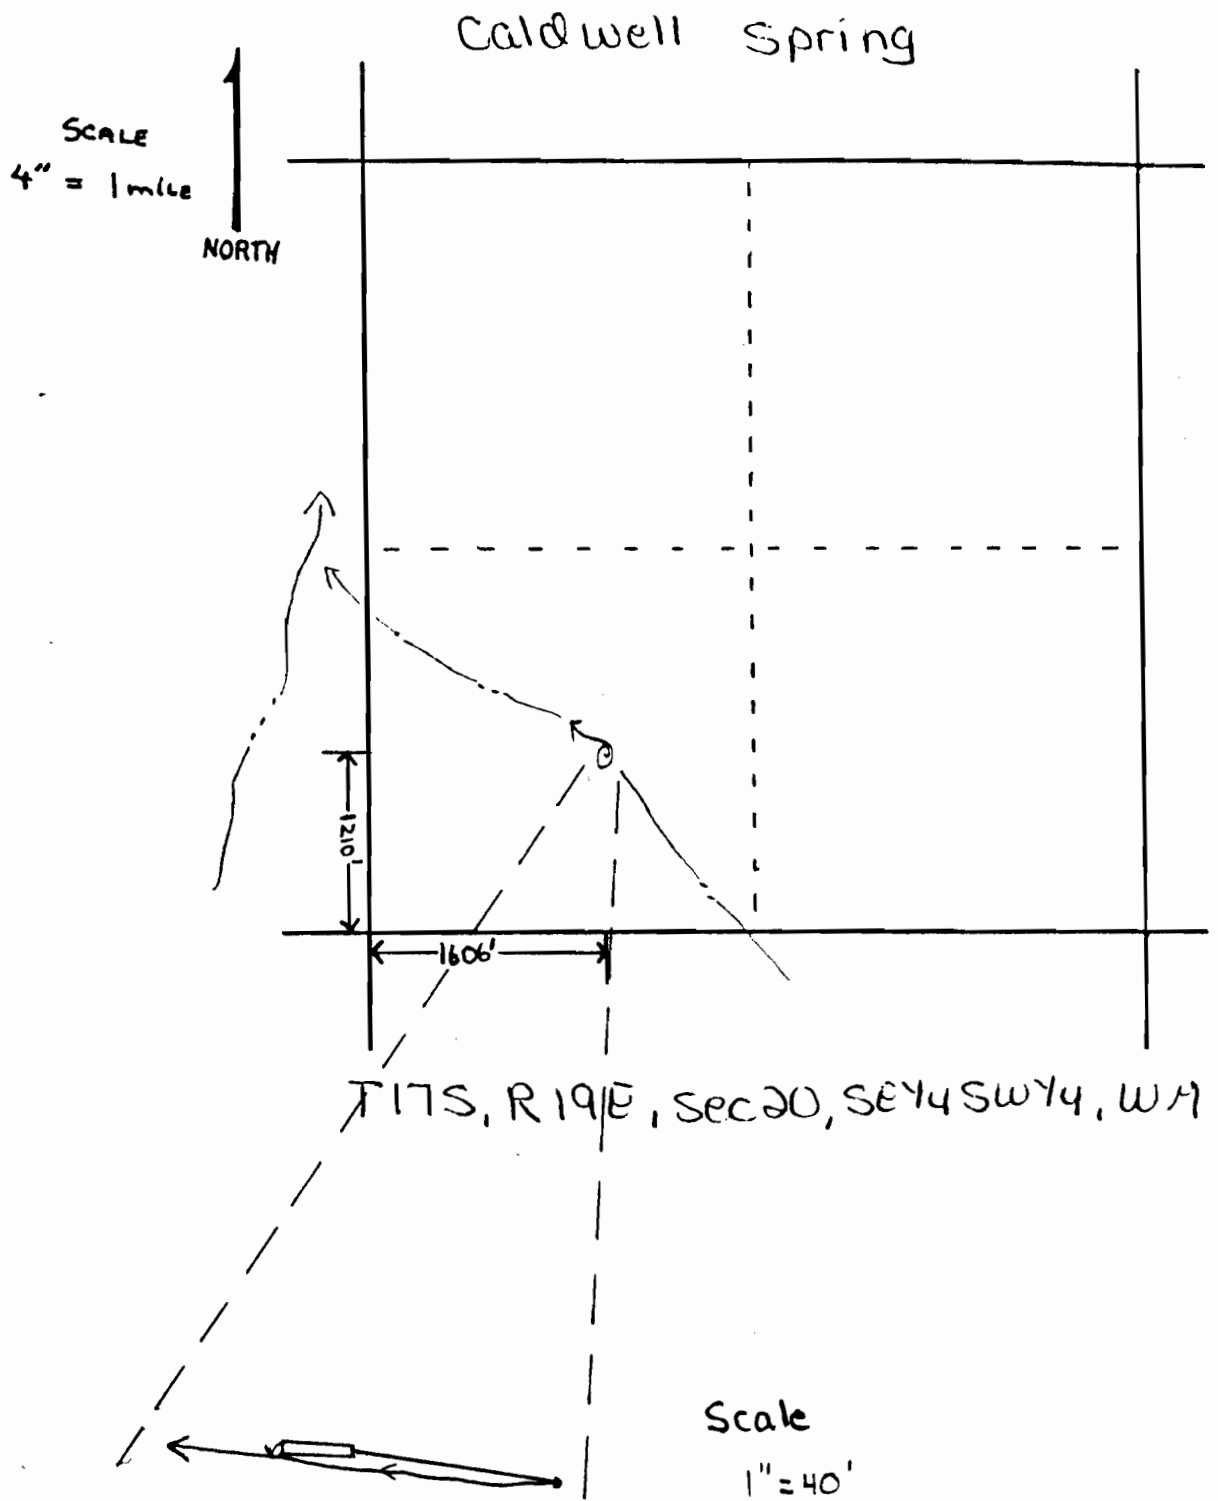

Application No. 68175
Permit No. 48962

RECEIVED
SEP 6 1984
WATER RESOURCES DEPT
SALEM, OREGON