


Application No. 64262
Permit No. 49131

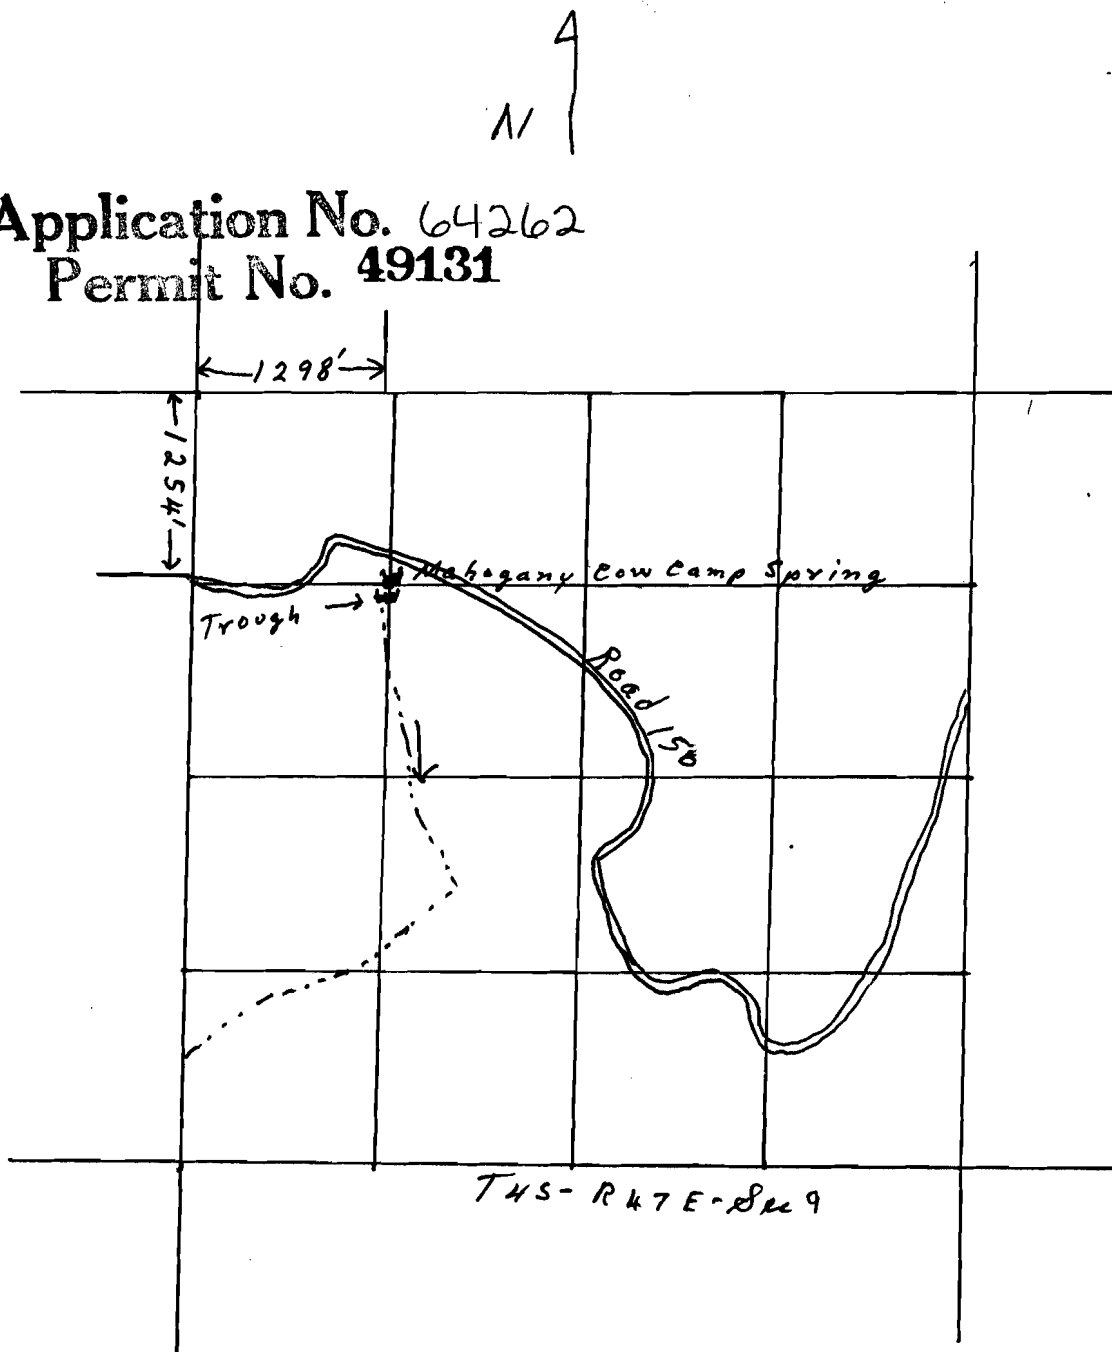

4 inches = 1 mile

RECEIVED

SEP 30 1982

WATER RESOURCES DEPT.
SALEM, OREGON