


TOWNSHIP 55, RANGE 29 E, SECTION 32, W.M.

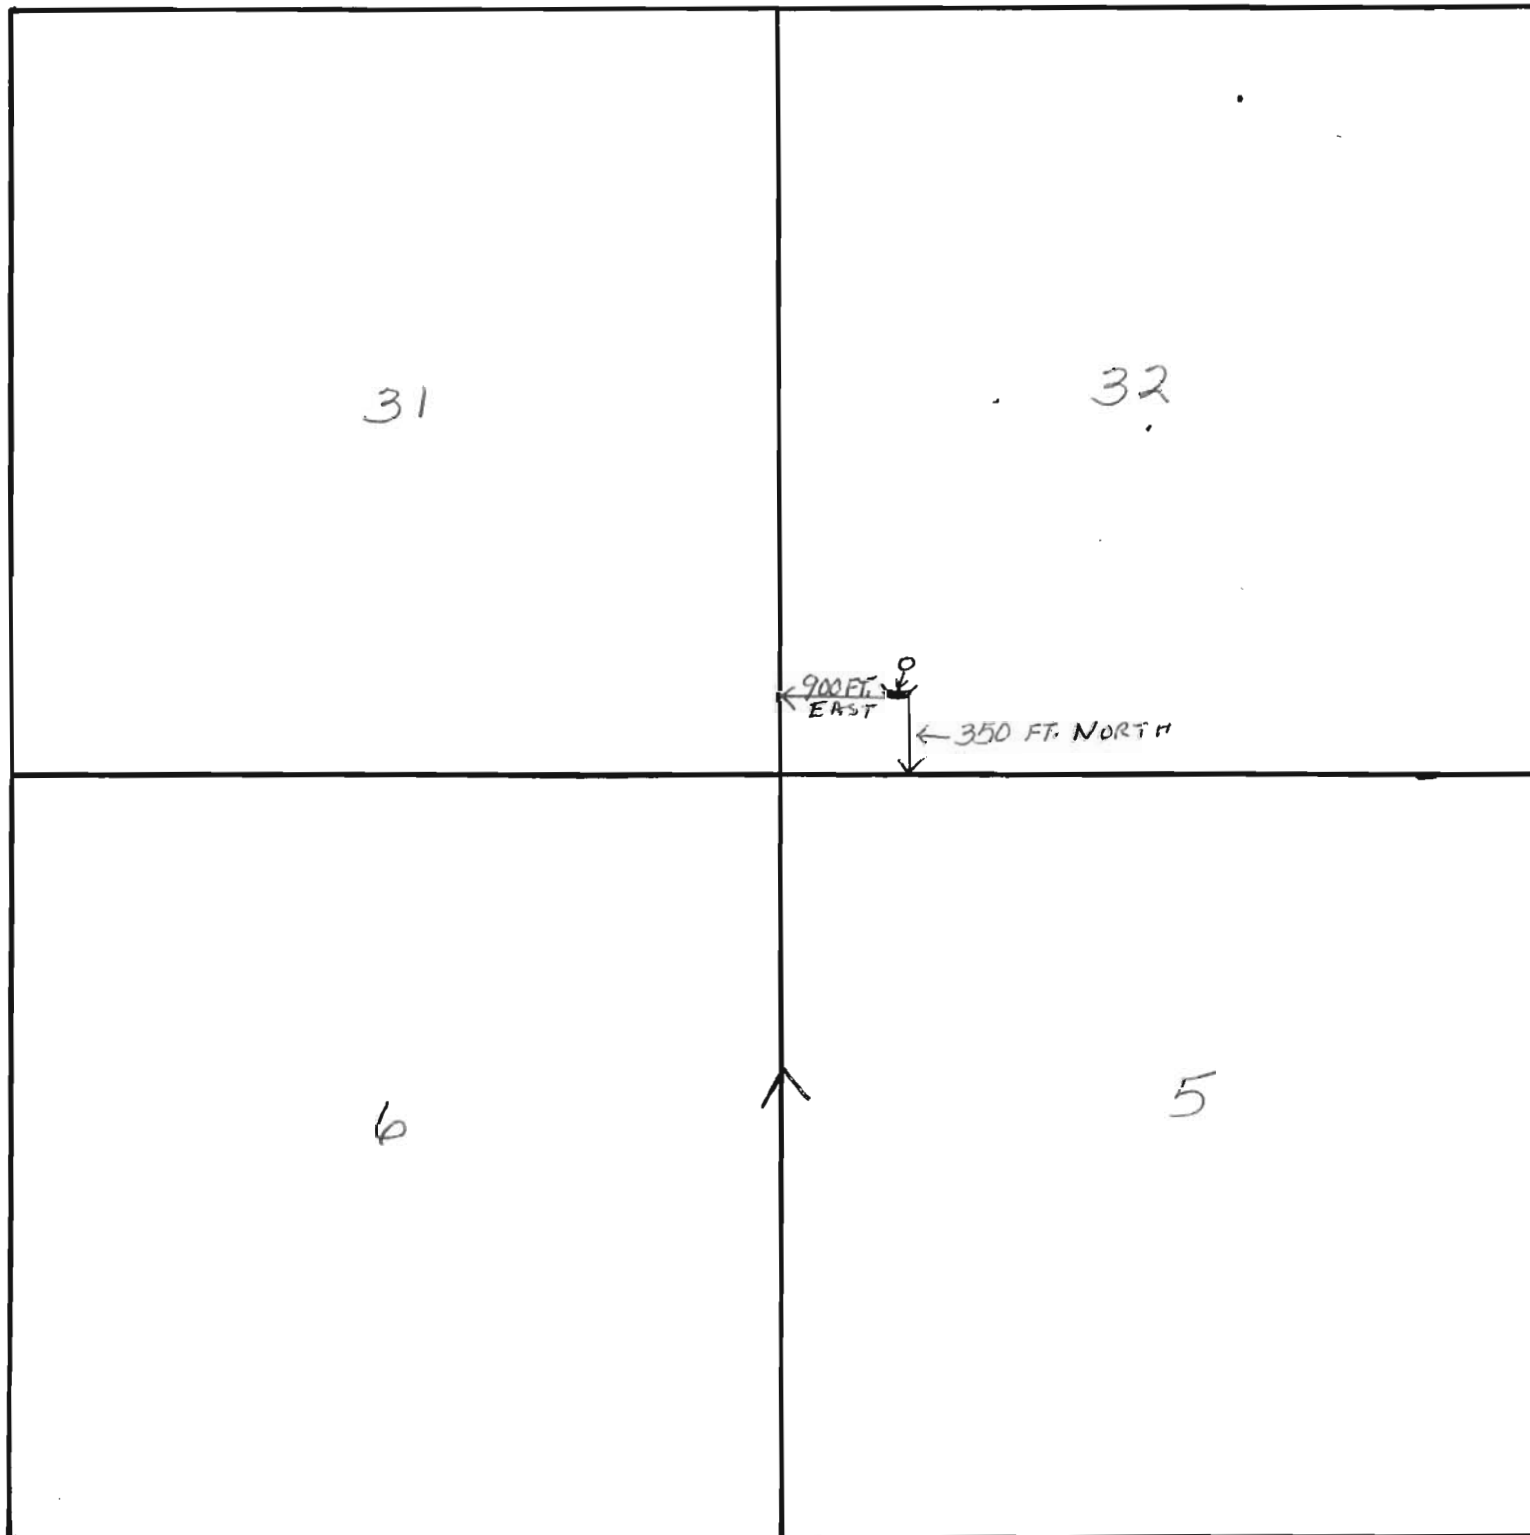

NAME GILBERT SPRING COUNTY MORROW

Application No. 64646

Permit No. 49151

RECEIVED

AUG 25 1983

WATER RESOURCES DEPT.
SALEM, OREGON

RECEIVED

JAN 10 1983

WATER RESOURCES DEPT.
SALEM, OREGON