


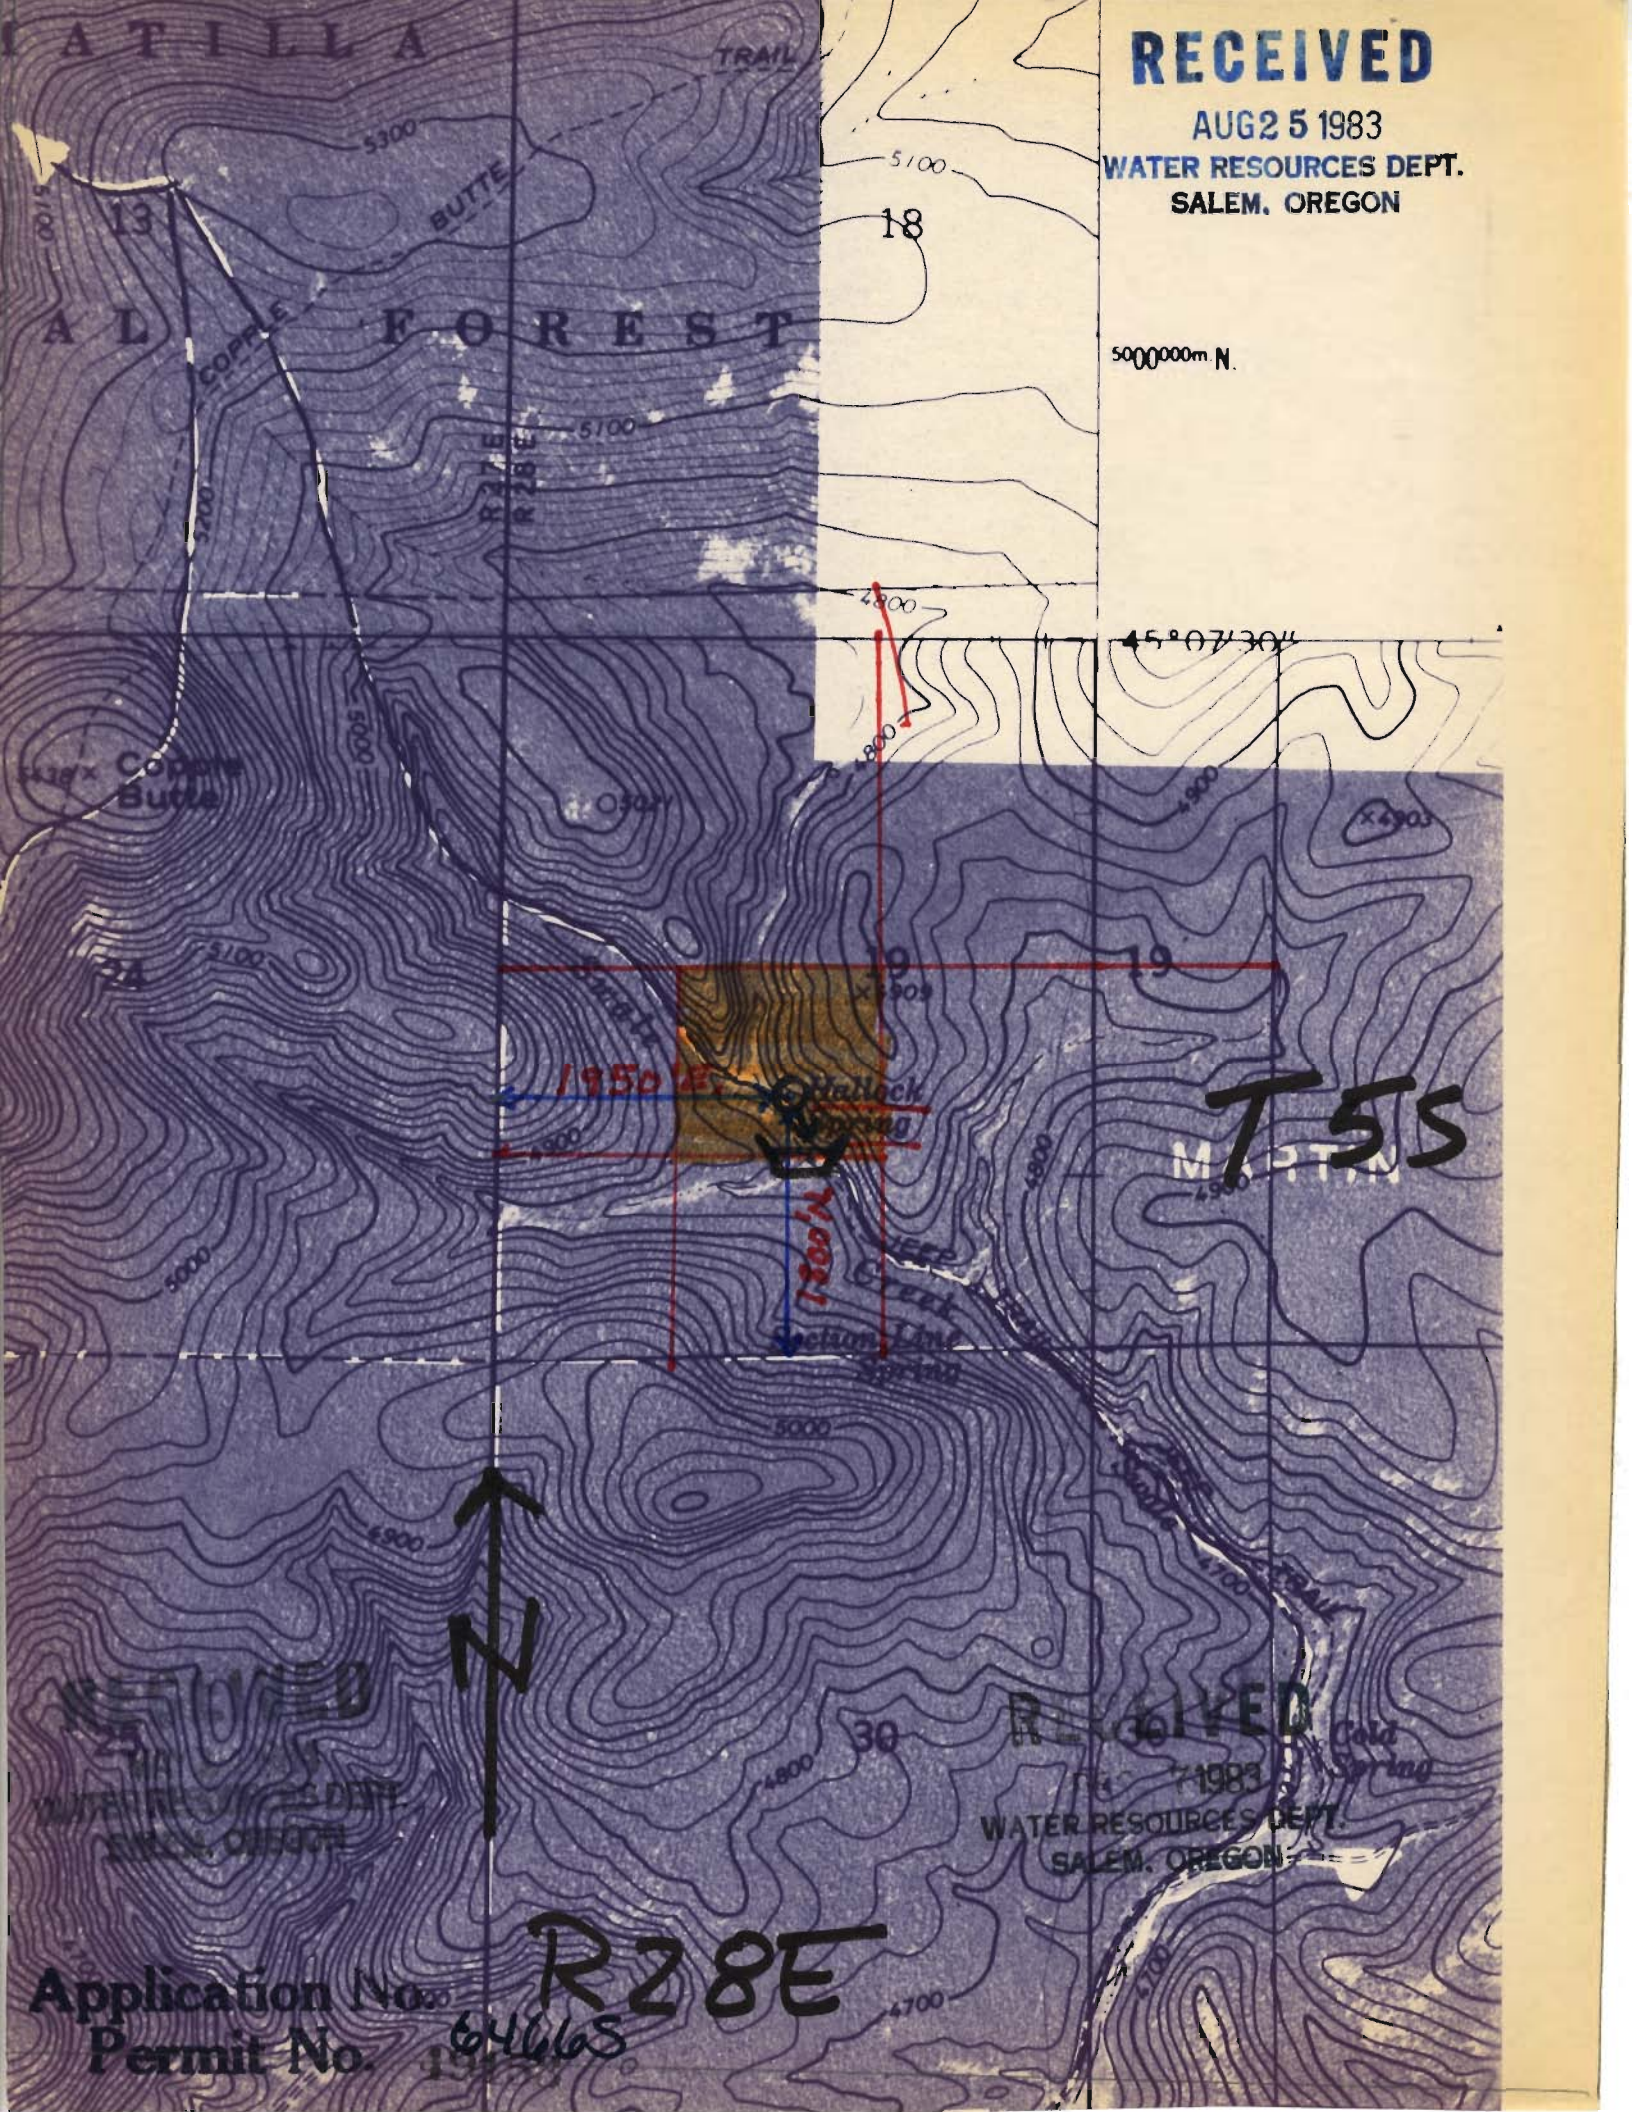

RECEIVED

AUG 25 1983

WATER RESOURCES DEPT.  
SALEM, OREGON

5000000m N.

45° 07' 30"

T55




Application No.  
Permit No.

R28E

6466S

RECEIVED

WATER RESOURCES DEPT.  
SALEM, OREGON

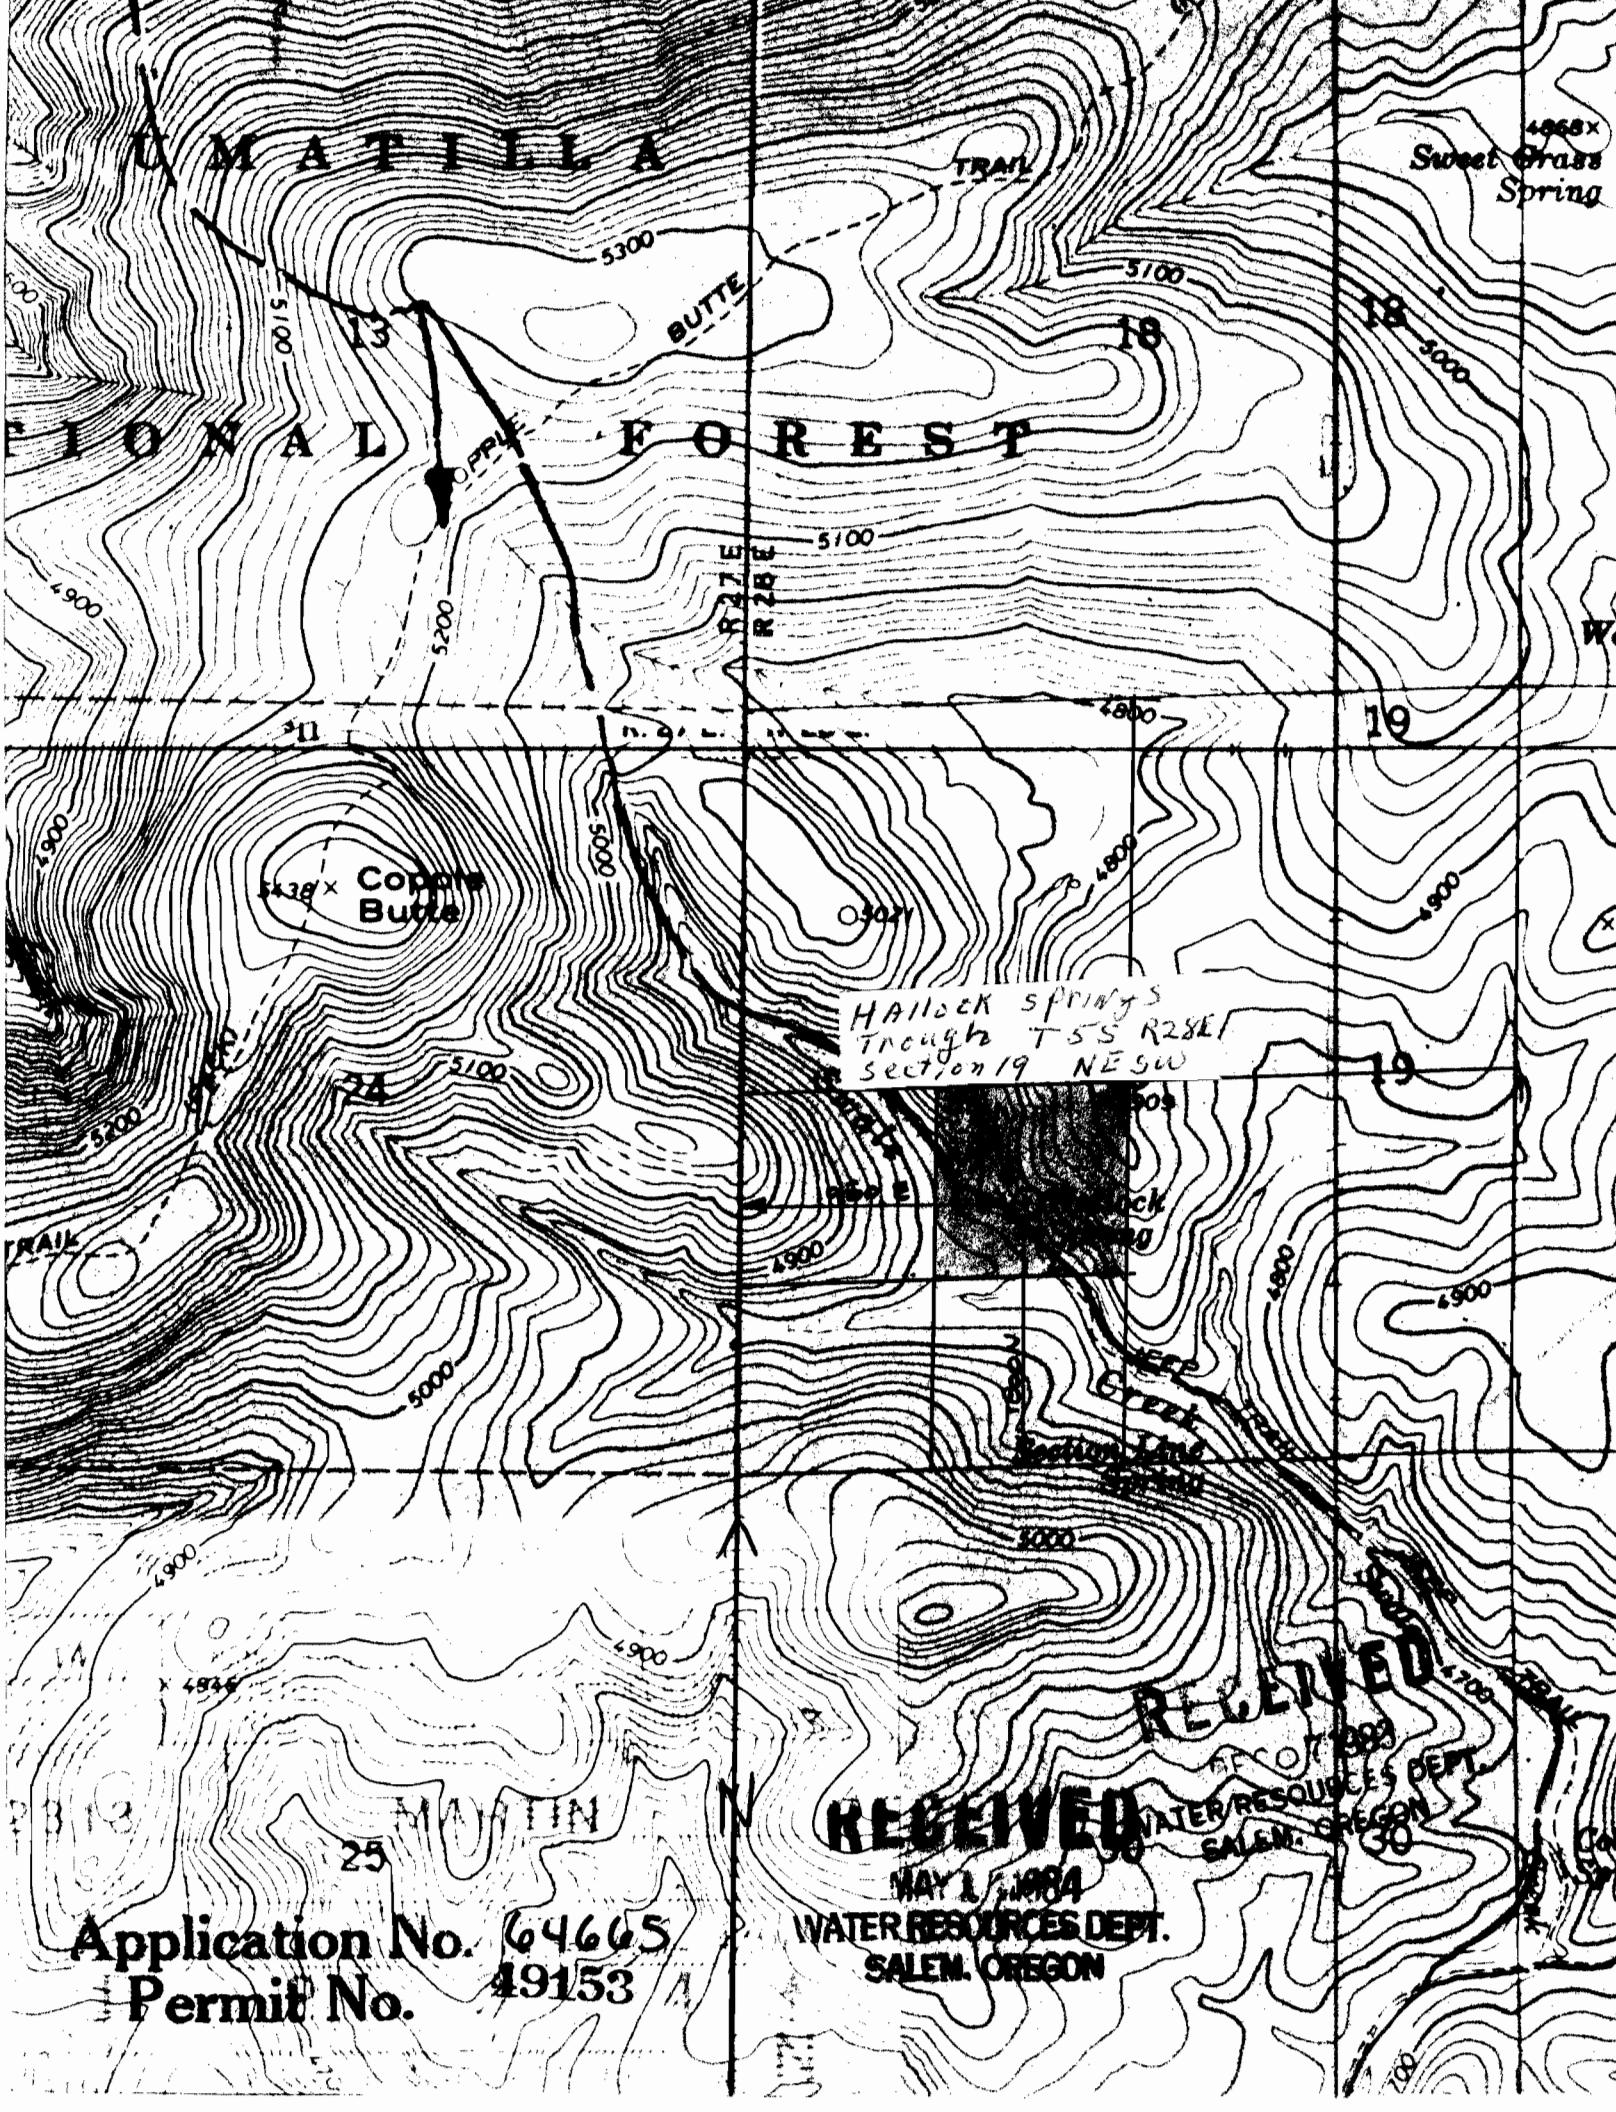

4868X  
Sweet Grass  
Spring

MATILLA

TRAIL

BUTTE

FOREST

4438X  
Copper  
Butte

Hailcock Springs  
Trough T5S R28E  
Section 19 NE SW

RECEIVED


RECEIVED

MAY 1 1984

WATER RESOURCES DEPT.  
SALEM, OREGON


REC'D  
WATER RESOURCES DEPT.  
SALEM, OREGON

Application No. 64665  
Permit No. 49153

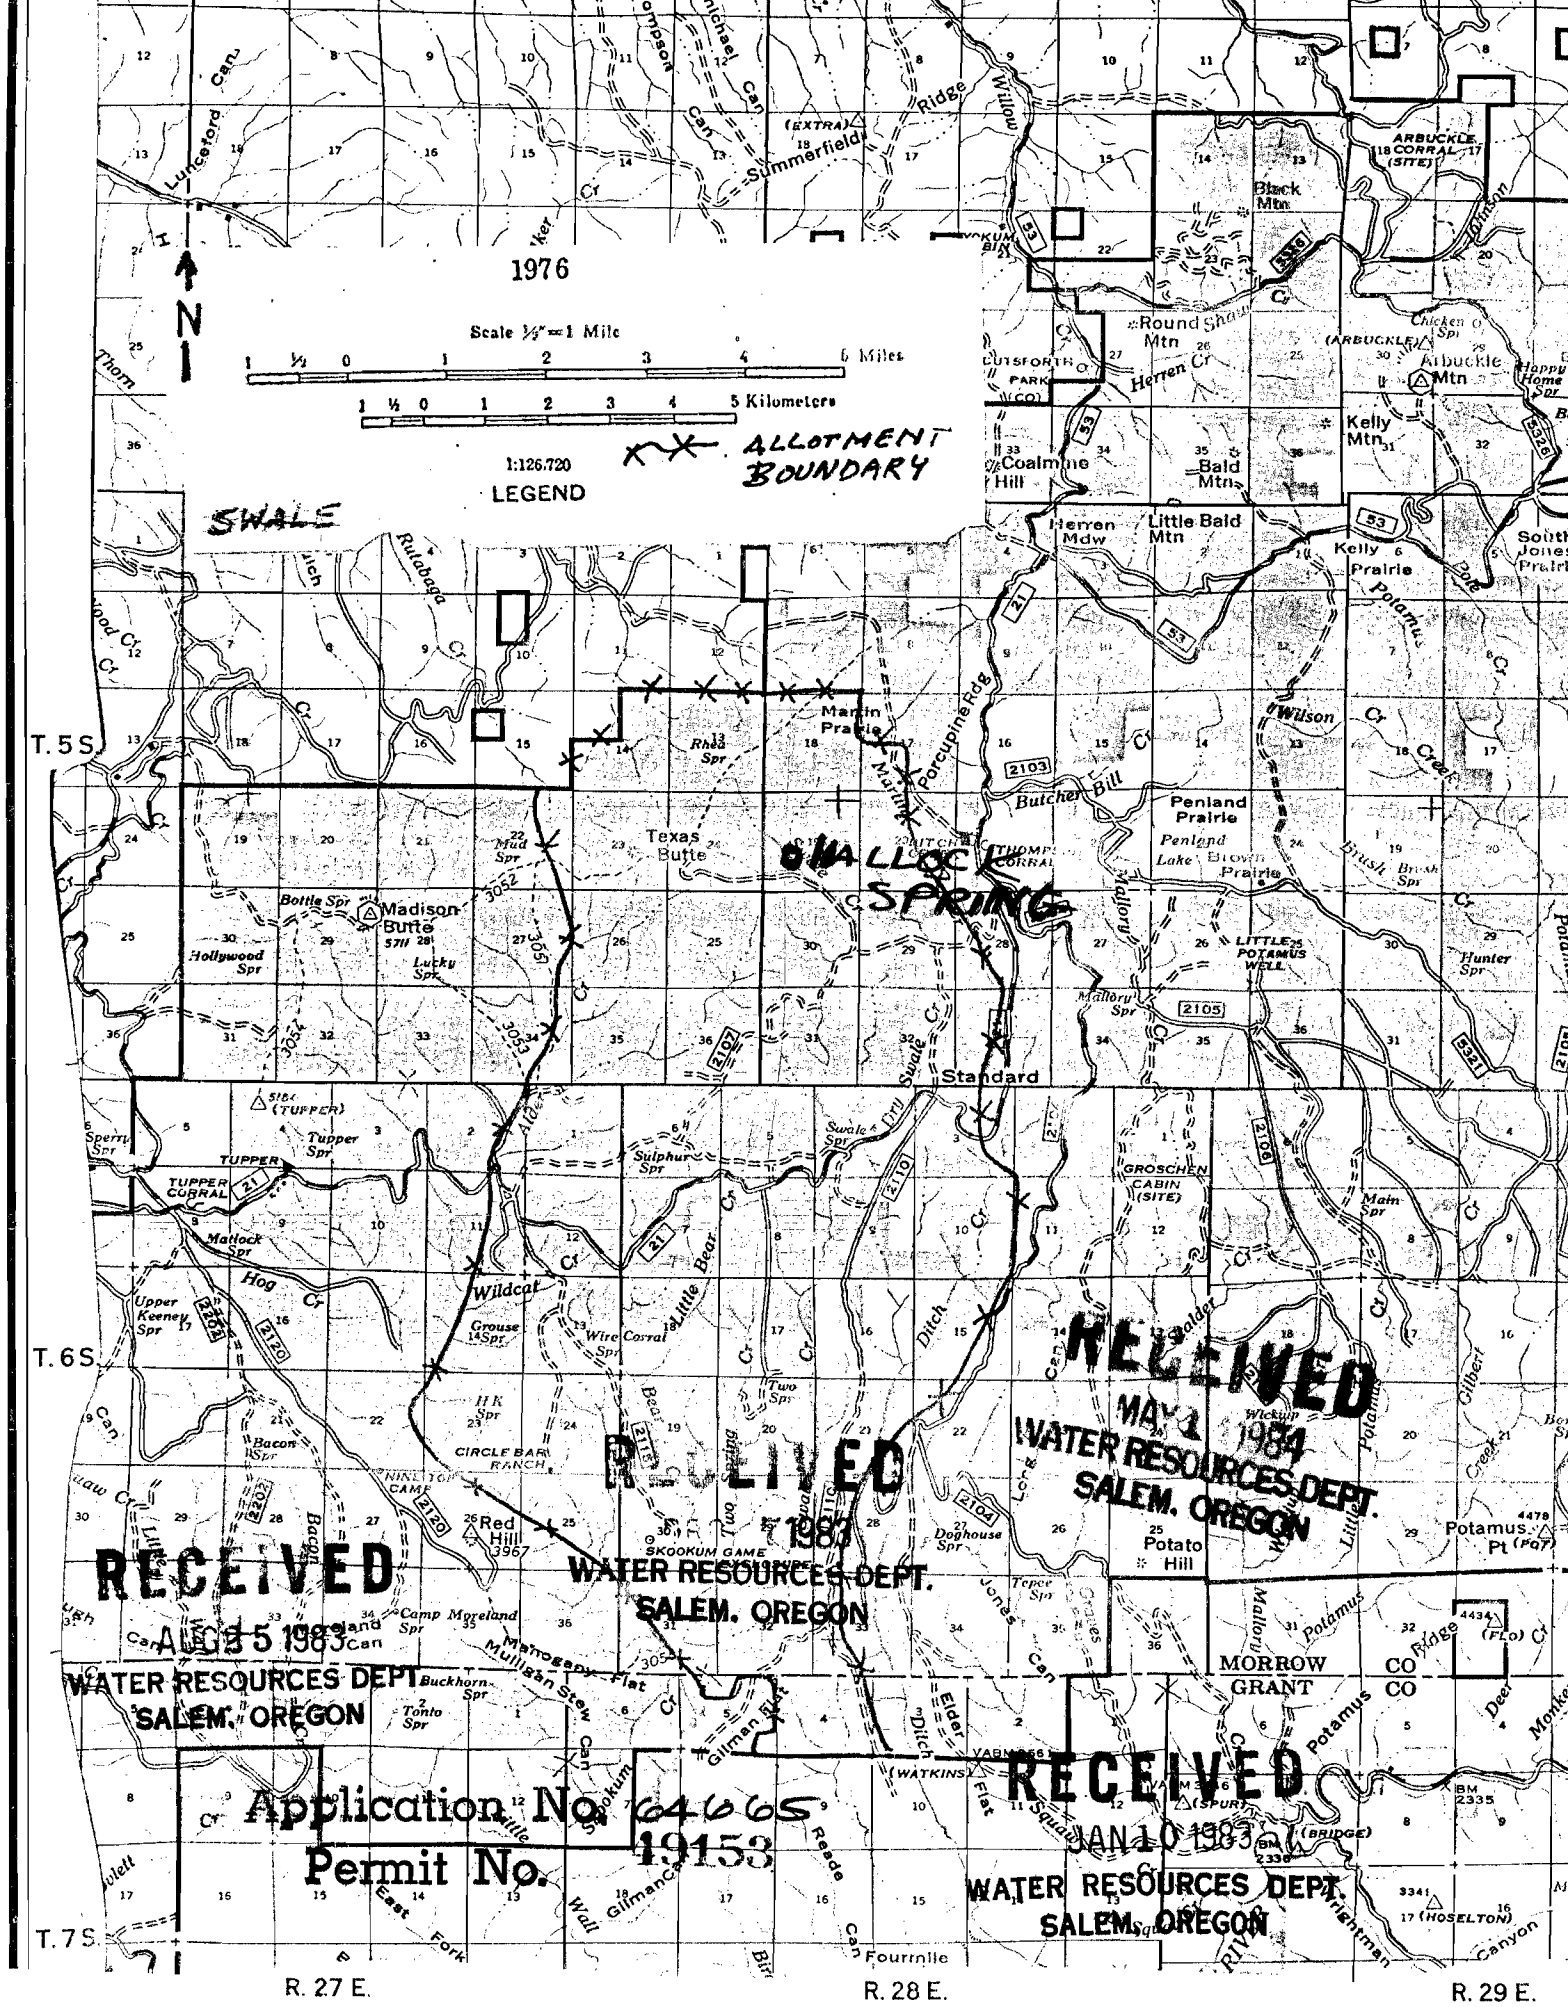

1976

Scale 1/2" = 1 Mile

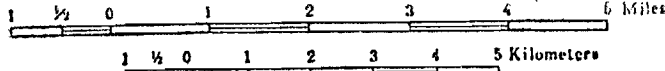

1:126,720

LEGEND

XX ALLOTMENT BOUNDARY

SWALE


RECEIVED  
MAY 1 1984  
WATER RESOURCES DEPT.  
SALEM, OREGON

RECEIVED  
AUG 5 1983  
WATER RESOURCES DEPT.  
SALEM, OREGON

RECEIVED  
MAY 1 1984  
WATER RESOURCES DEPT.  
SALEM, OREGON

RECEIVED  
JAN 10 1983  
WATER RESOURCES DEPT.  
SALEM, OREGON

Permit No. 19153

R. 27 E.

R. 28 E.

R. 29 E.

MADISON BUTTE QUADRANGLE  
OREGON - MORROW CO.  
7.5 MINUTE SERIES (TOPOGRAPHIC)

2174 III NE  
(ARBUCKLE MTN.)

5'  
W


25' 2 280 000 FEET

311

R. 27 E. R. 28 E.

313

119° 22' 30" 45° 07' 30"

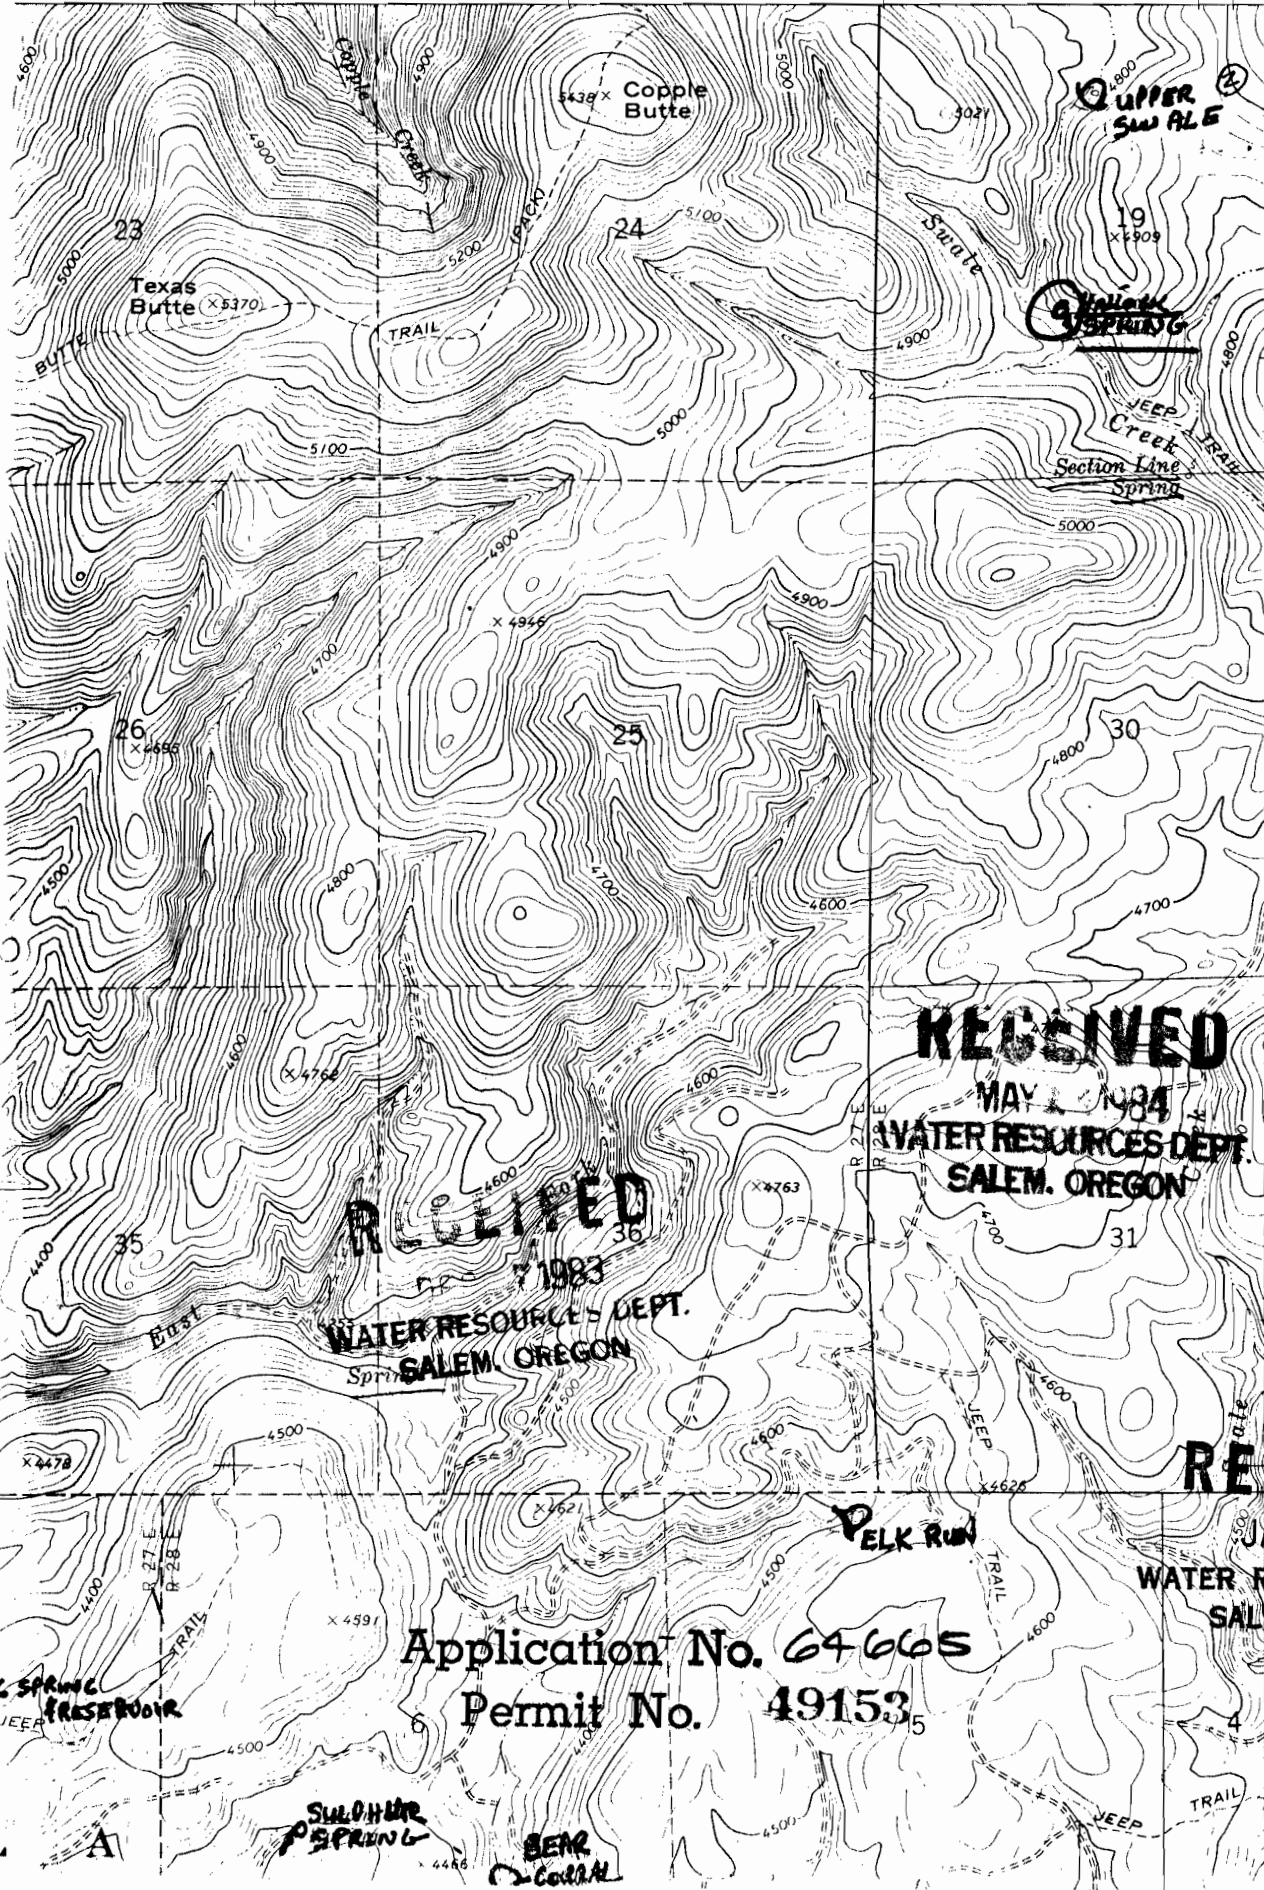

T5s

**RECEIVED**

AUG 25 1983  
WATER RESOURCES DEPT.  
SALEM, OREGON

**RECEIVED**

MAY 1 1984  
WATER RESOURCES DEPT.  
SALEM, OREGON

**RECEIVED**

JUL 7 1983  
WATER RESOURCES DEPT.  
SALEM, OREGON

**RECEIVED**

JAN 10 1983  
WATER RESOURCES DEPT.  
SALEM, OREGON

Application No. 64665  
Permit No. 49153


Swale  
Creek

L. SPRING  
RESERVOIR

SILVER  
SPRING

BERR  
Creek

HEPPNER 32 MI.

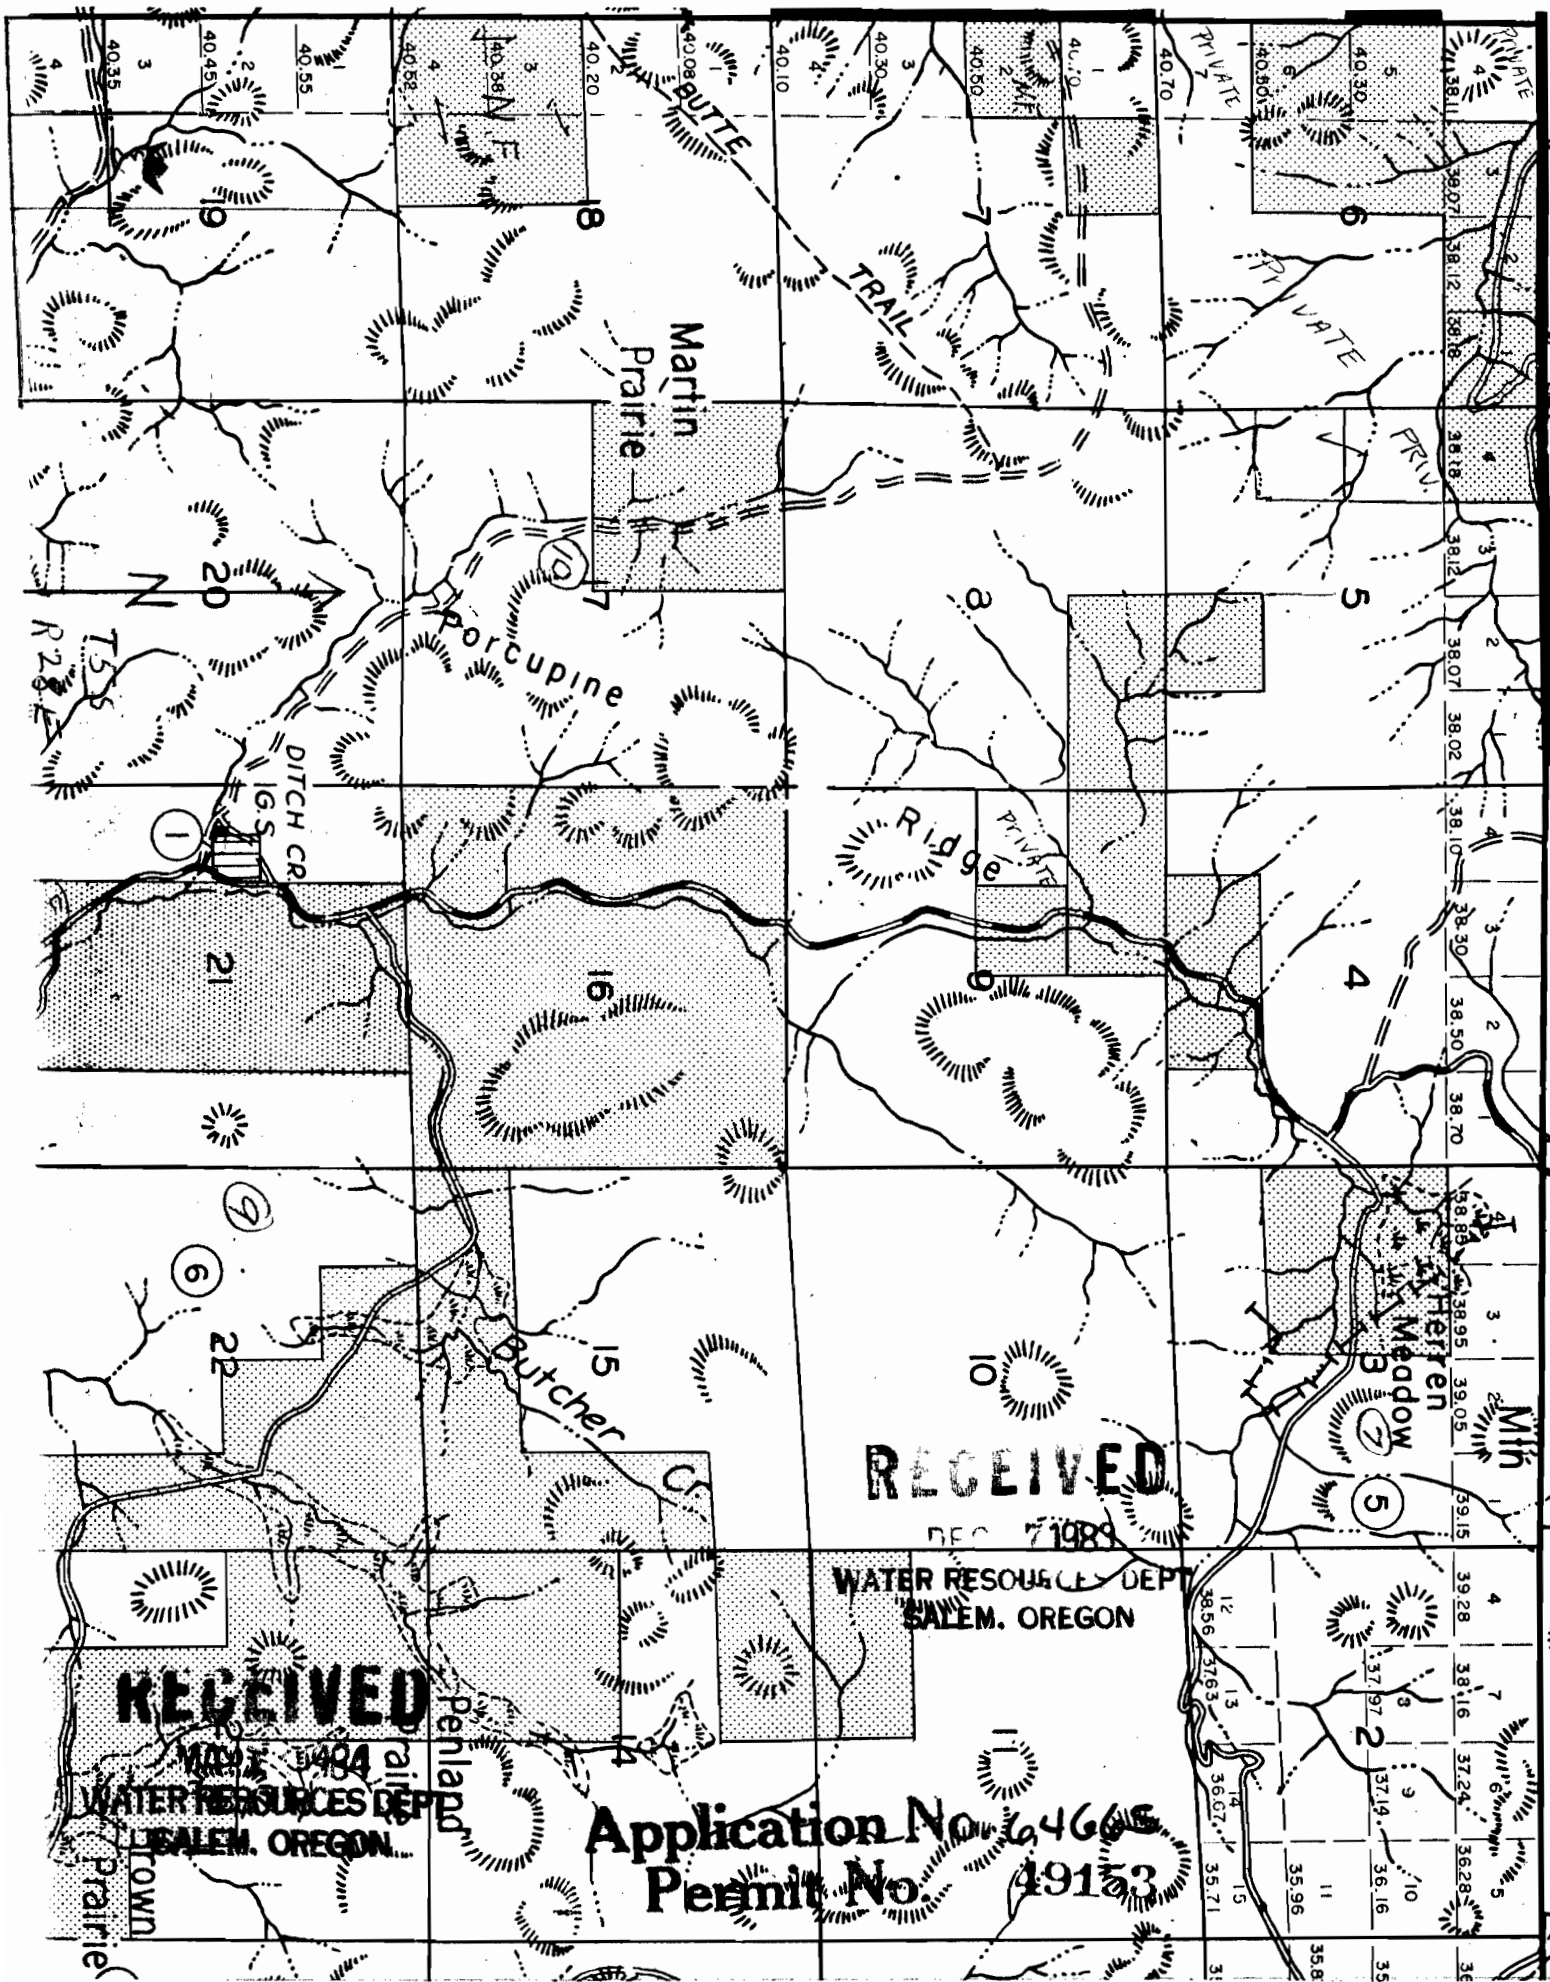

Martin  
Prairie

Porcupine

Ridge

Butcher  
Cr

Meadow

**RECEIVED**

DEC 7 1989

WATER RESOURCES DEPT  
SALEM, OREGON

**RECEIVED**


WATER RESOURCES DEPT  
SALEM, OREGON

Application No. 64665  
Permit No. 49153