


1. 55.
07' 30"
T. 6.S.
KINZUA 6 MILES
45° 00'
T. 7.S.
52' 30"
T. 8.S.

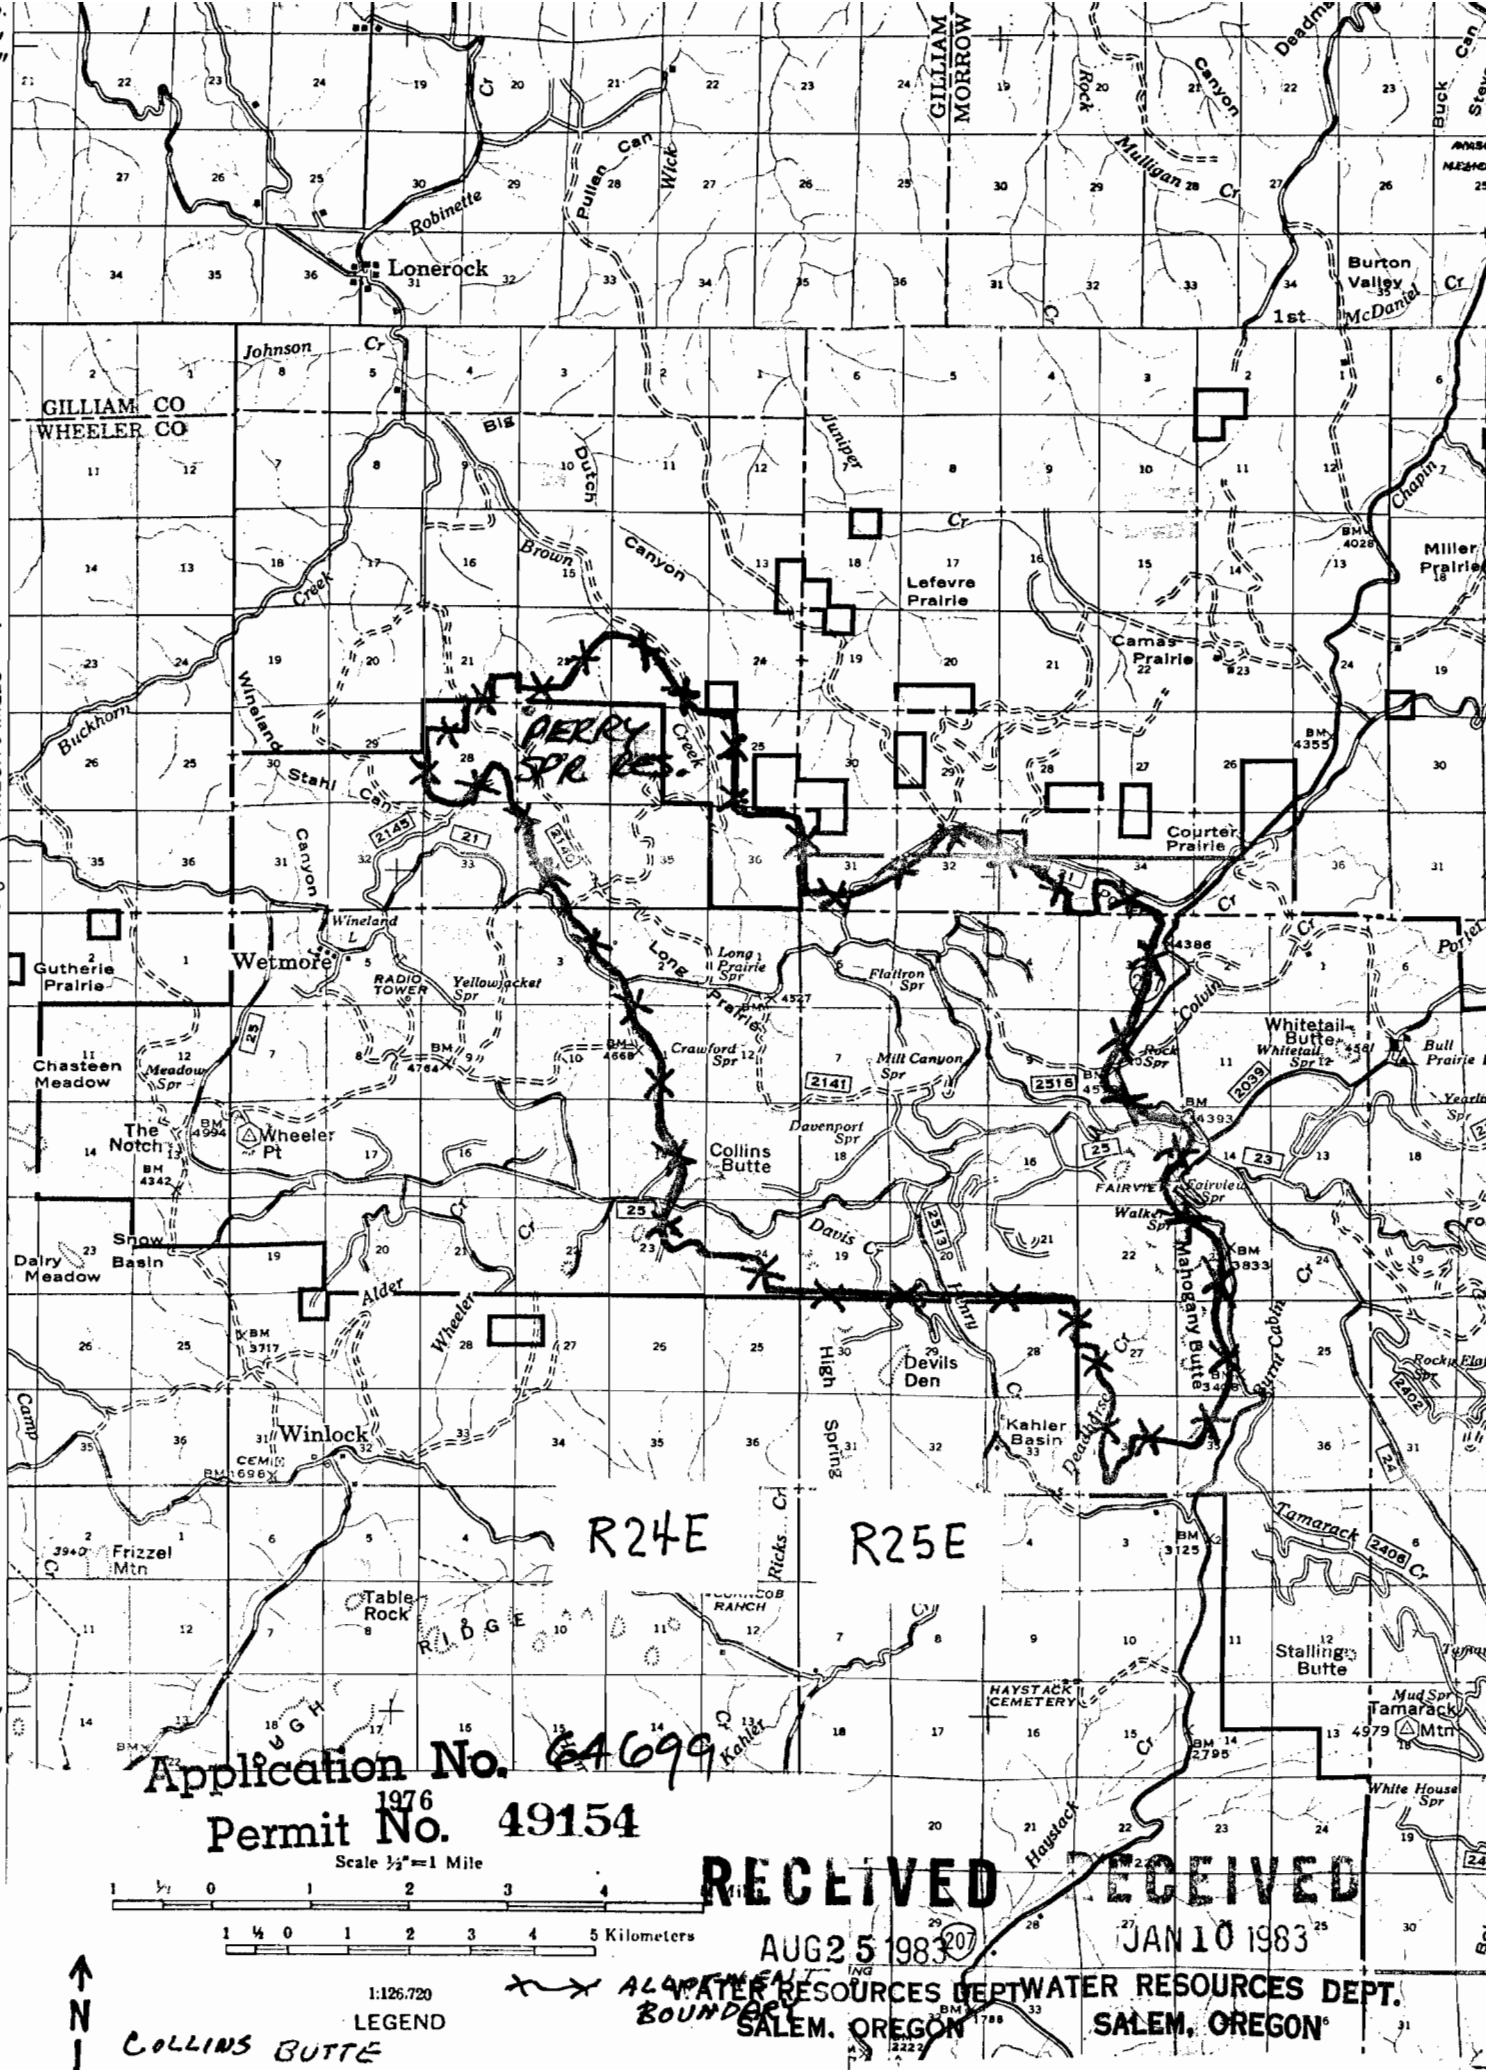

Application No. 64699
Permit No. 49154
Scale 1/2" = 1 Mile


RECEIVED RECEIVED

AUG 25 1983 JAN 10 1983

WATER RESOURCES DEPT. WATER RESOURCES DEPT.
SALEM, OREGON SALEM, OREGON



COLLINS BUTTE

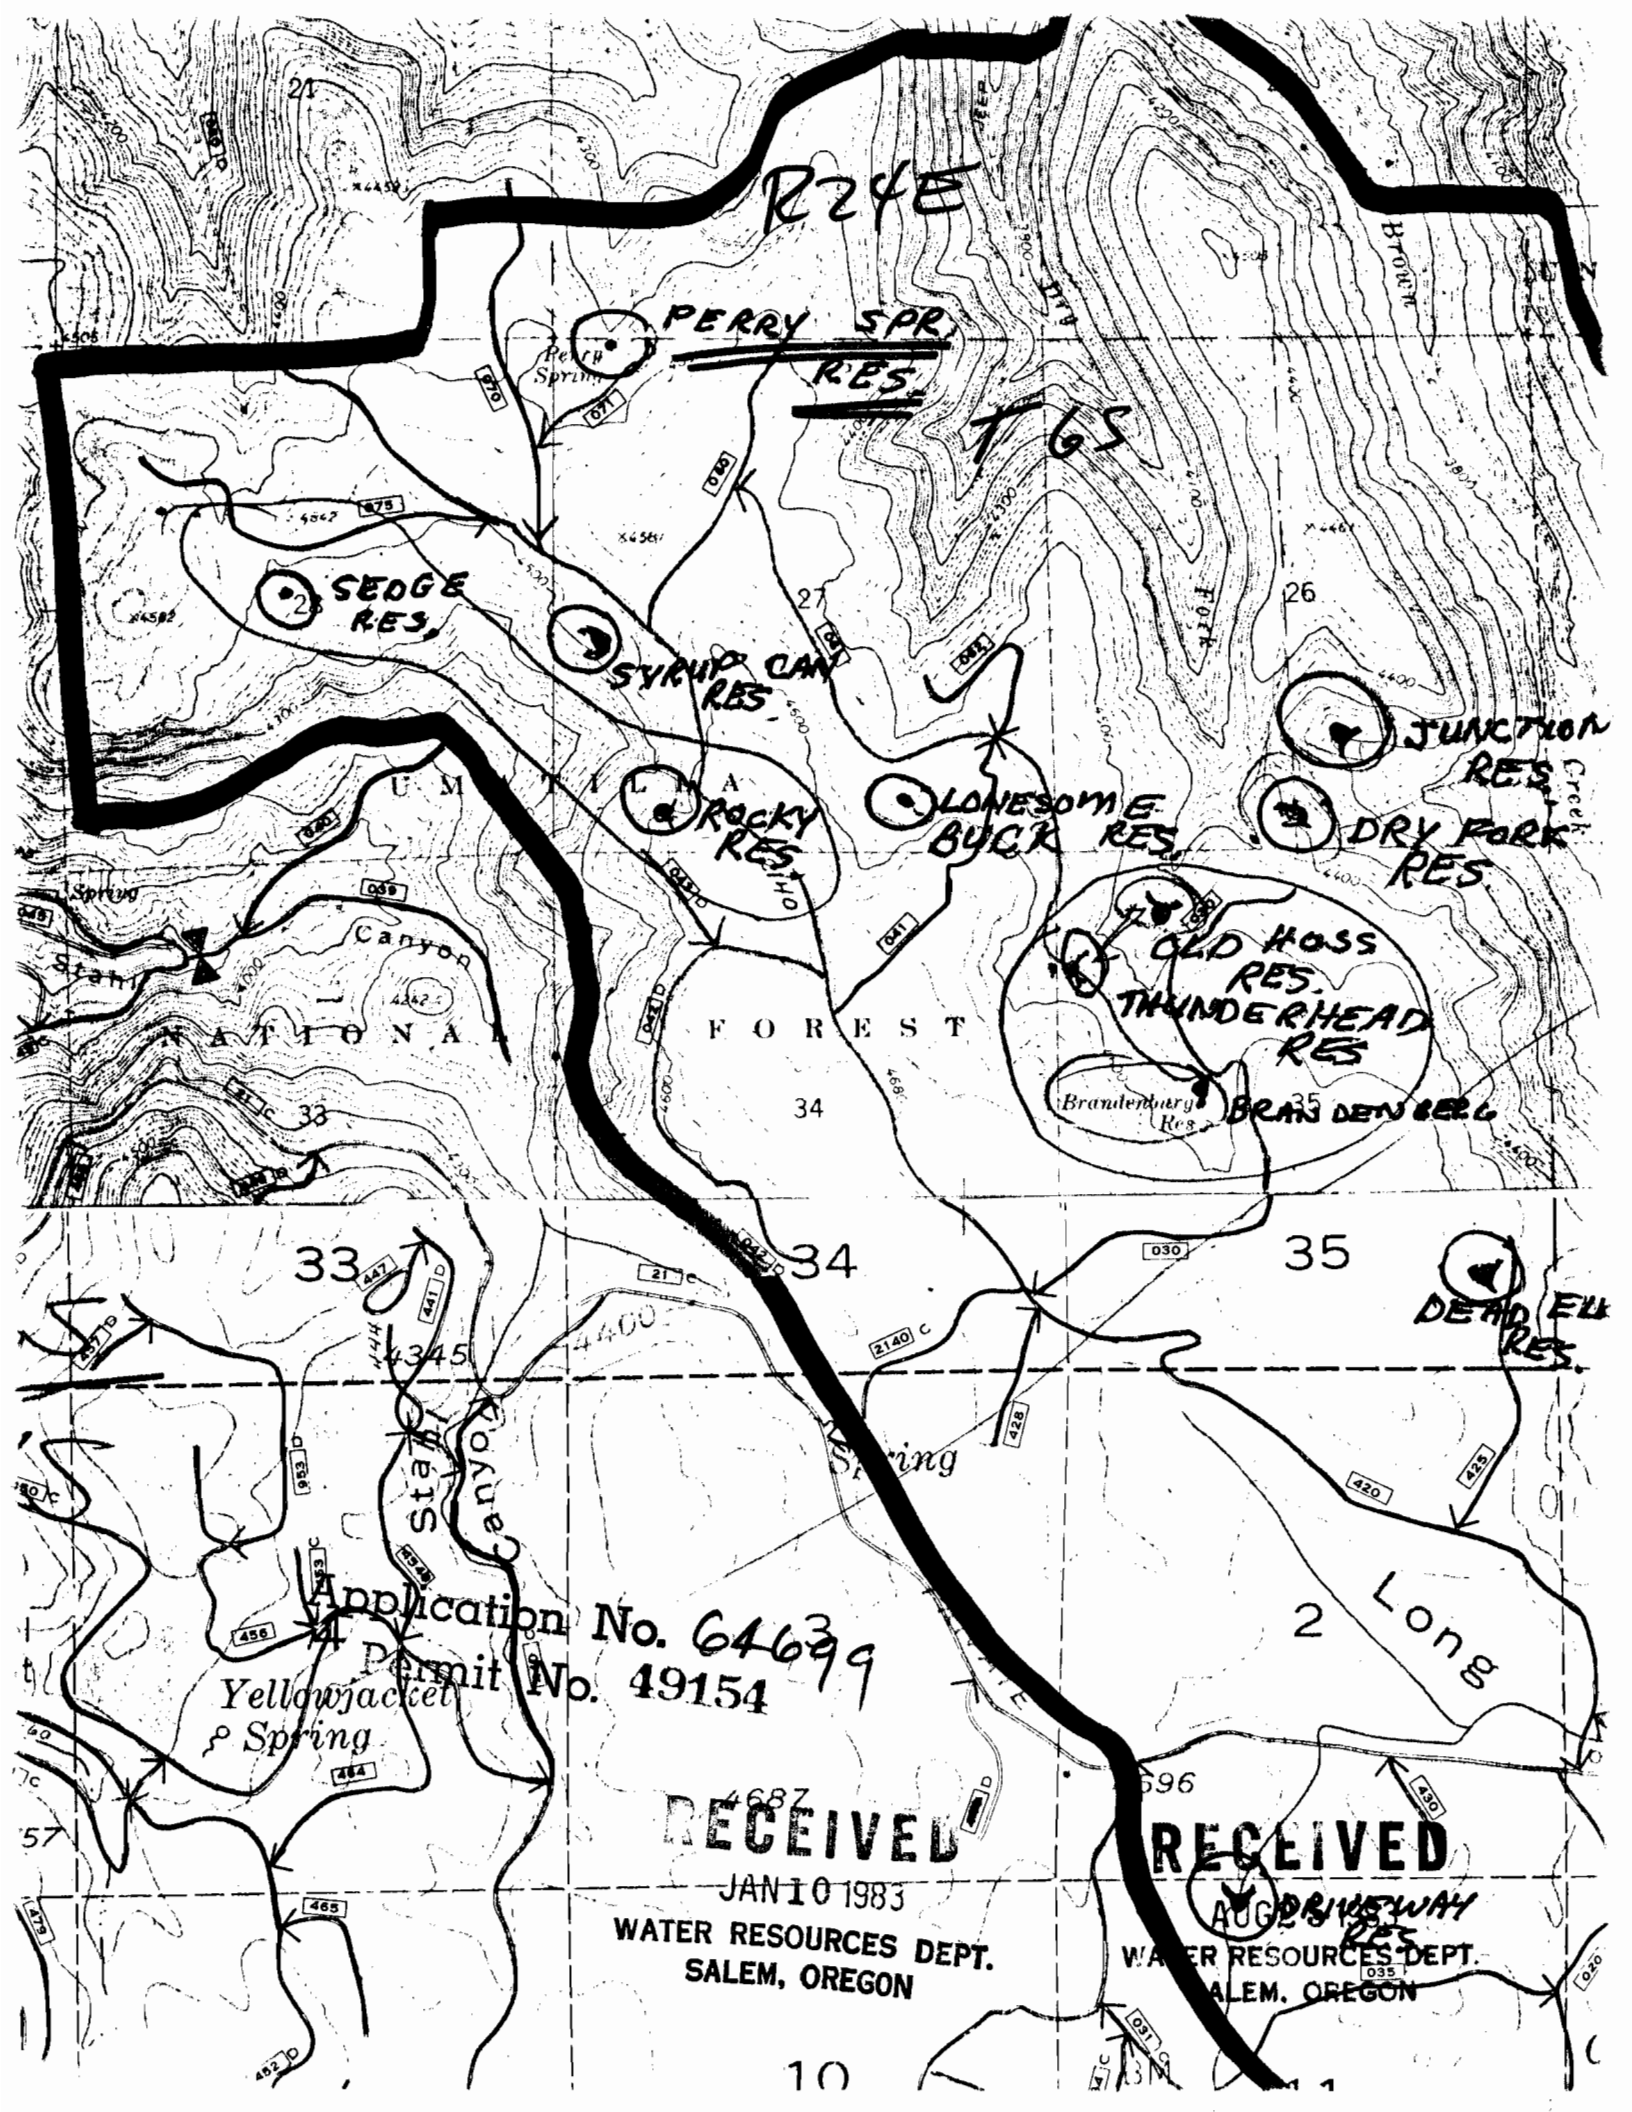

R24E

PERRY SPR
RES

T6S

2 SEGE
RES

SYRUP CAN
RES

ROCKY
RES

LONESOME
BUCK RES

JUNCTION
RES

DRY FORK
RES

OLD MOSS
RES
THUNDERHEAD
RES

Brandenburg Res
BRANDENBURG

DEAD ELK
RES

33

34

35

Application No. 646399
Permit No. 49154
Yellowjacket
& Spring

2 Long

RECEIVED


JAN 10 1983

WATER RESOURCES DEPT.
SALEM, OREGON

RECEIVED

AUG 28 1983

WATER RESOURCES DEPT.
SALEM, OREGON

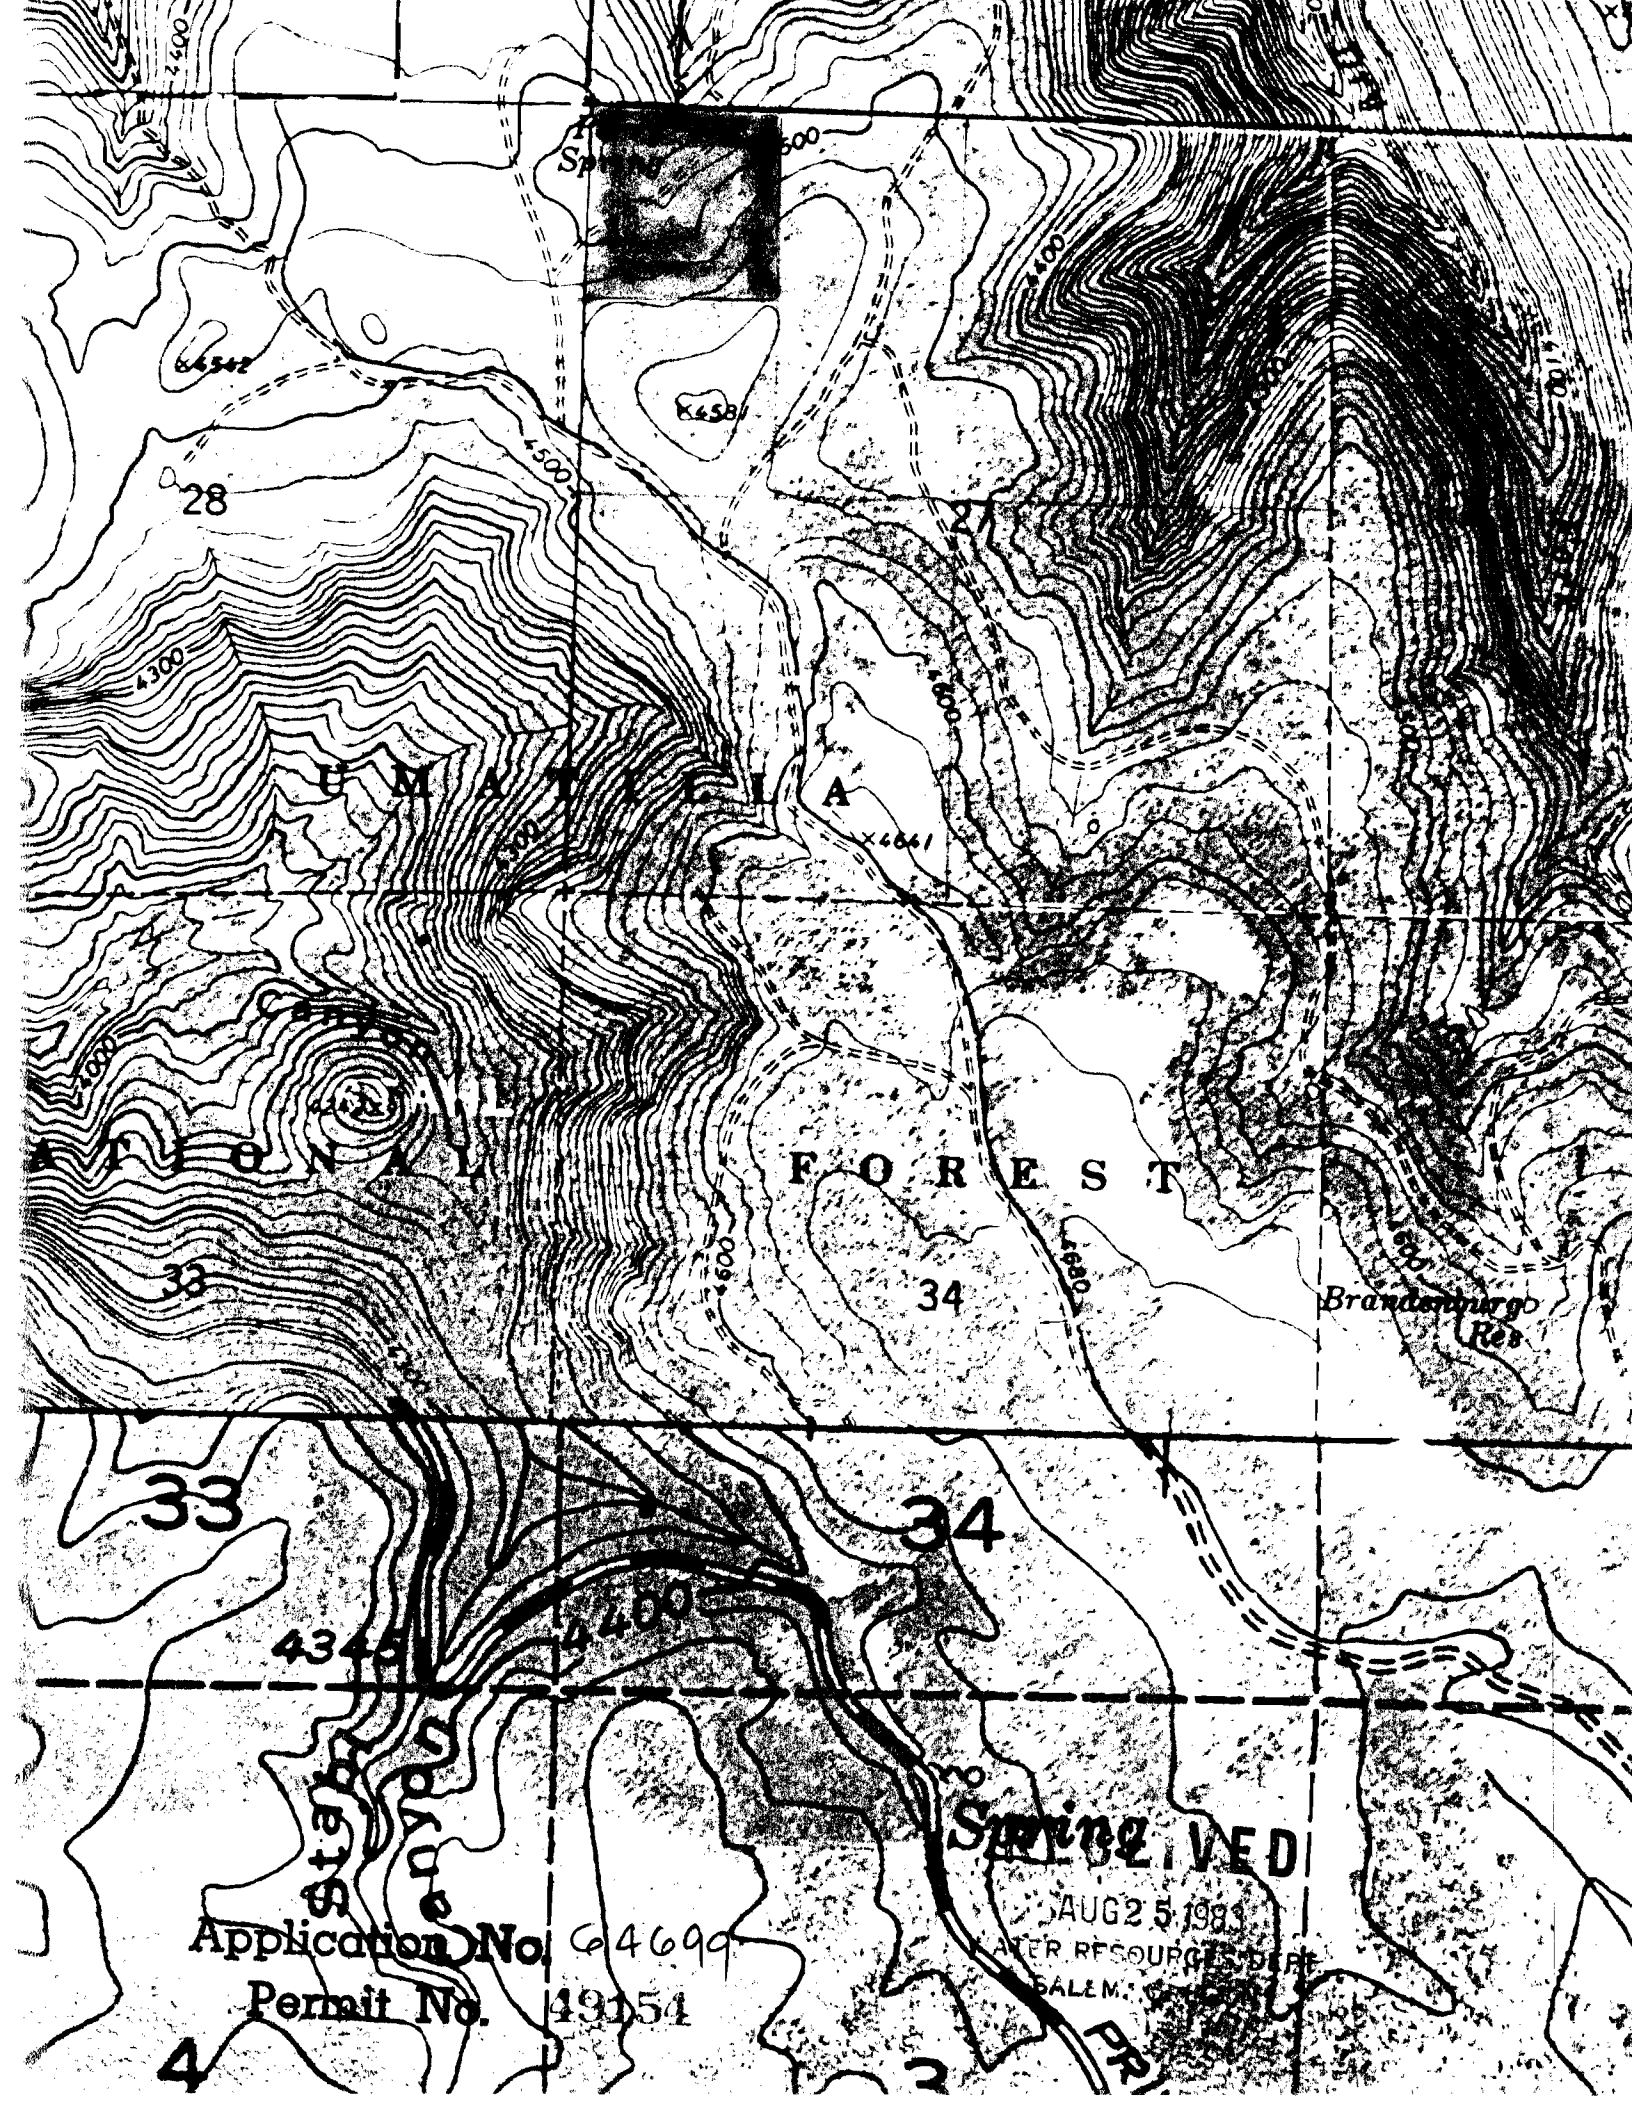

Application No. 64699
Permit No. 49154

RECEIVED
WATER RESOURCES DEPT
SALEM, OREGON

TOWNSHIP 6S, RANGE 24E, SECTION 27, W.M.

21

22

28

27

73 FT.
SOUTH
586 FT.
EAST

NAME PERRY SPR. RES

COUNTY WHEELER

Application No. 64699

Permit No. 49154

13

RECEIVED
10 1983

AUG 25 1983
WATER RESOURCES DEPT.
SALEM, OREGON
WATER RESOURCES DEPT.
SALEM, OREGON