


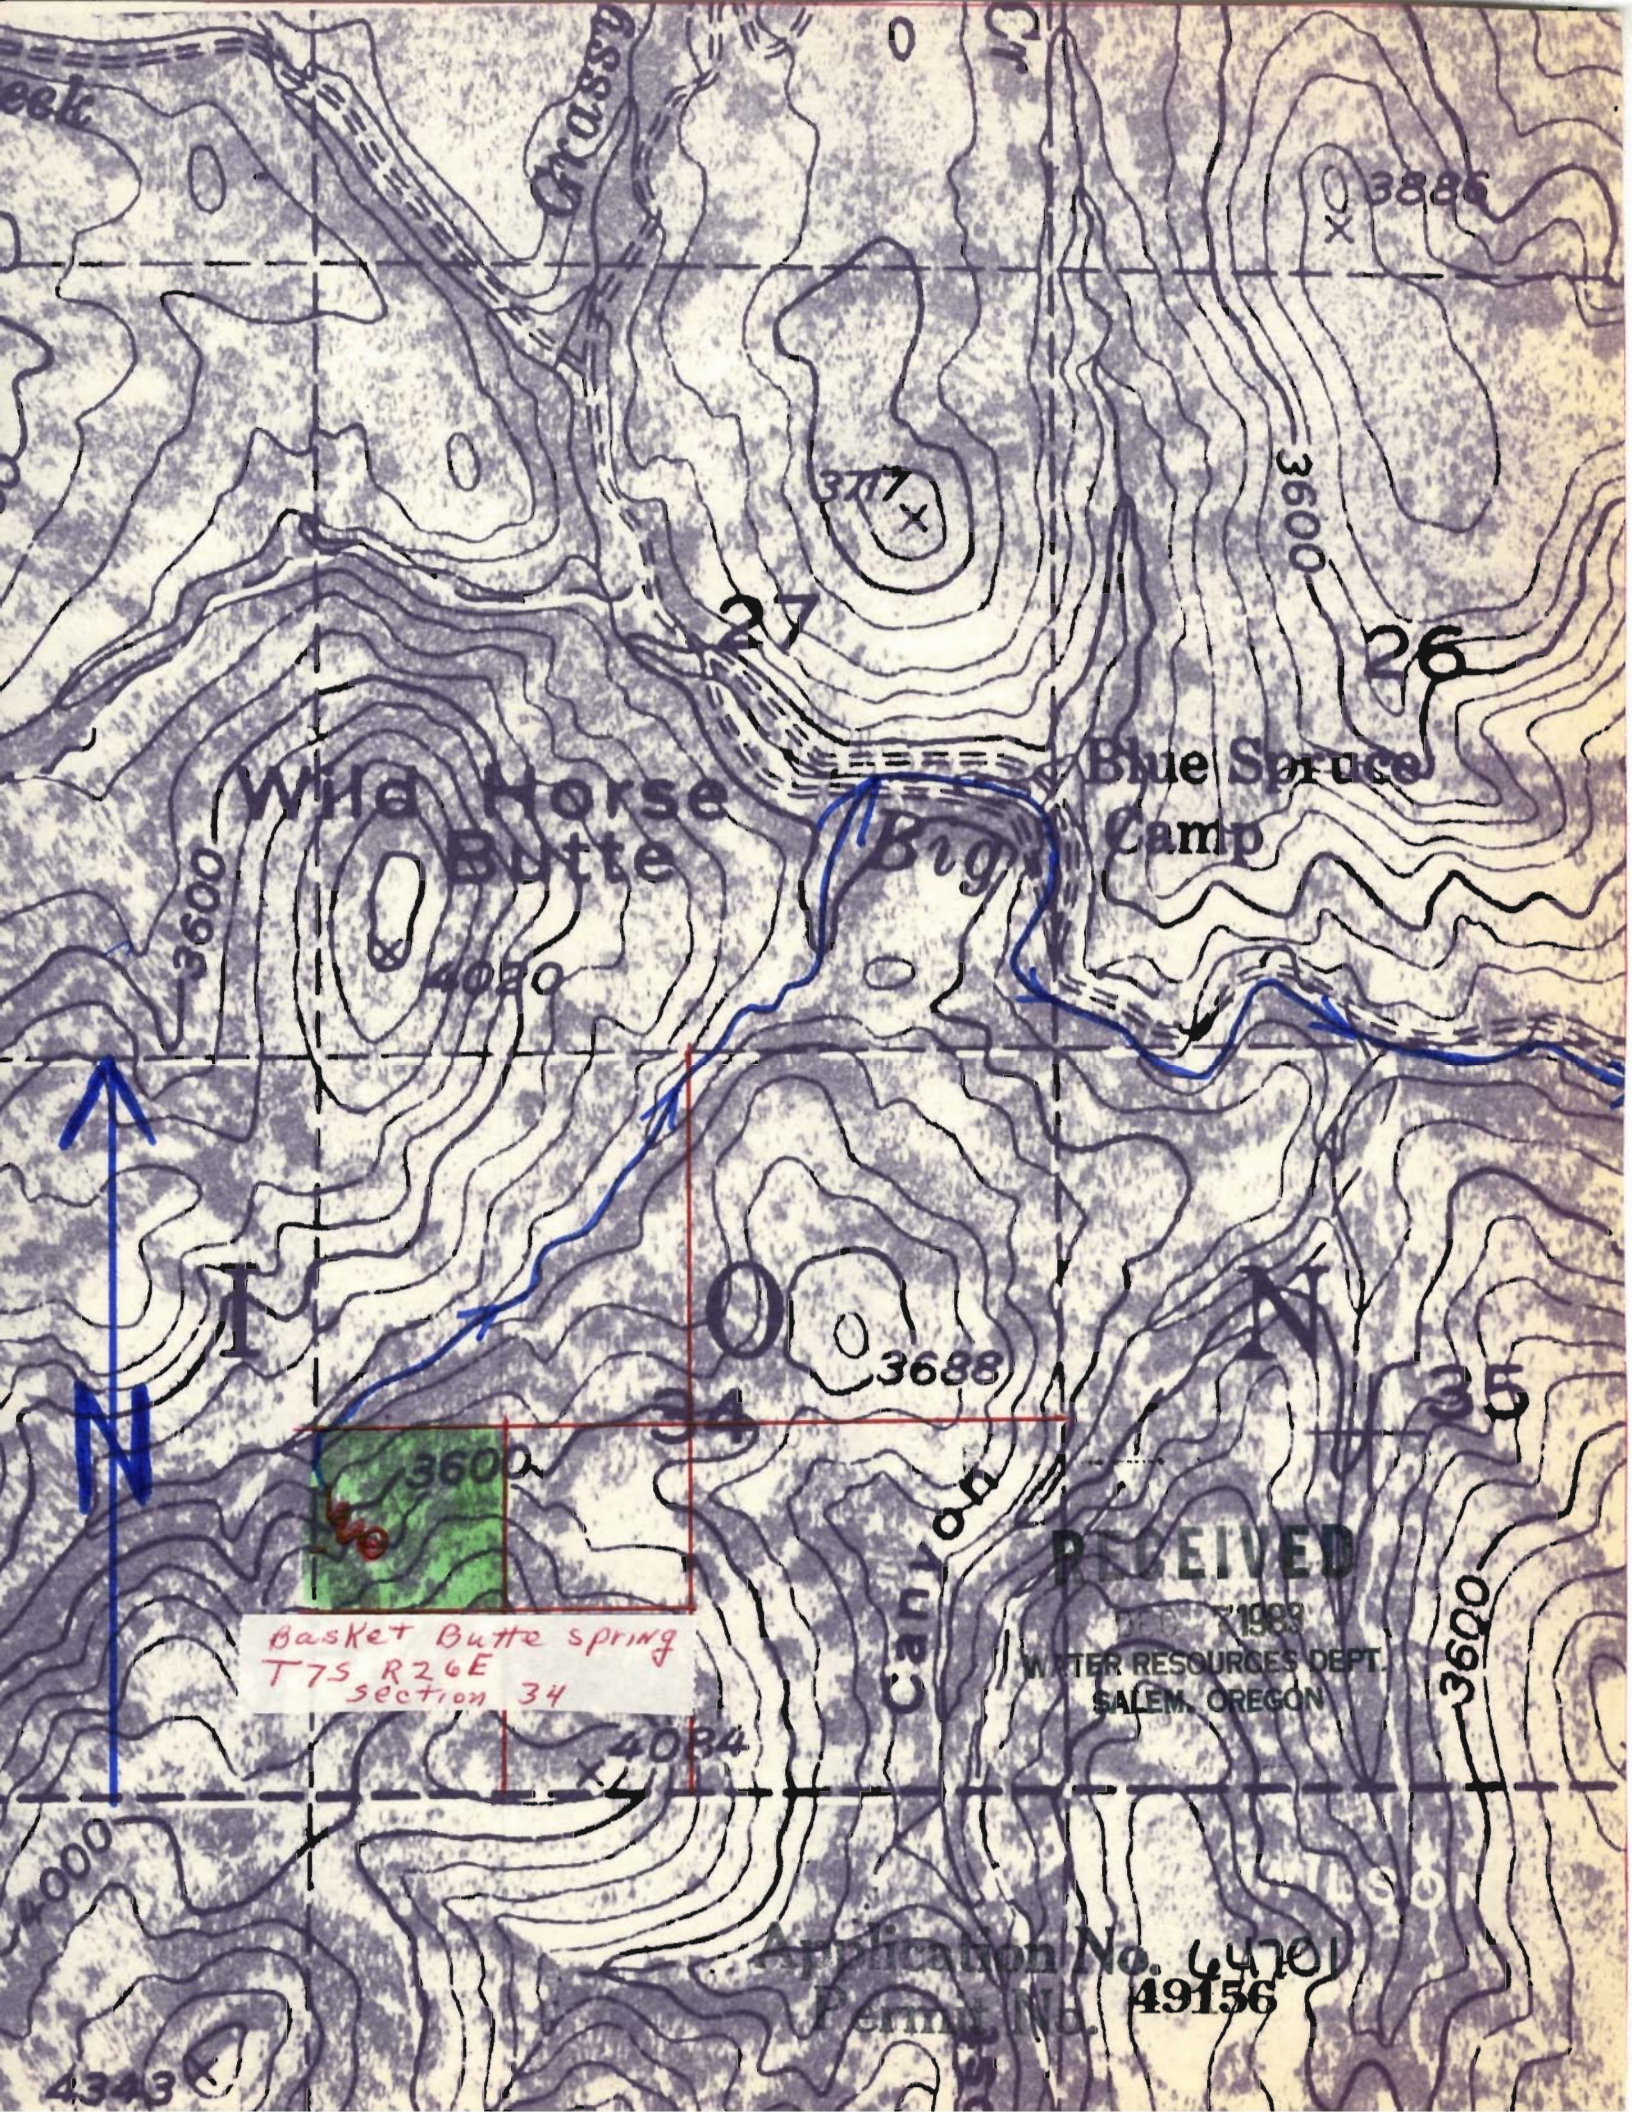

Wild Horse Butte

Blue Spruce Camp


Big Canyon

Basket Butte spring
T7S R26E
section 34

RECEIVED

71983
WATER RESOURCES DEPT.
SALEM, OREGON

Application No. 64701
Permit No. 49156

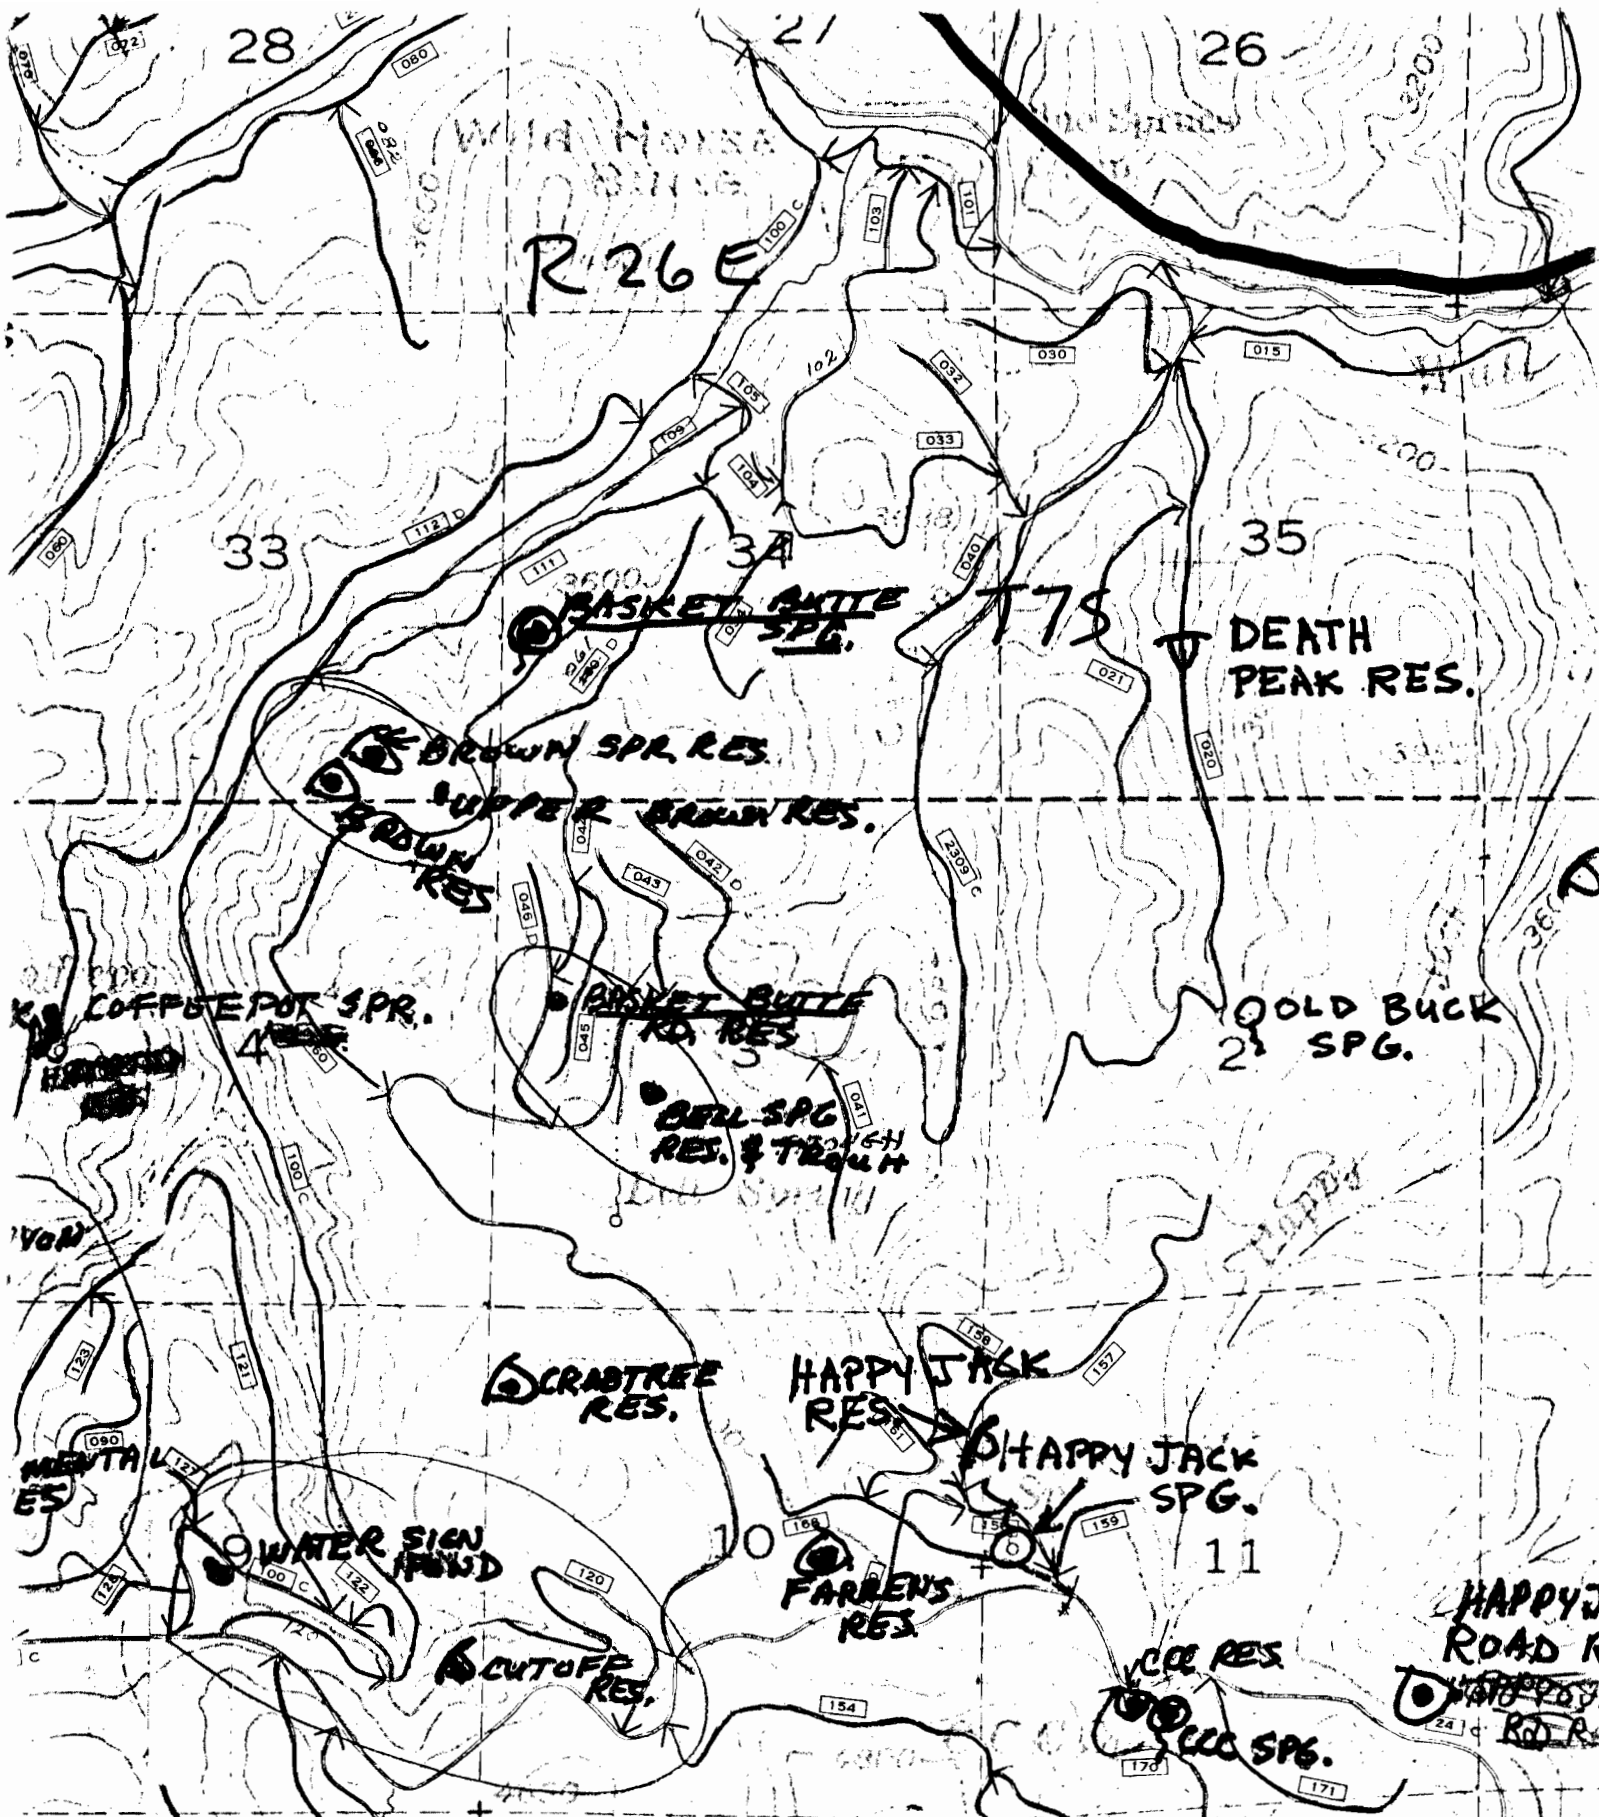

Application No. 64701
 Permit No. 49156

RECEIVED

JAN 10 1983


WATER RESOURCES DEPT. WATER RESOURCES DEPT.
 SALEM, OREGON SALEM, OREGON

RECEIVED

DEC 7 1983

Putnam Spr


WHEELER CO.
GRANT CO.

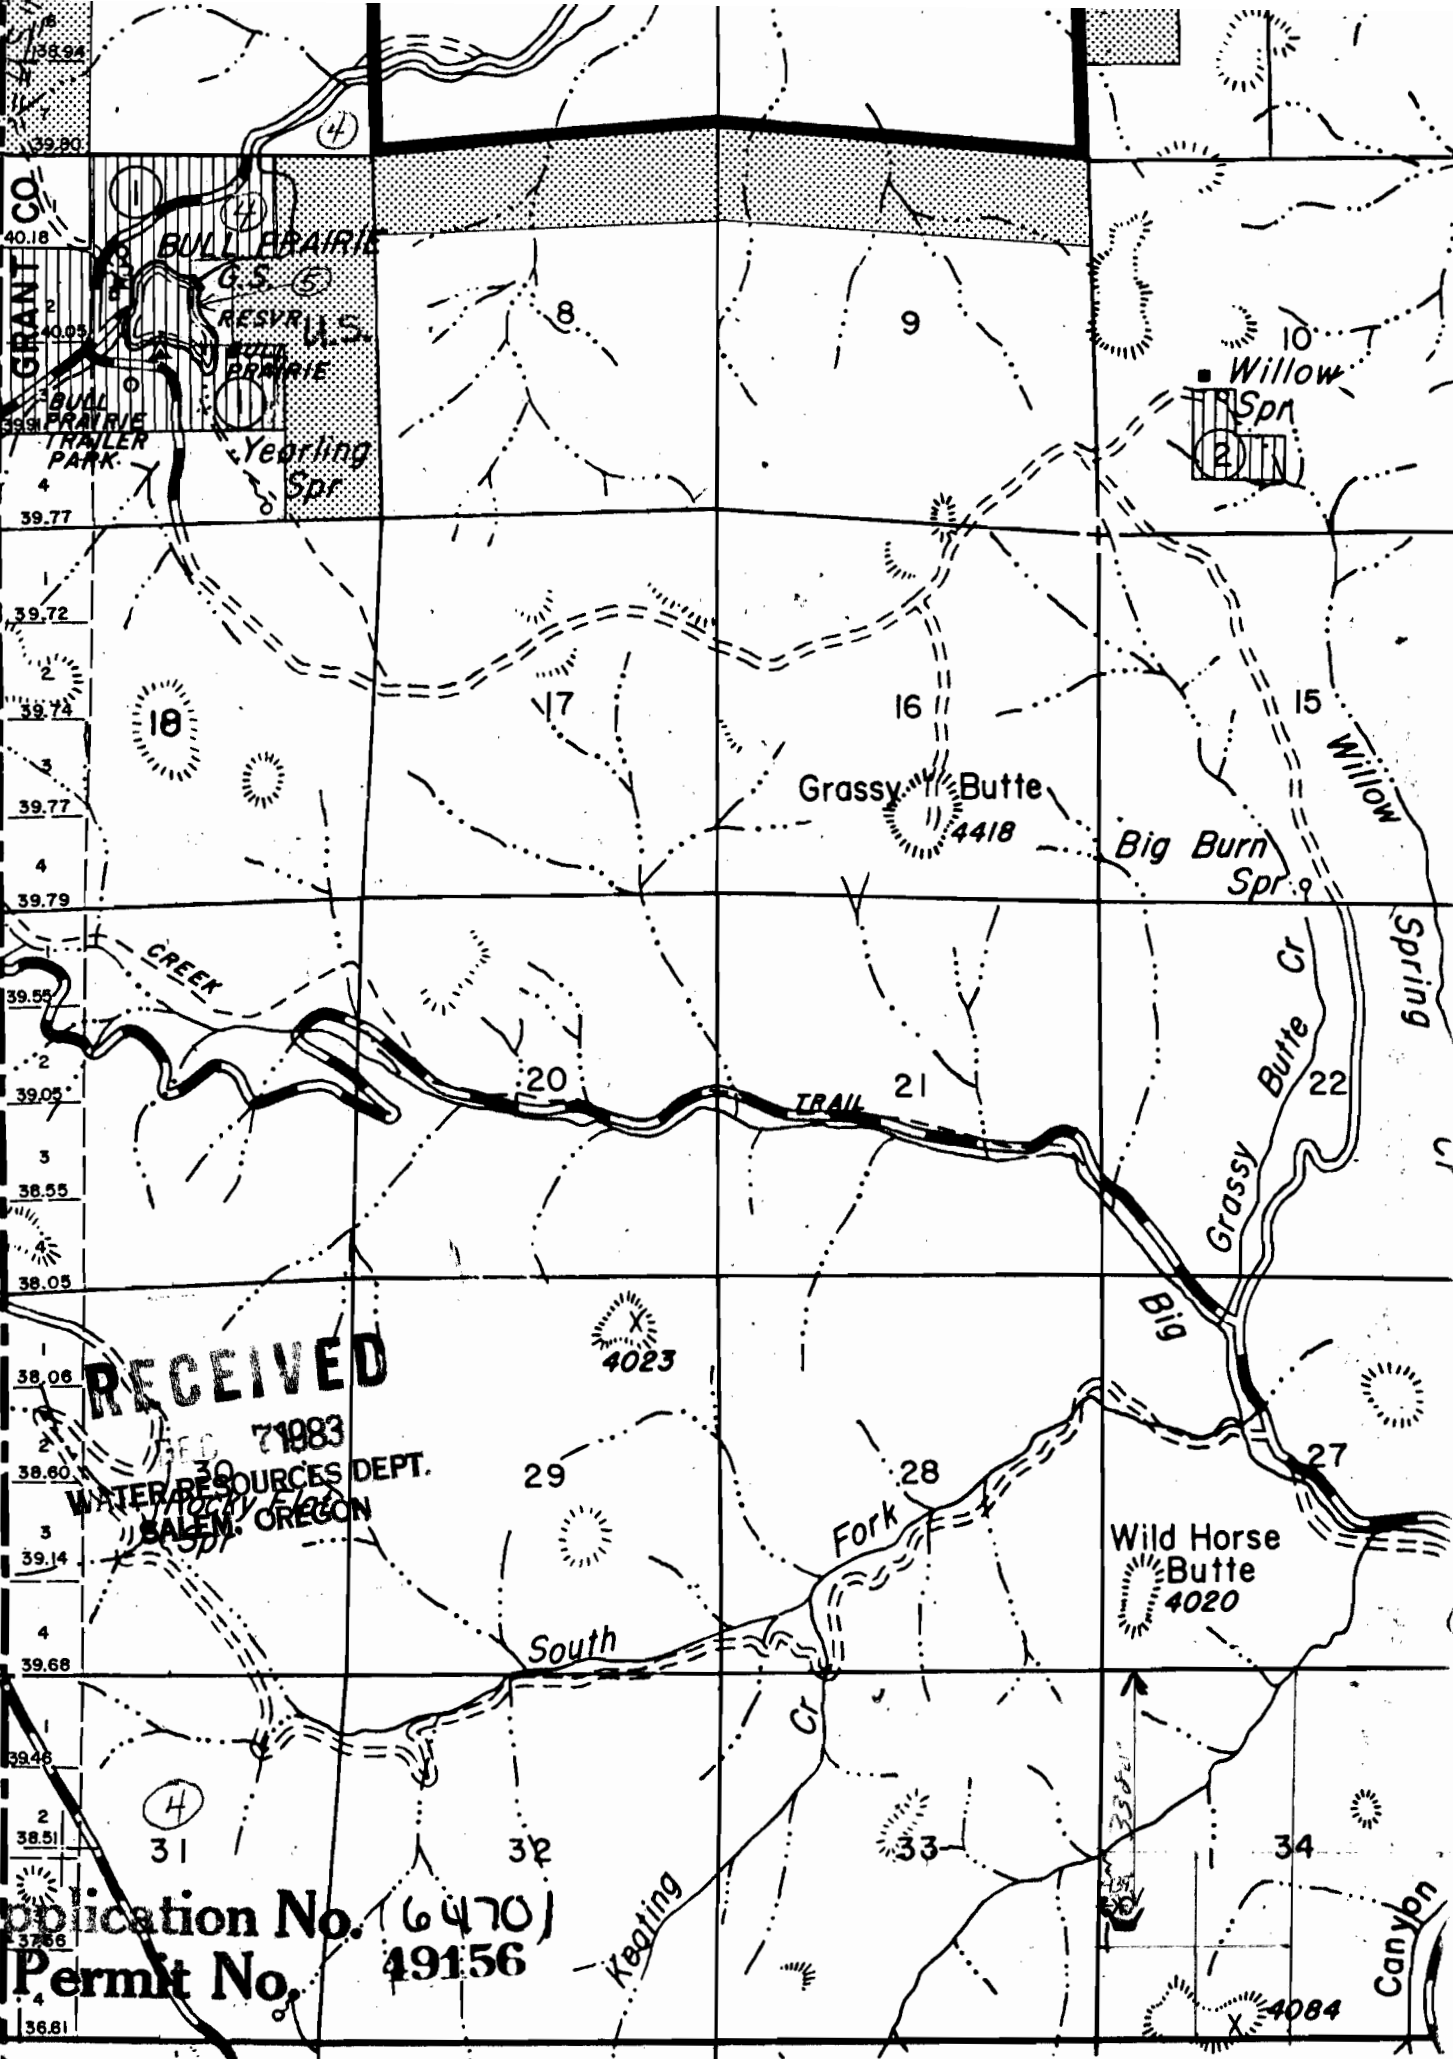

RECEIVED

7/19/83
OREGON DEPT. OF WATER RESOURCES
SALEM, OREGON

Application No. 6470
Permit No. 49156

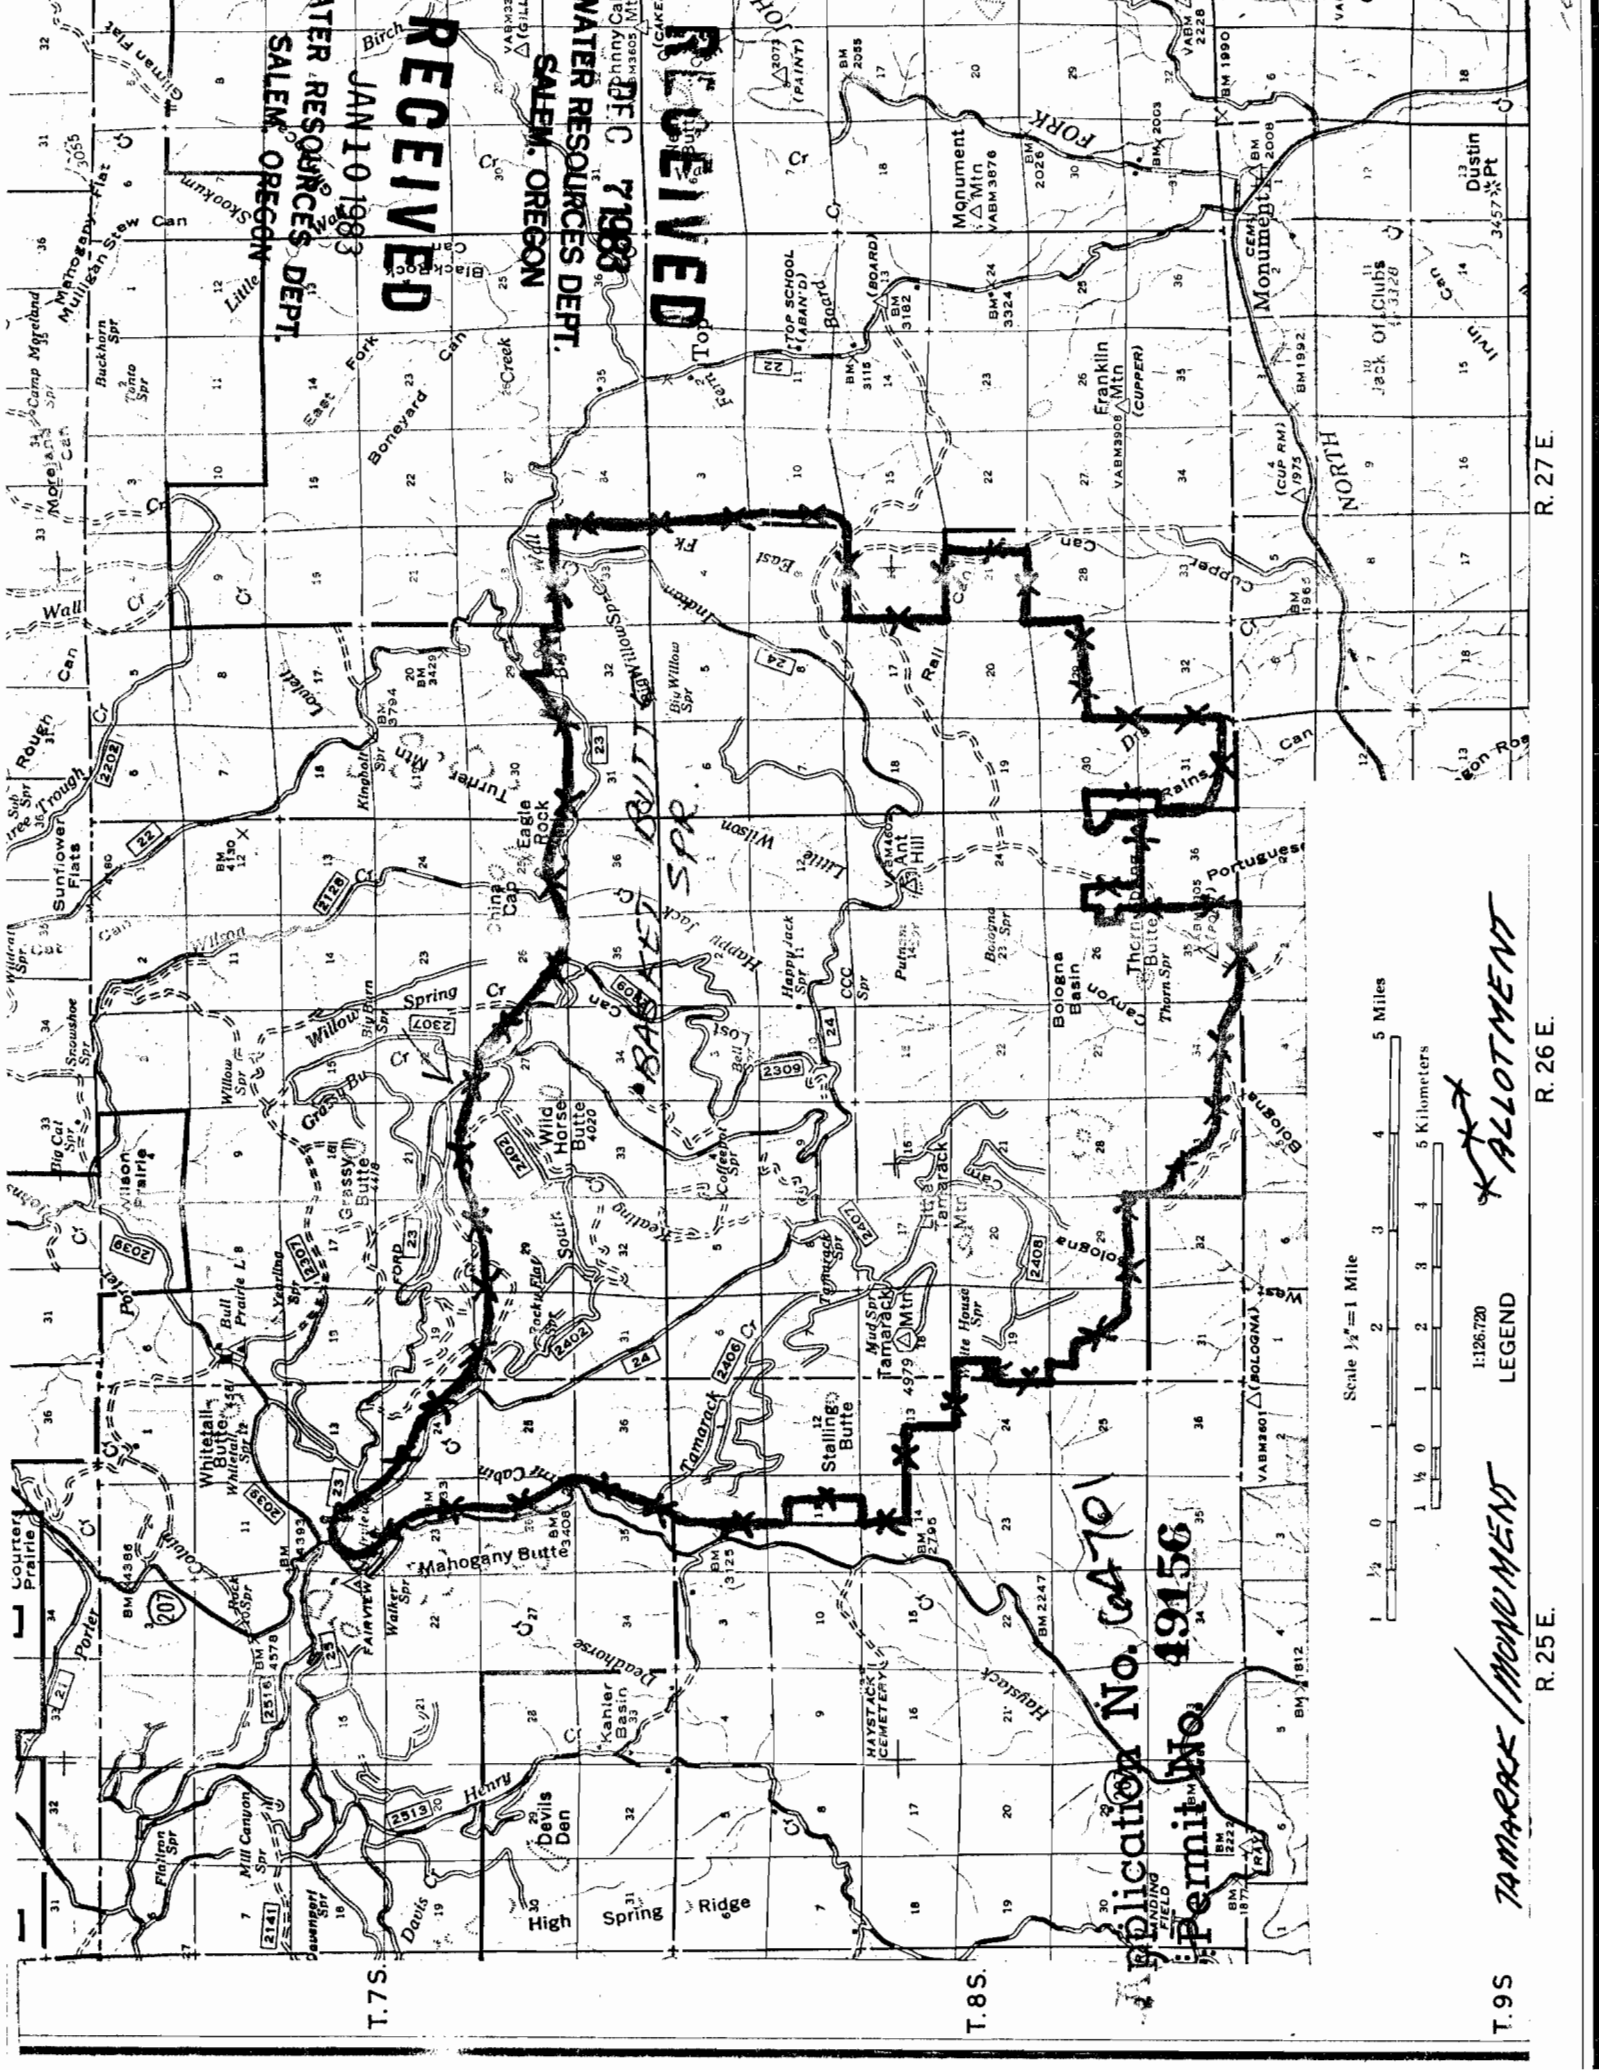

RECEIVED
JAN 10 1983
WATER RESOURCES DEPT.
SALEM, OREGON

RECEIVED
JAN 10 1983
WATER RESOURCES DEPT.
SALEM, OREGON

TOWNSHIP 7S, RANGE 26E, SECTION 34, W.M.

28	27
33	34

3380 FT

431 FT

RECEIVED
DEC 7 1983
WATER RESOURCES DEPT.
SALEM, OREGON

NAME Basket Butte Spring

COUNTY Grant

RECEIVED

JAN 10 1983

WATER RESOURCES DEPT.
SALEM, OREGON

Application No. 64701

Permit No. 49156