


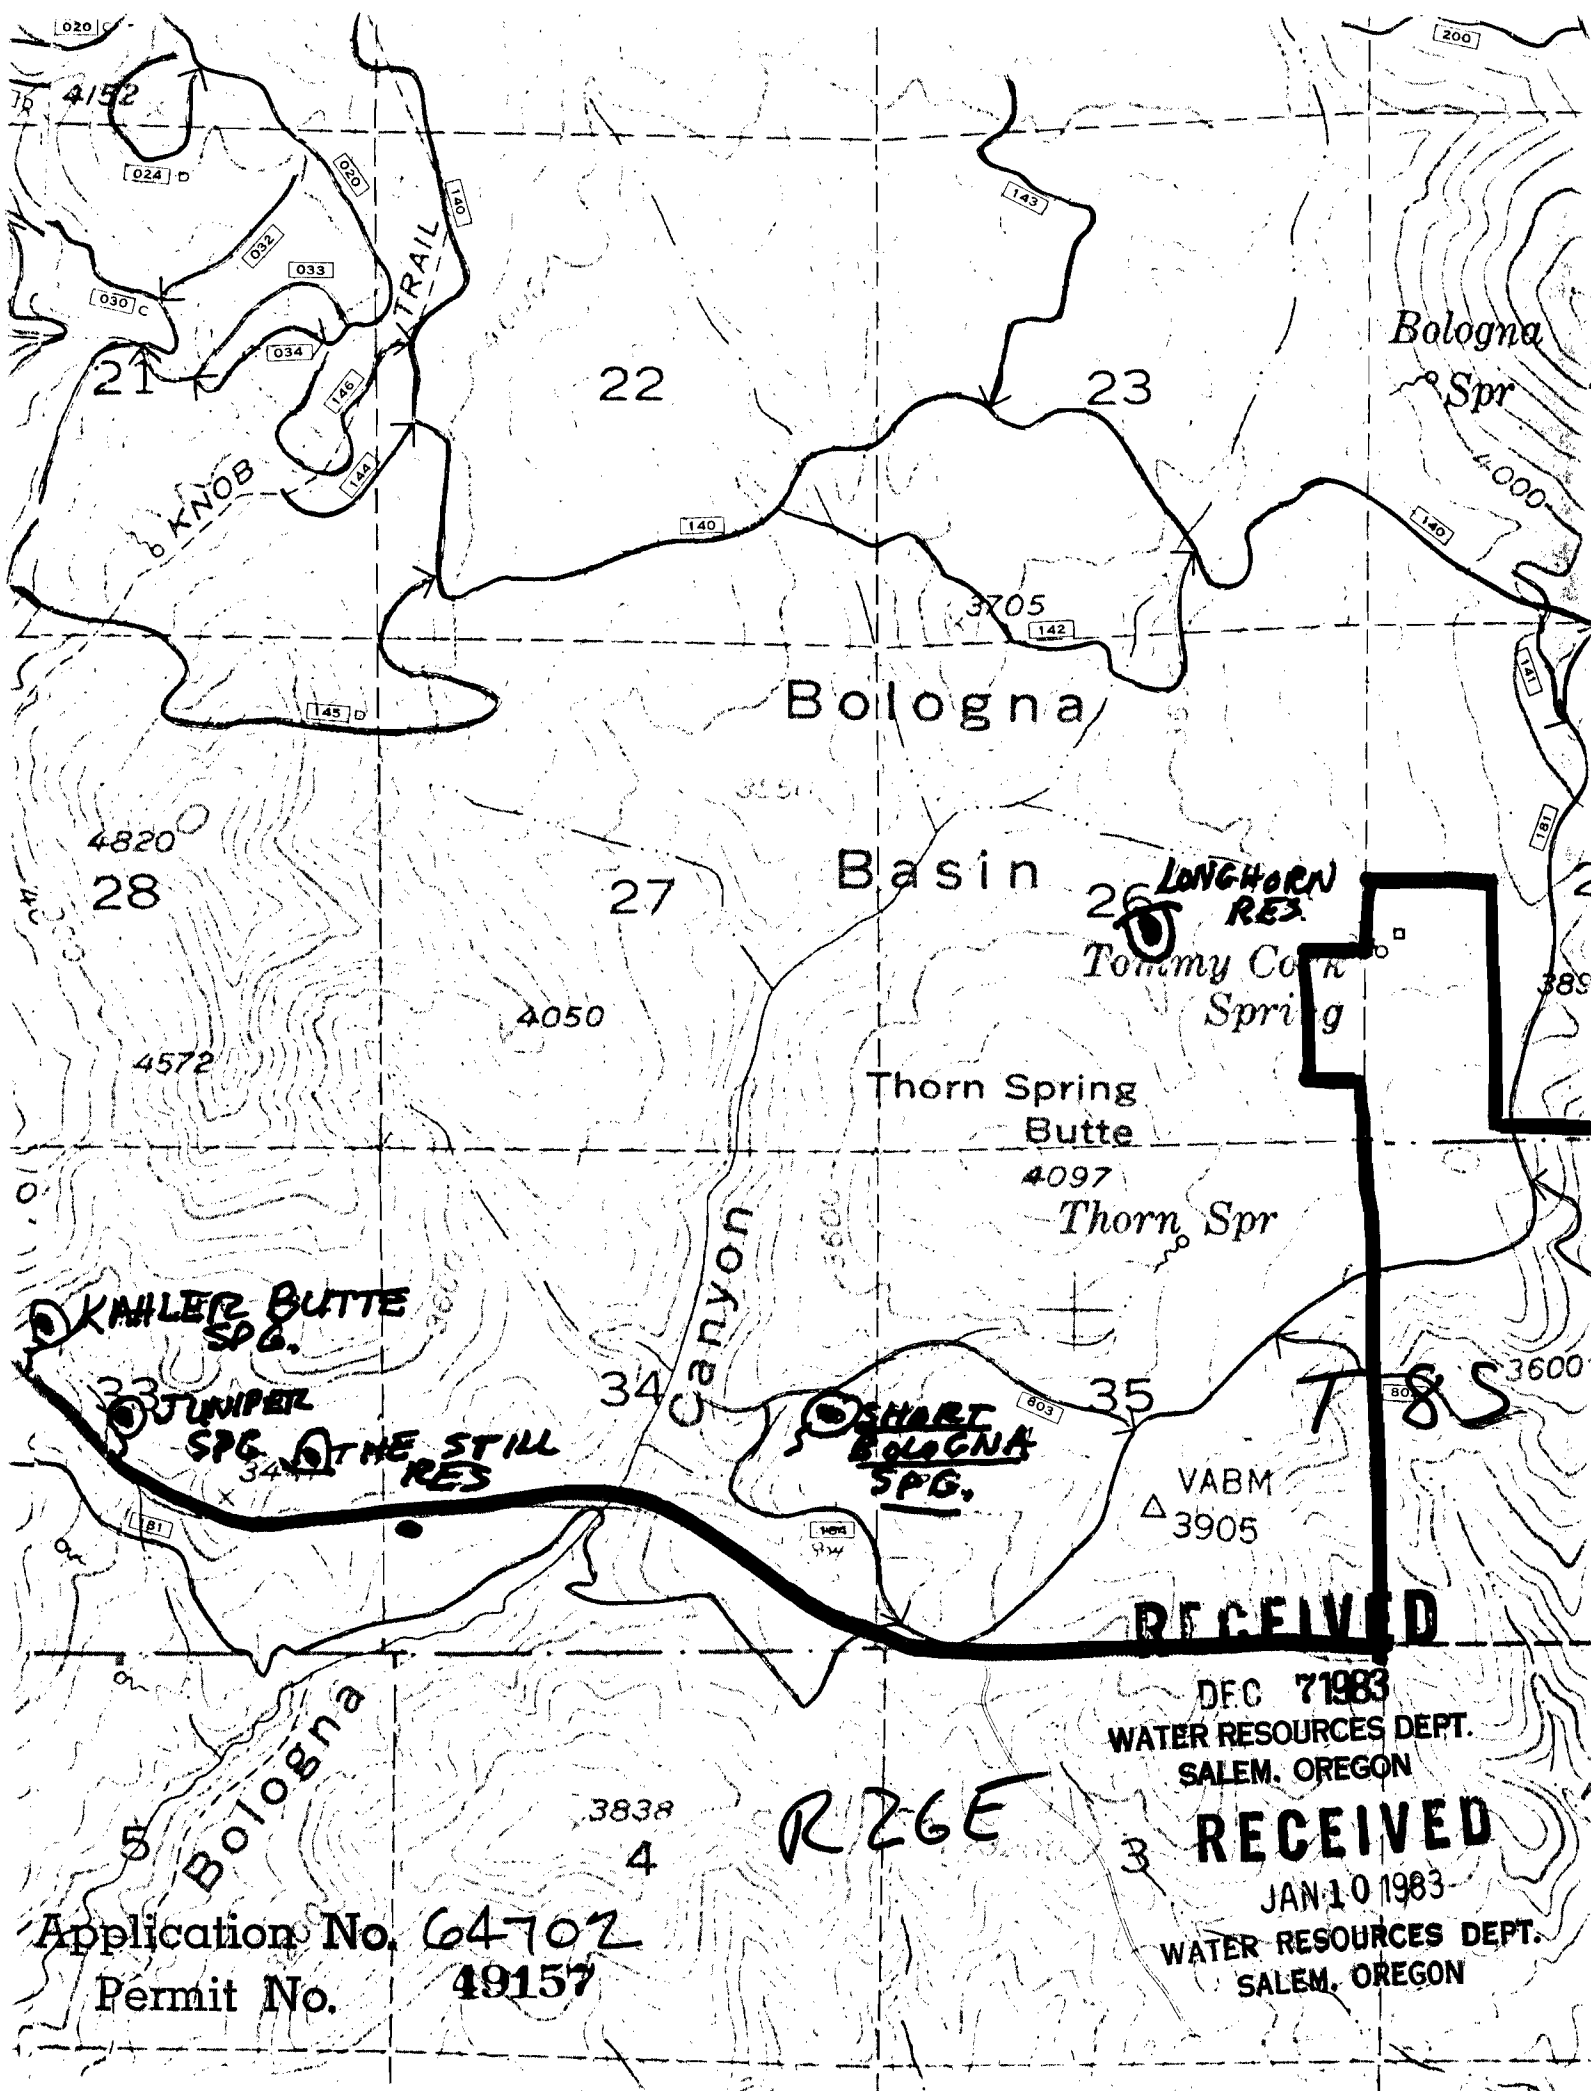


Application No. 64702
Permit No. 49157

R26E

DEC 7 1983
WATER RESOURCES DEPT.
SALEM, OREGON

3 RECEIVED
JAN 10 1983
WATER RESOURCES DEPT.
SALEM, OREGON

TOWNSHIP 8S, RANGE 26E, SECTION 34, W.M.

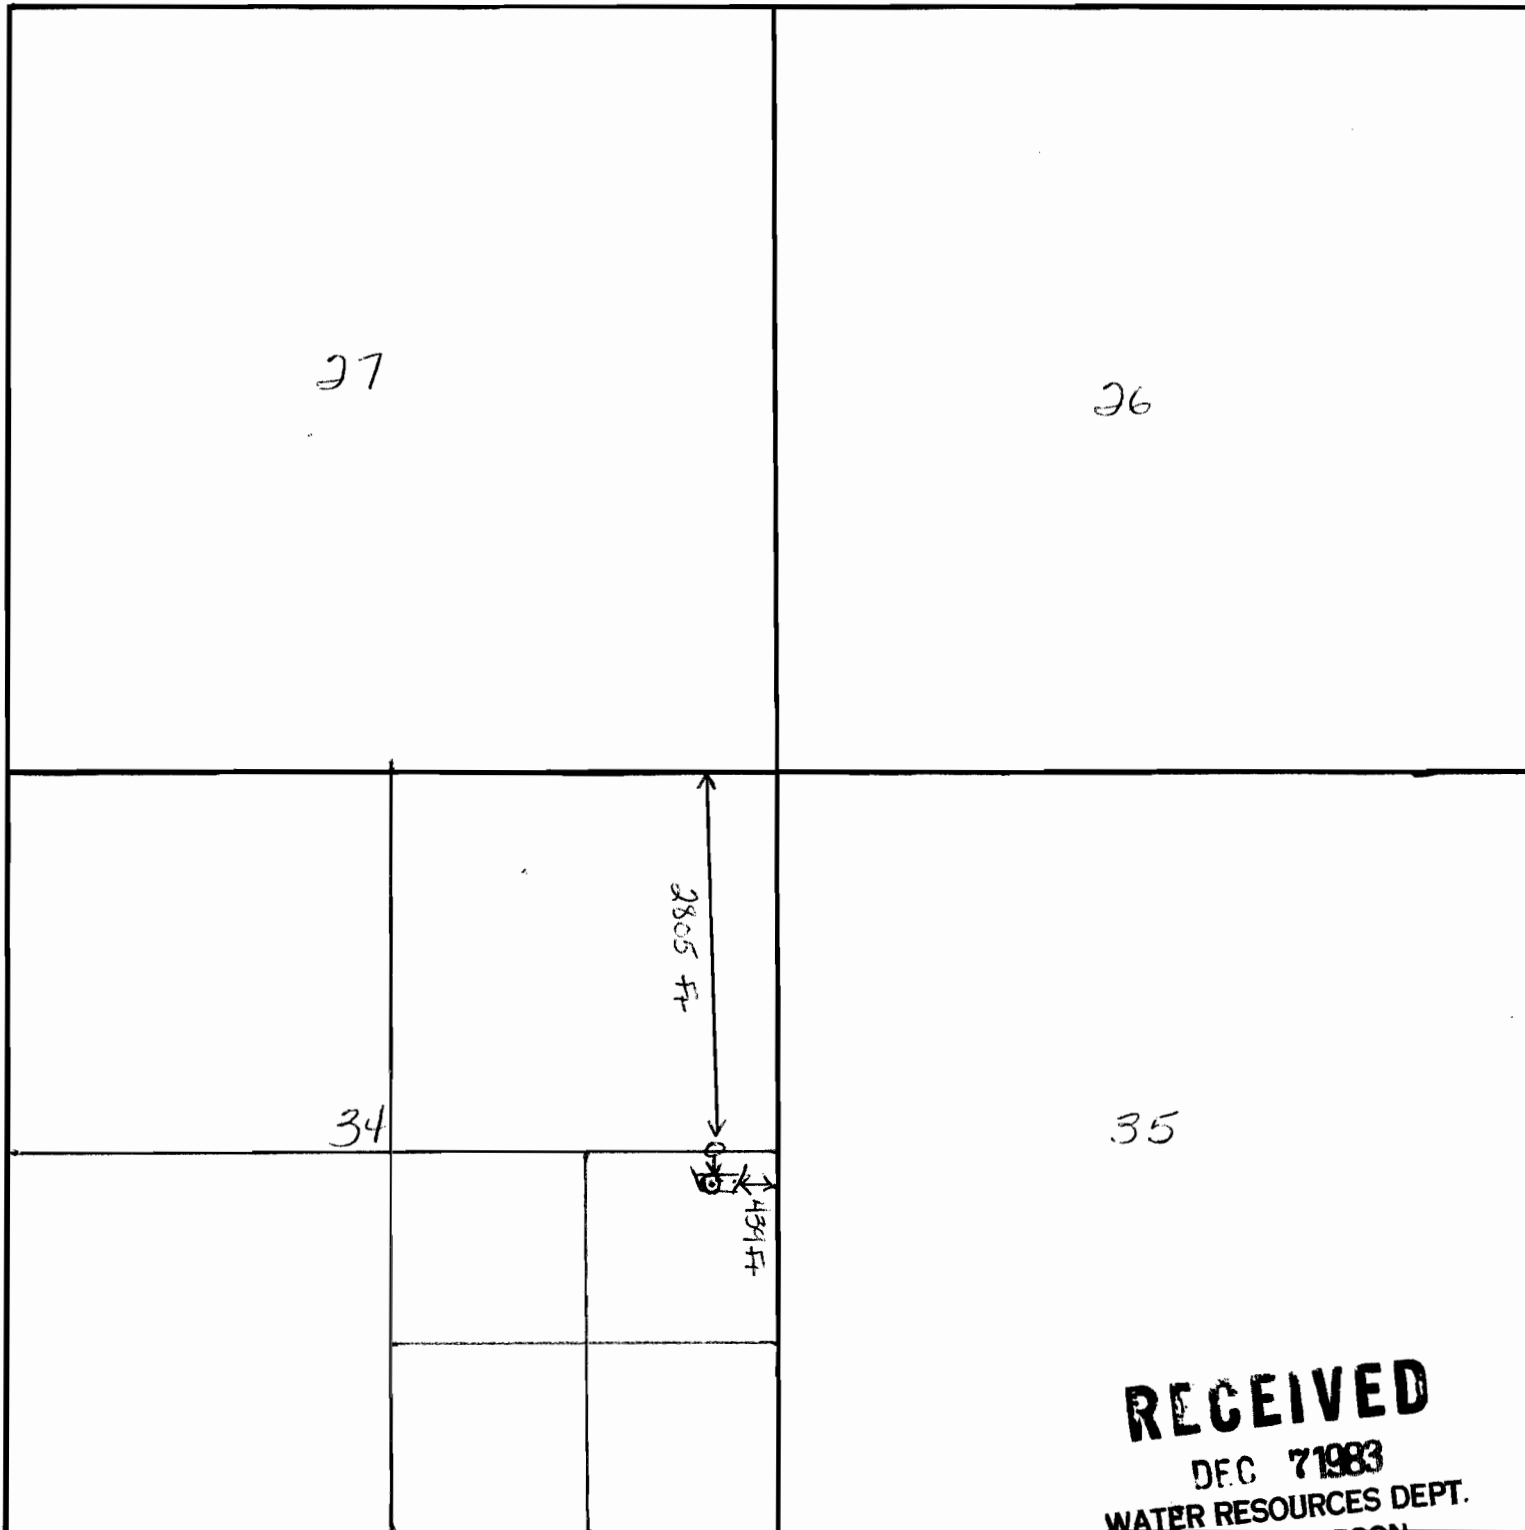

RECEIVED
DEC 7 1983
WATER RESOURCES DEPT.
SALEM, OREGON

NAME Short Bologna Spring COUNTY Grant

Application No. 64702

Permit No. 49157

RECEIVED
JAN 10 1983
WATER RESOURCES DEPT.
SALEM, OREGON