



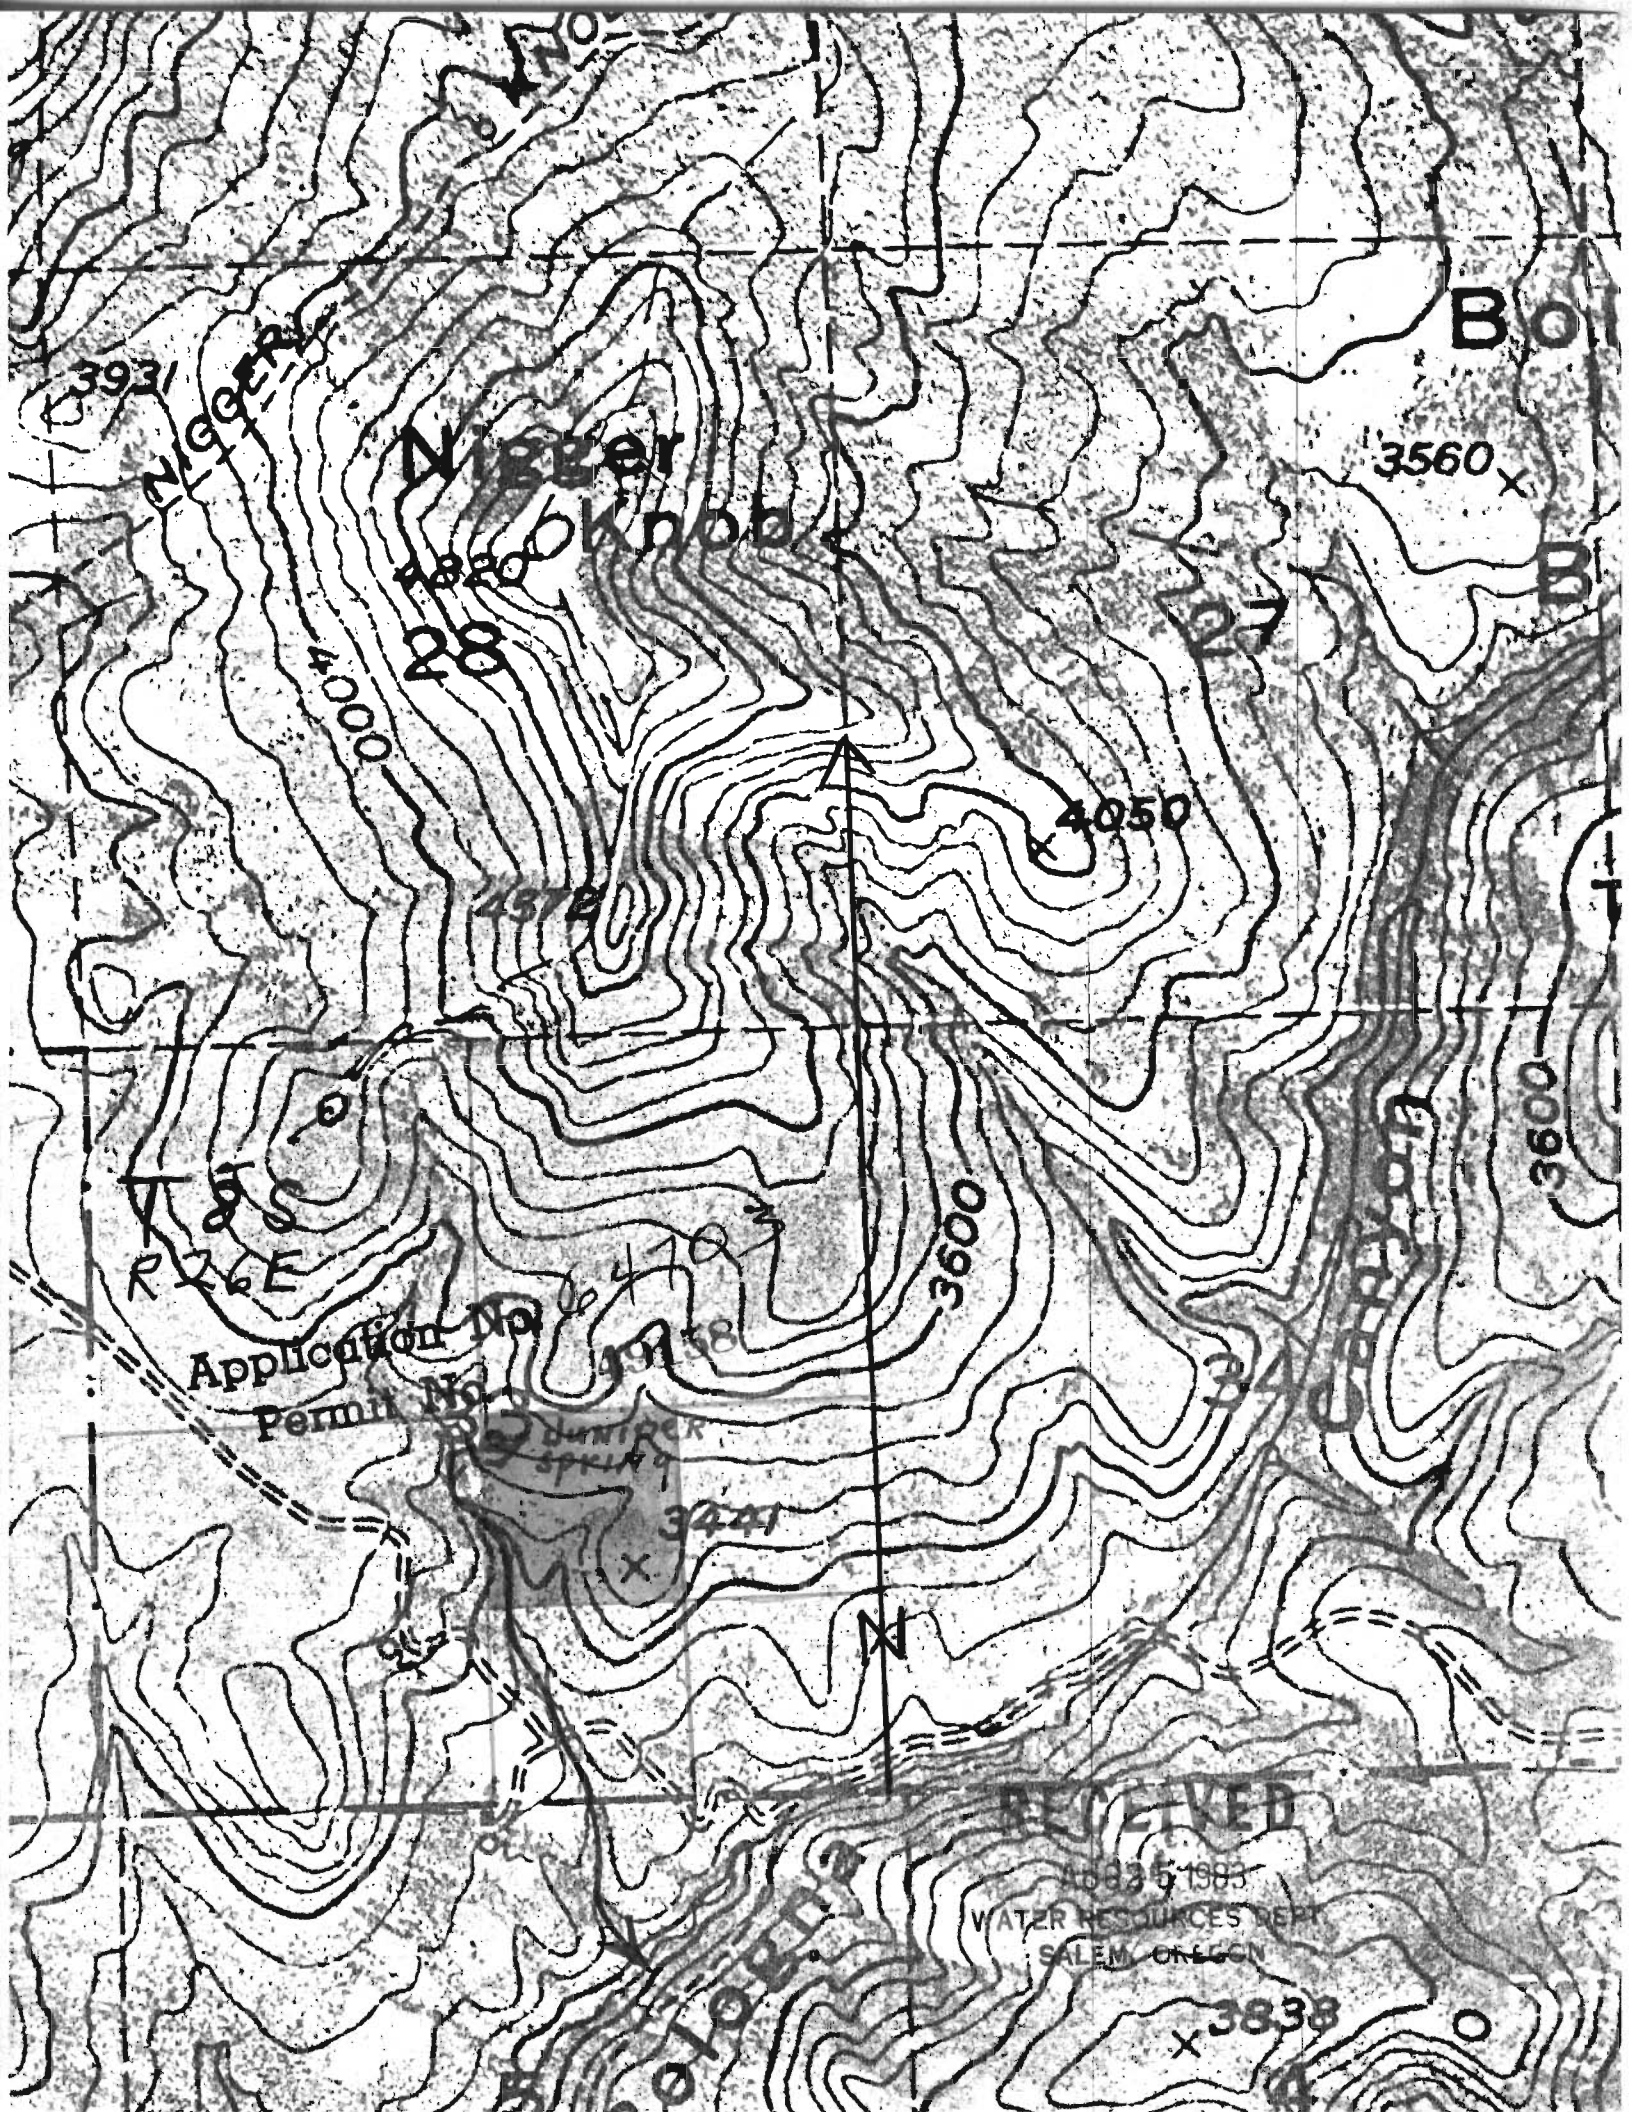


Application No.
Permit No.

RECEIVED

APR 25 1983
WATER RESOURCES DEPT
SALEM, OREGON

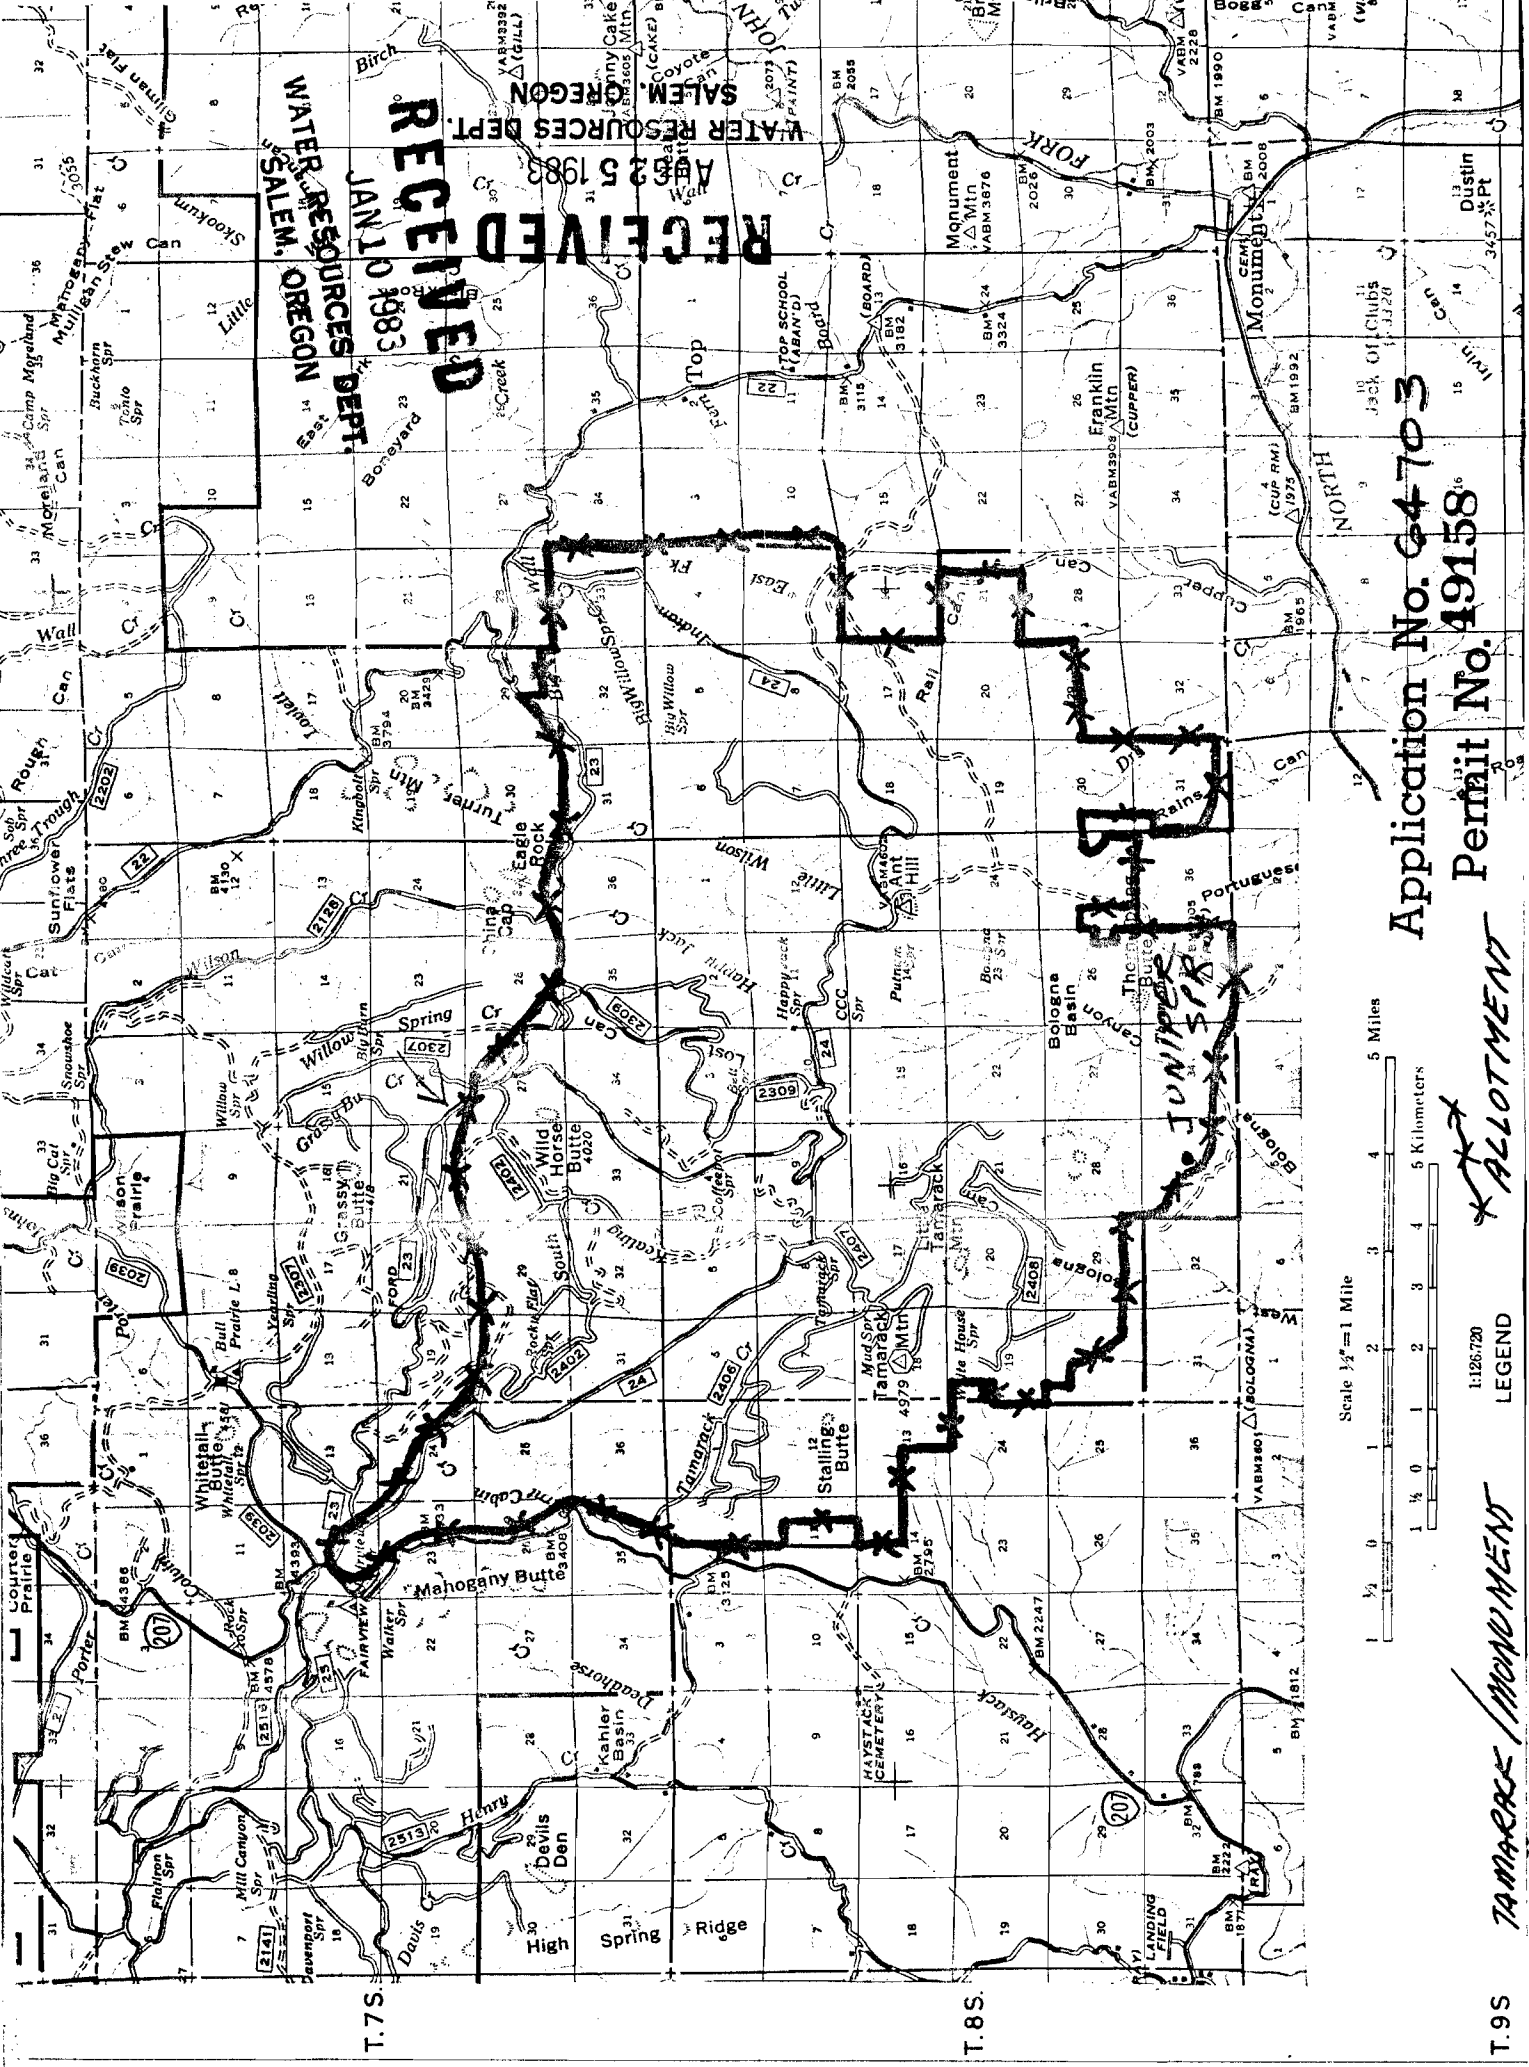

TOWNSHIP 8S, RANGE 26E, SECTION 33, W.M.

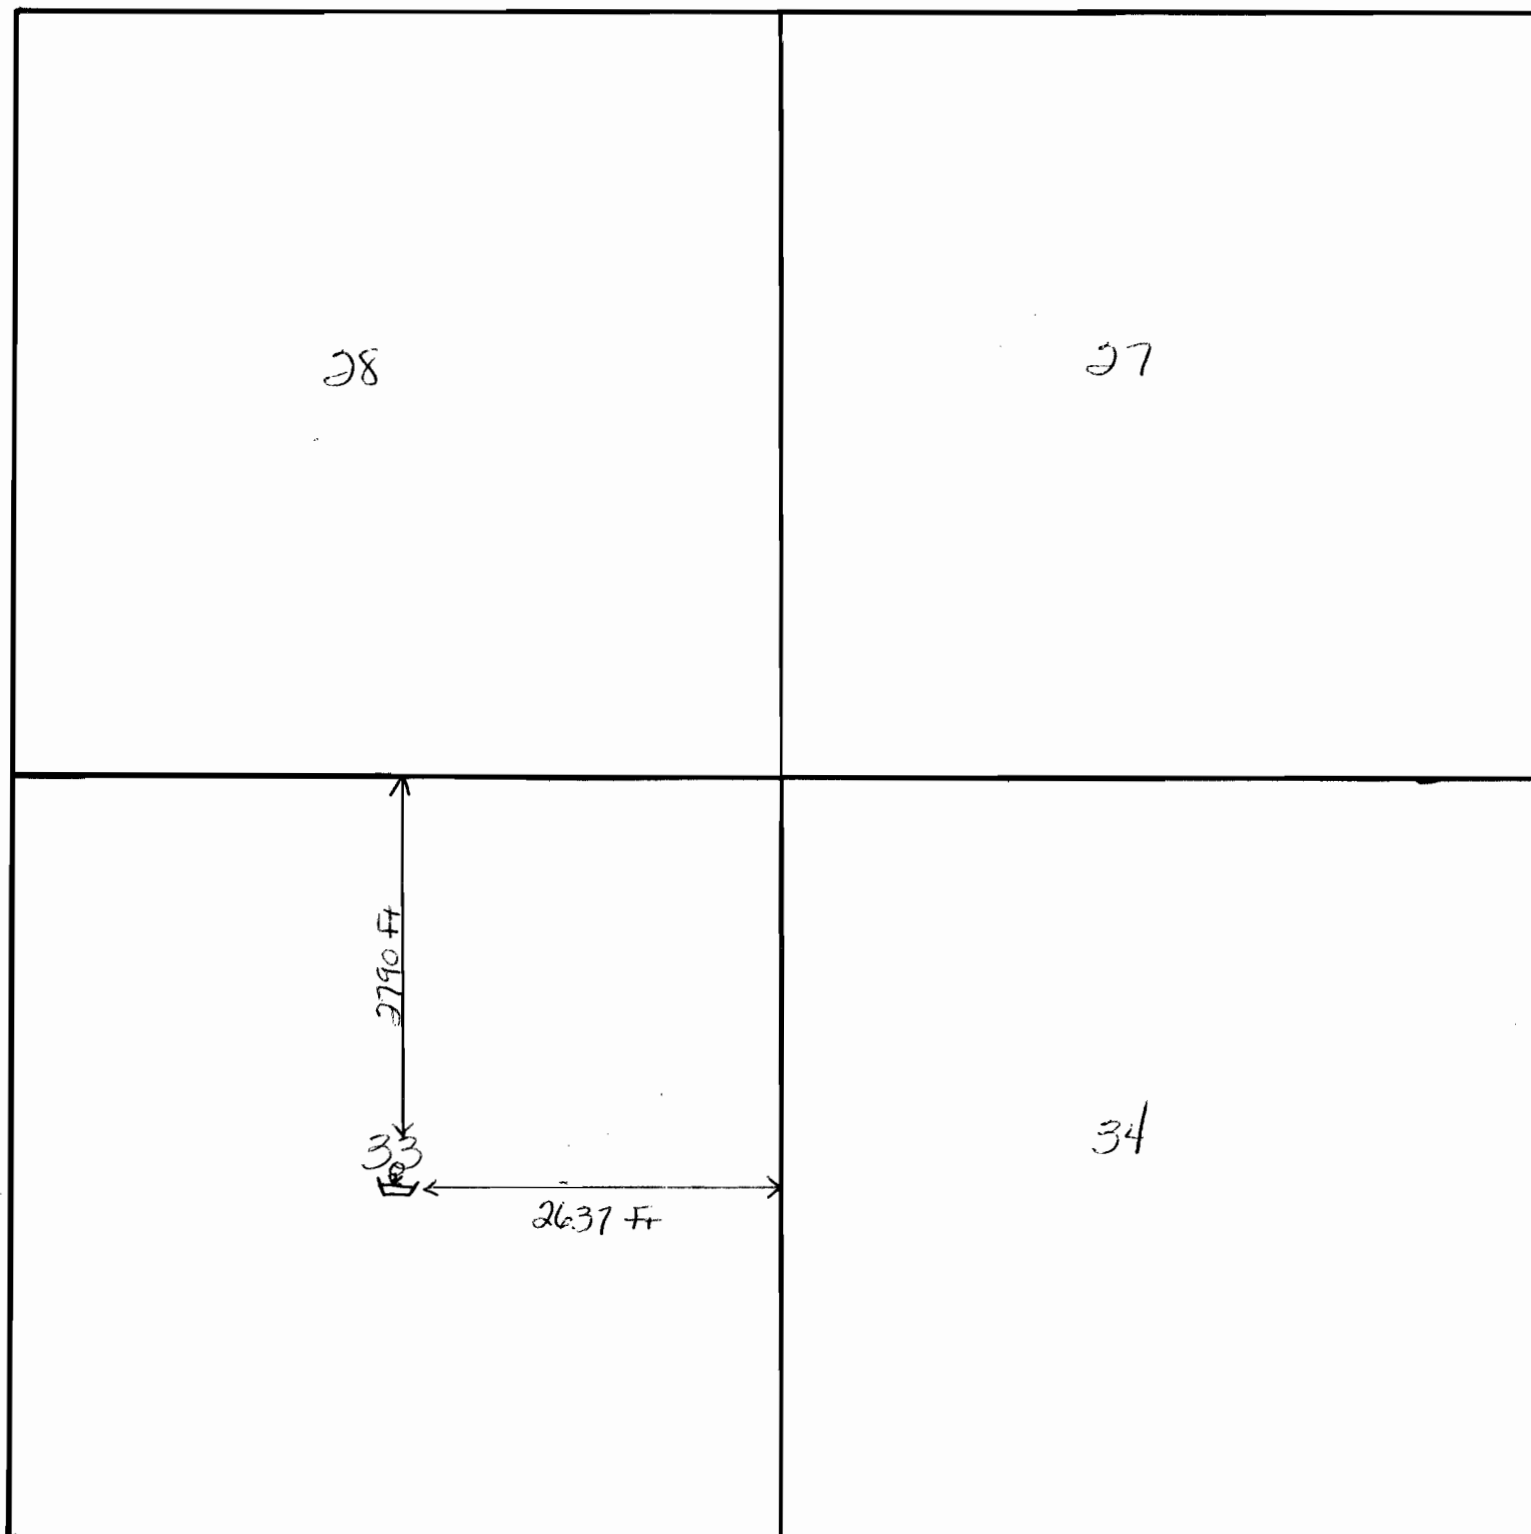

NAME Juniper Spring

COUNTY Grant

RECEIVED

JAN 10 1983

RECEIVED

WATER RESOURCES DEPT.

SALEM, OREGON

AUG 25 1983

WATER RESOURCES DEPT.

SALEM, OREGON

Application No. 64703

Permit No. 49158