

Kahler Butte Spring
T8S R26E section 33

N

Boiorana

Canyon

RECEIVED

1988
WATER RESOURCES DEPT.
SALEM, OREGON



Application No. 64709
Permit No. 49159

RECEIVED

MAY 14 1984
WATER RESOURCES DEPT.
SALEM, OREGON

Mitchell

8

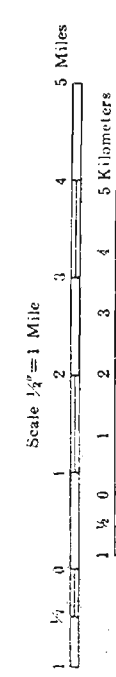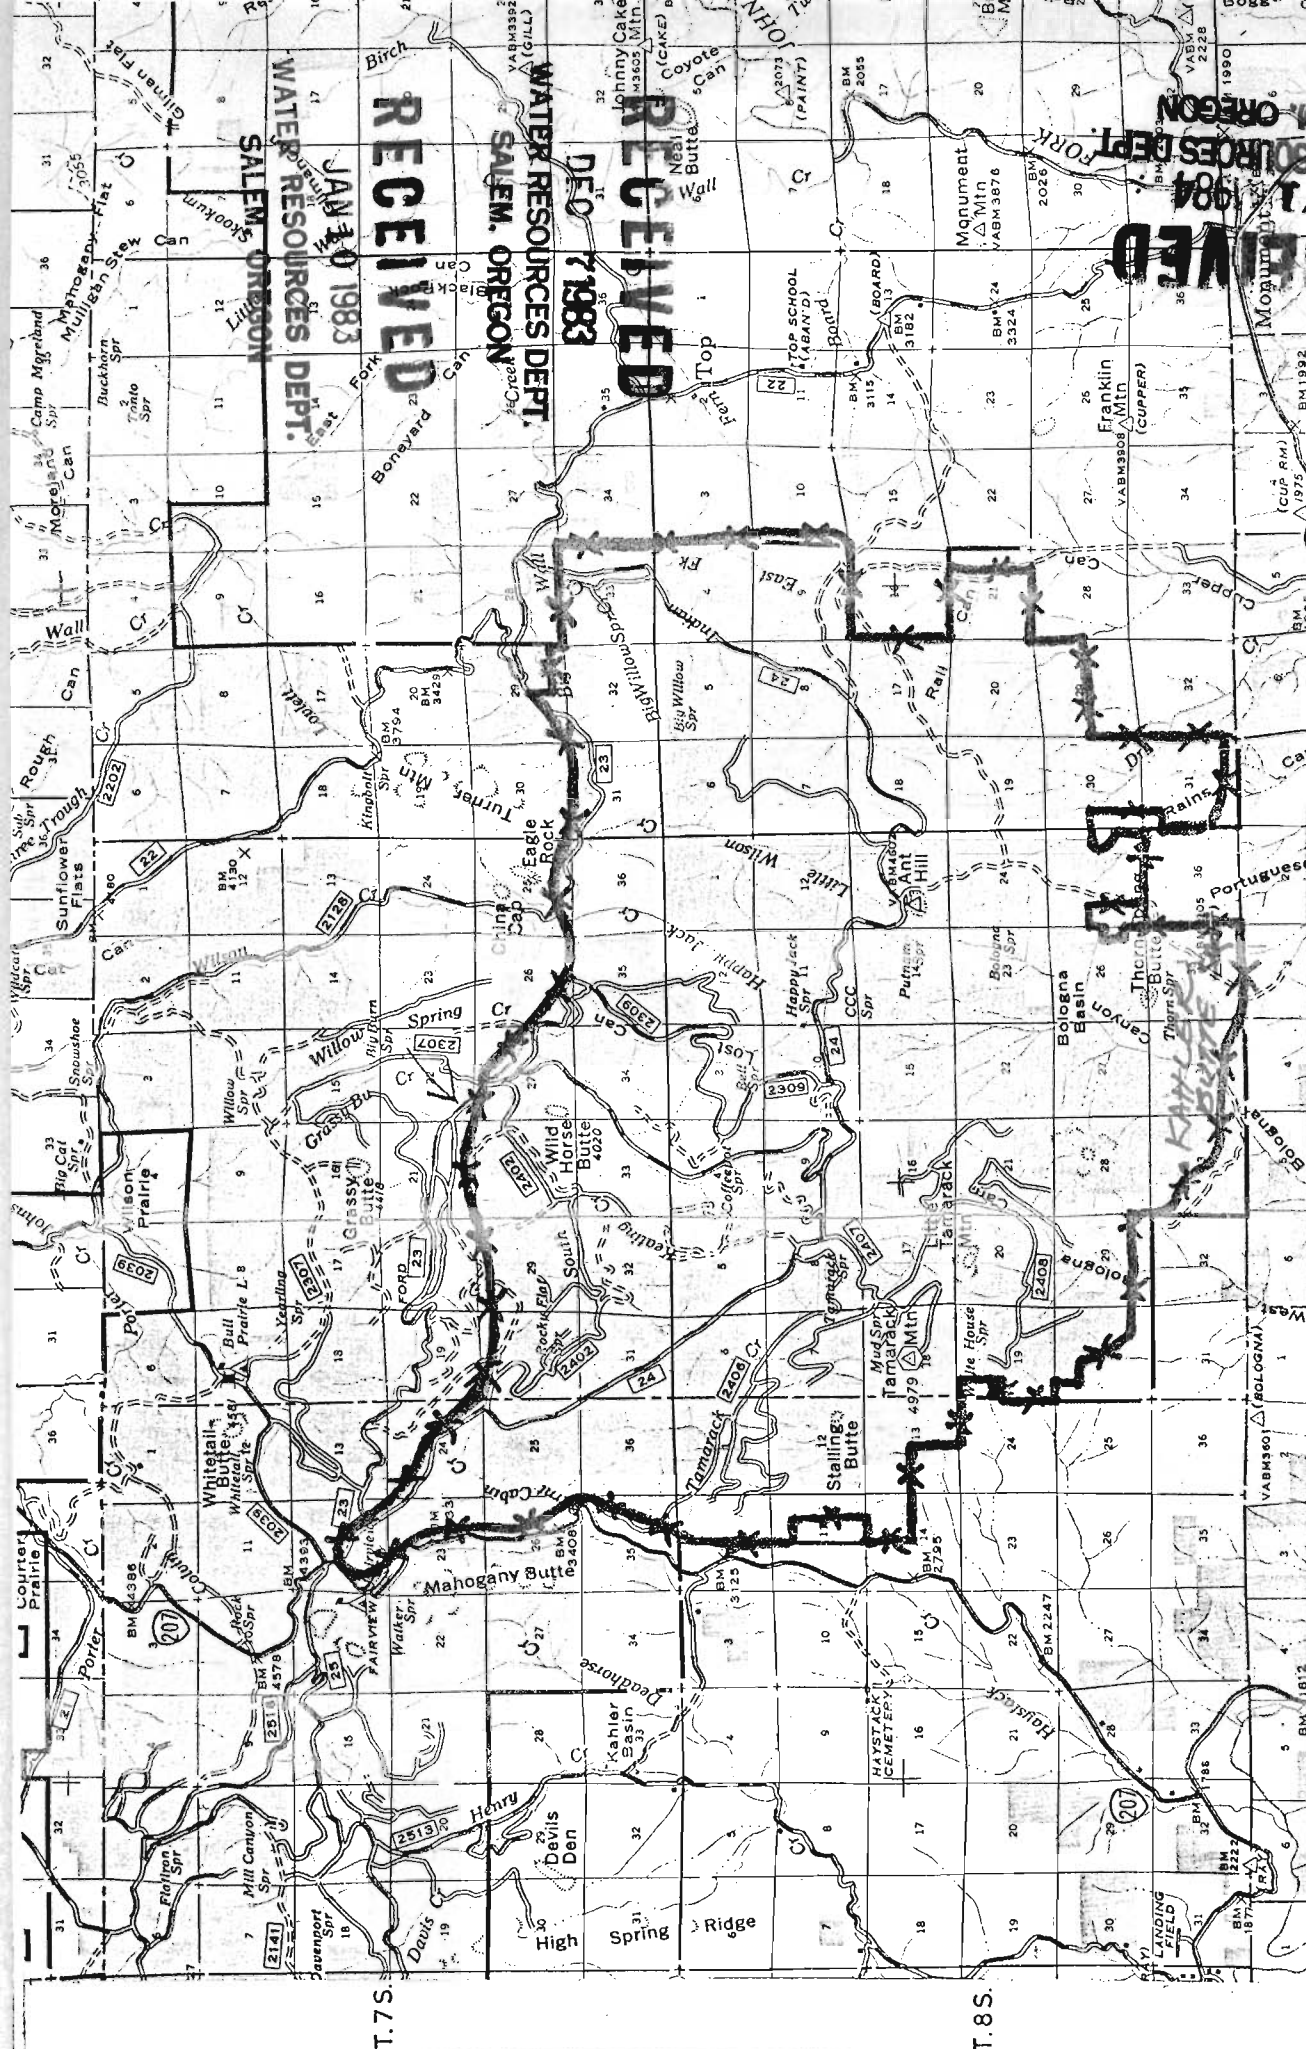

1:126,720
LEGEND

TAMARACK MONUMENT

T.9S

Application No. 49159

Permit No.

64-704

64-704

64-704

64-704

T.7S.

T.8S.

R. 25 E.

R. 26 E.

R. 27 E.

RECEIVED
JAN 30 1983
WATER RESOURCES DEPT.
SALEM, OREGON

RECEIVED
DEC 7 1983
WATER RESOURCES DEPT.
SALEM, OREGON

RECEIVED
MAY 1 1984
WATER RESOURCES DEPT.
SALEM, OREGON

WHEELER

GRANT

Mud Spr

Tamarack Spr

Bell Spring

White House Spr

Little Tamarack Mtn

RECEIVED

NOV 7 1983
WATER RESOURCES DEPT.
SALEM, OREGON

Nigger Knob

RECEIVED

MAY 14 1984

WATER RESOURCES DEPT.
SALEM, OREGON

Kahler Butte


Application No. 64764
Permit No 49159

Bologna

Bologna

Canyon

Th

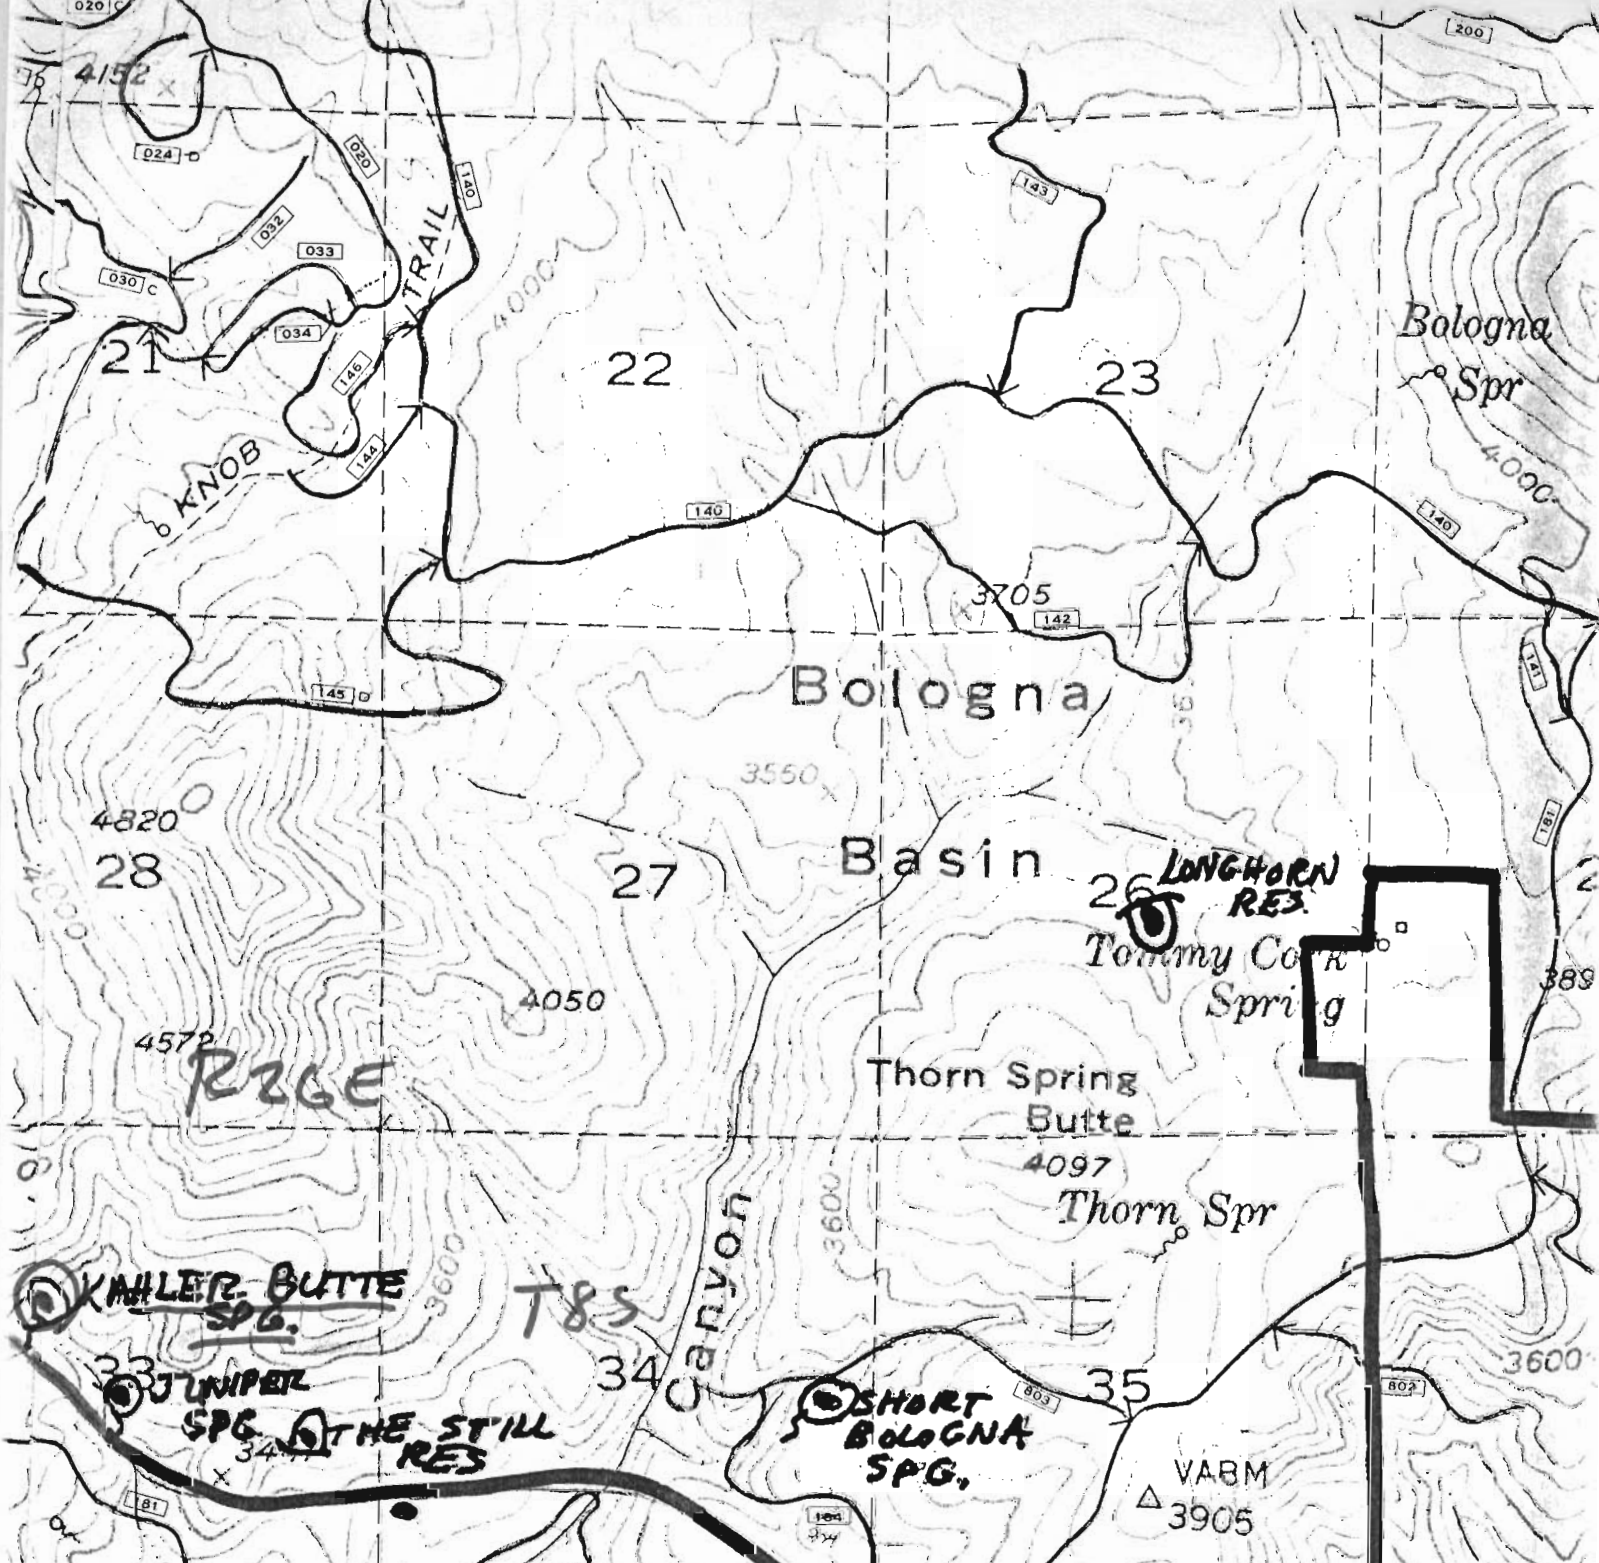

RECEIVED

DEC 7 1983

WATER RESOURCES DEPT.
SALEM, OREGON

RECEIVED

MAY 1 1984

WATER RESOURCES DEPT.
SALEM, OREGON

RECEIVED

JAN 10 1983

WATER RESOURCES DEPT.
SALEM, OREGON

Application No. 64704

Permit No. 49159

TOWNSHIP 8S, RANGE 26E, SECTION 33, W.M.


29

28

32

RECEIVED

MAY 14 1984
WATER RESOURCES DEPT.
SALEM, OREGON

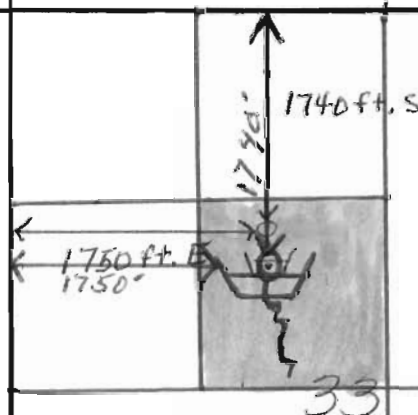

RECEIVED

DEC 7 1983
WATER RESOURCES DEPT.
SALEM, OREGON

NAME Kahler Butte Spring COUNTY Grant

RECEIVED

JAN 10 1983

WATER RESOURCES DEPT.
SALEM, OREGON

Application No. 64704

Permit No. 49159