

3688

34

35

36

4084

T8S
R26E
sect 11

3600

3955

3600

3

2

1

Spring

10000

Permit No. 49160

Happy Jack
Spr


10

11

12

4800 CCC Spr

N

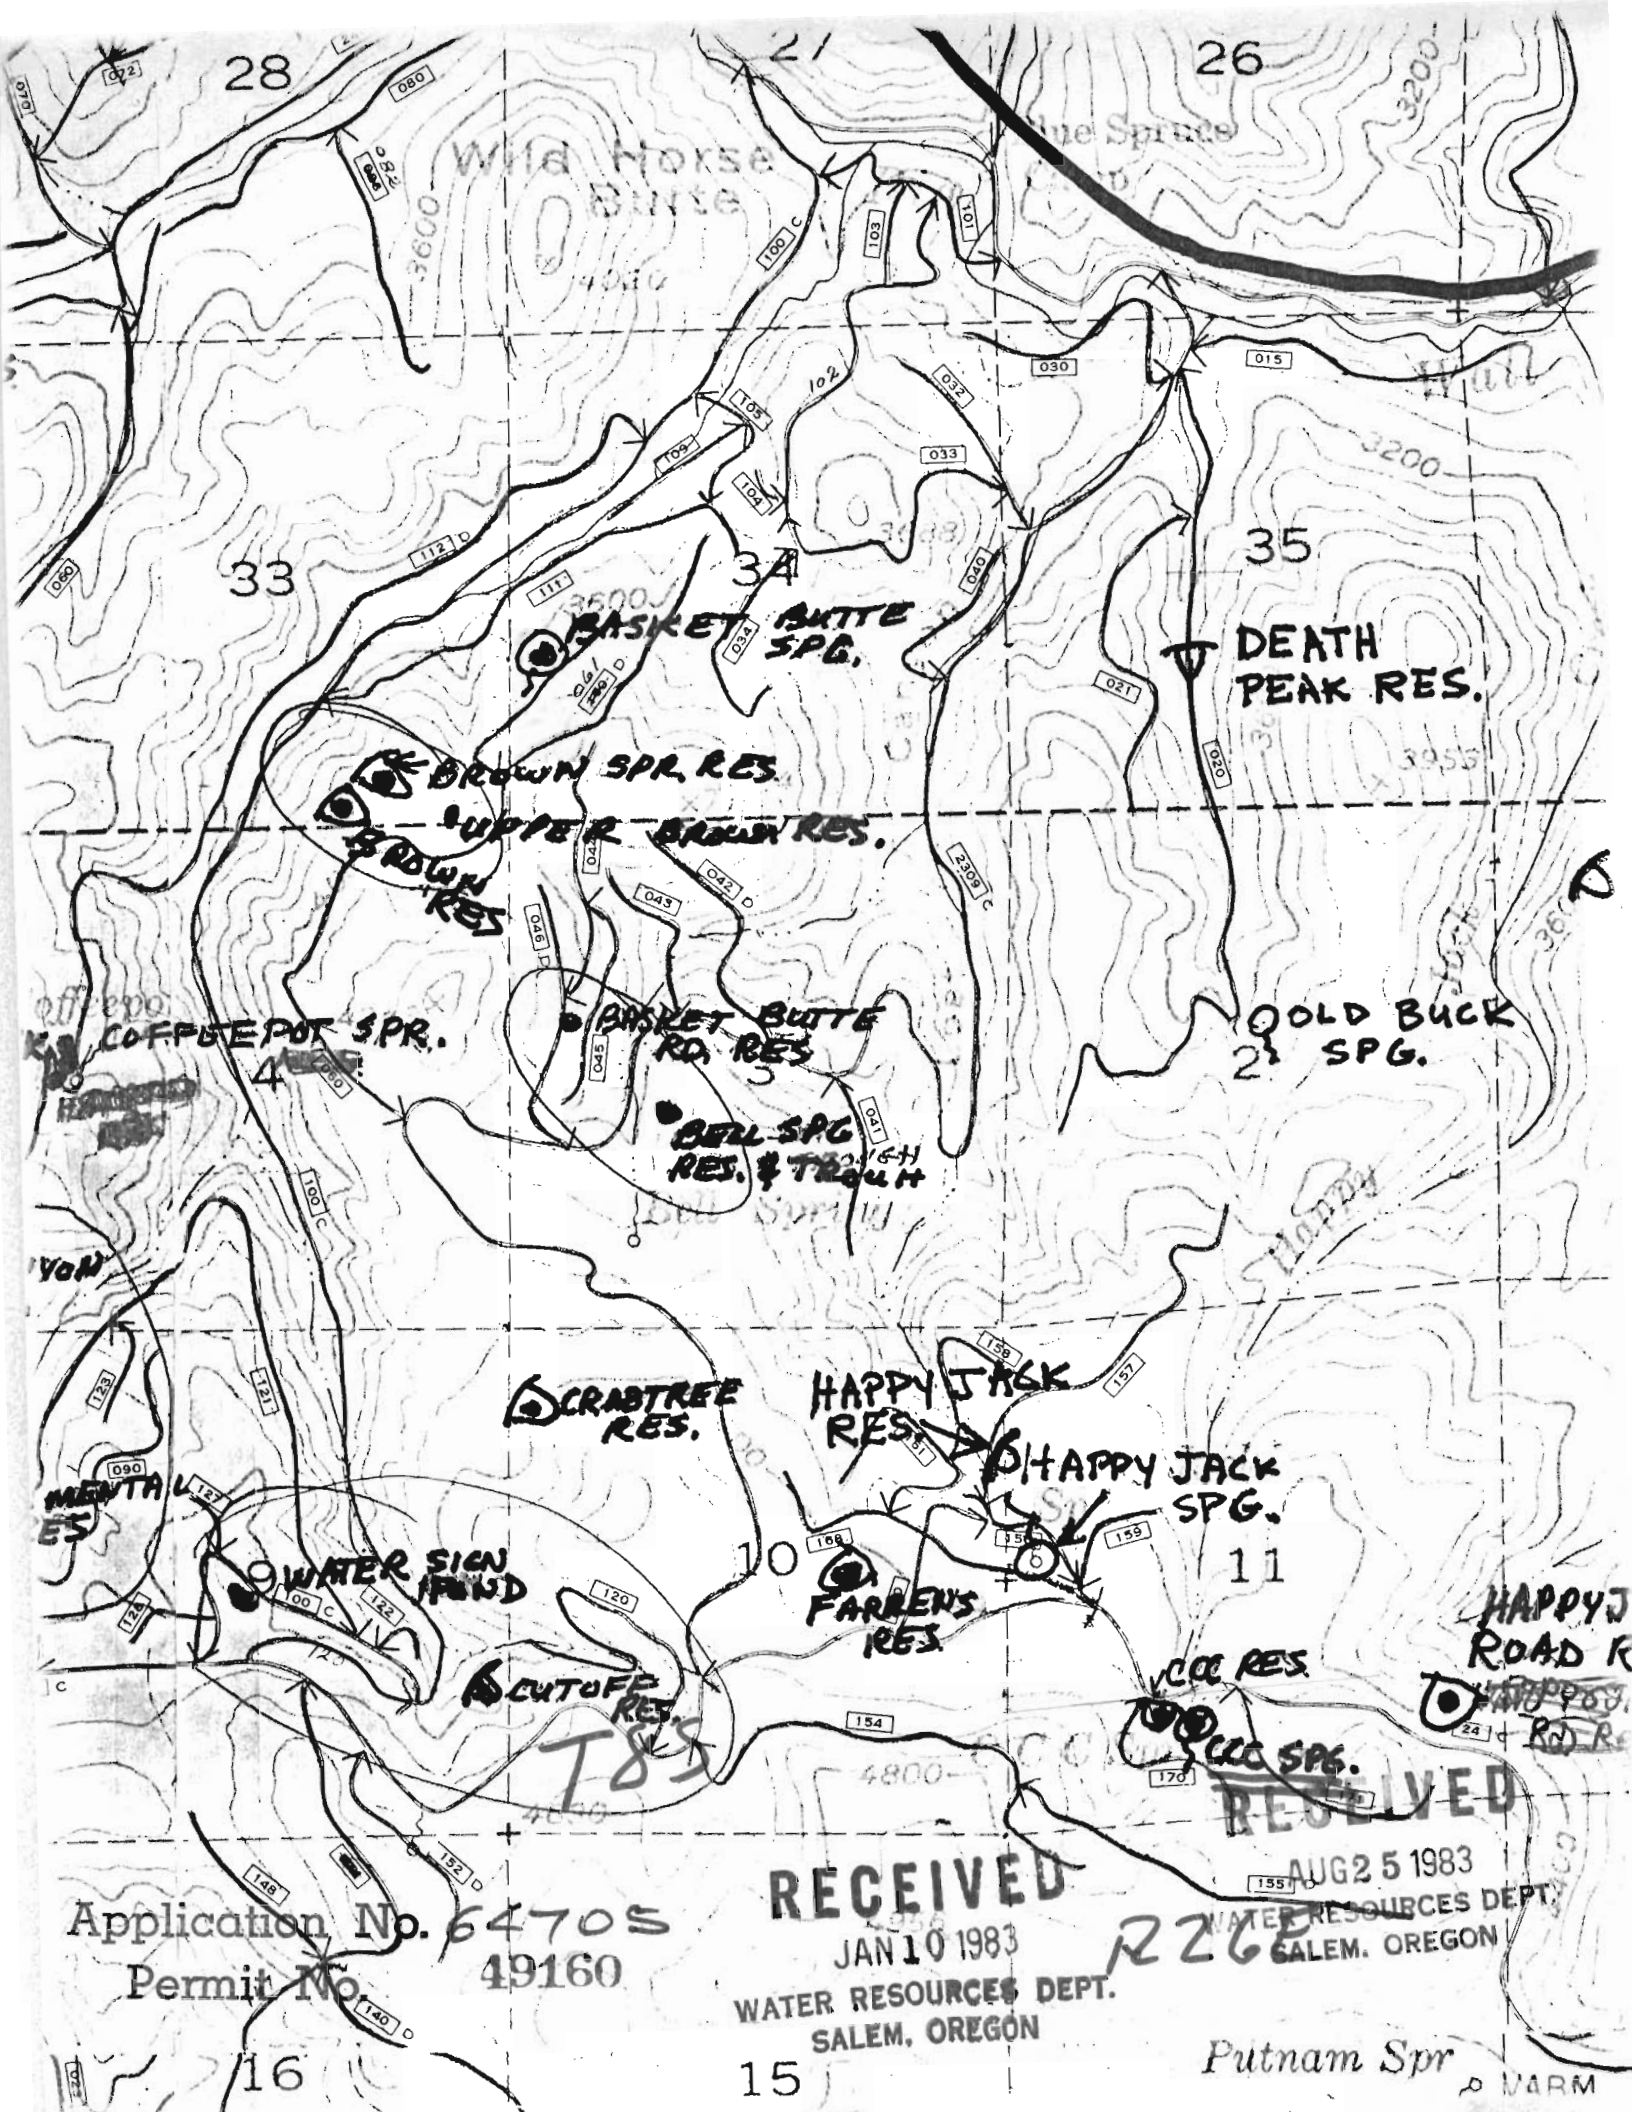

Application No. 64705
Permit No. 49160


RECEIVED
JAN 10 1983
WATER RESOURCES DEPT.
SALEM, OREGON

RECEIVED
AUG 25 1983
WATER RESOURCES DEPT.
SALEM, OREGON

Putnam Spr

WARM

TOWNSHIP 8S, RANGE 26E, SECTION 11, W.M.

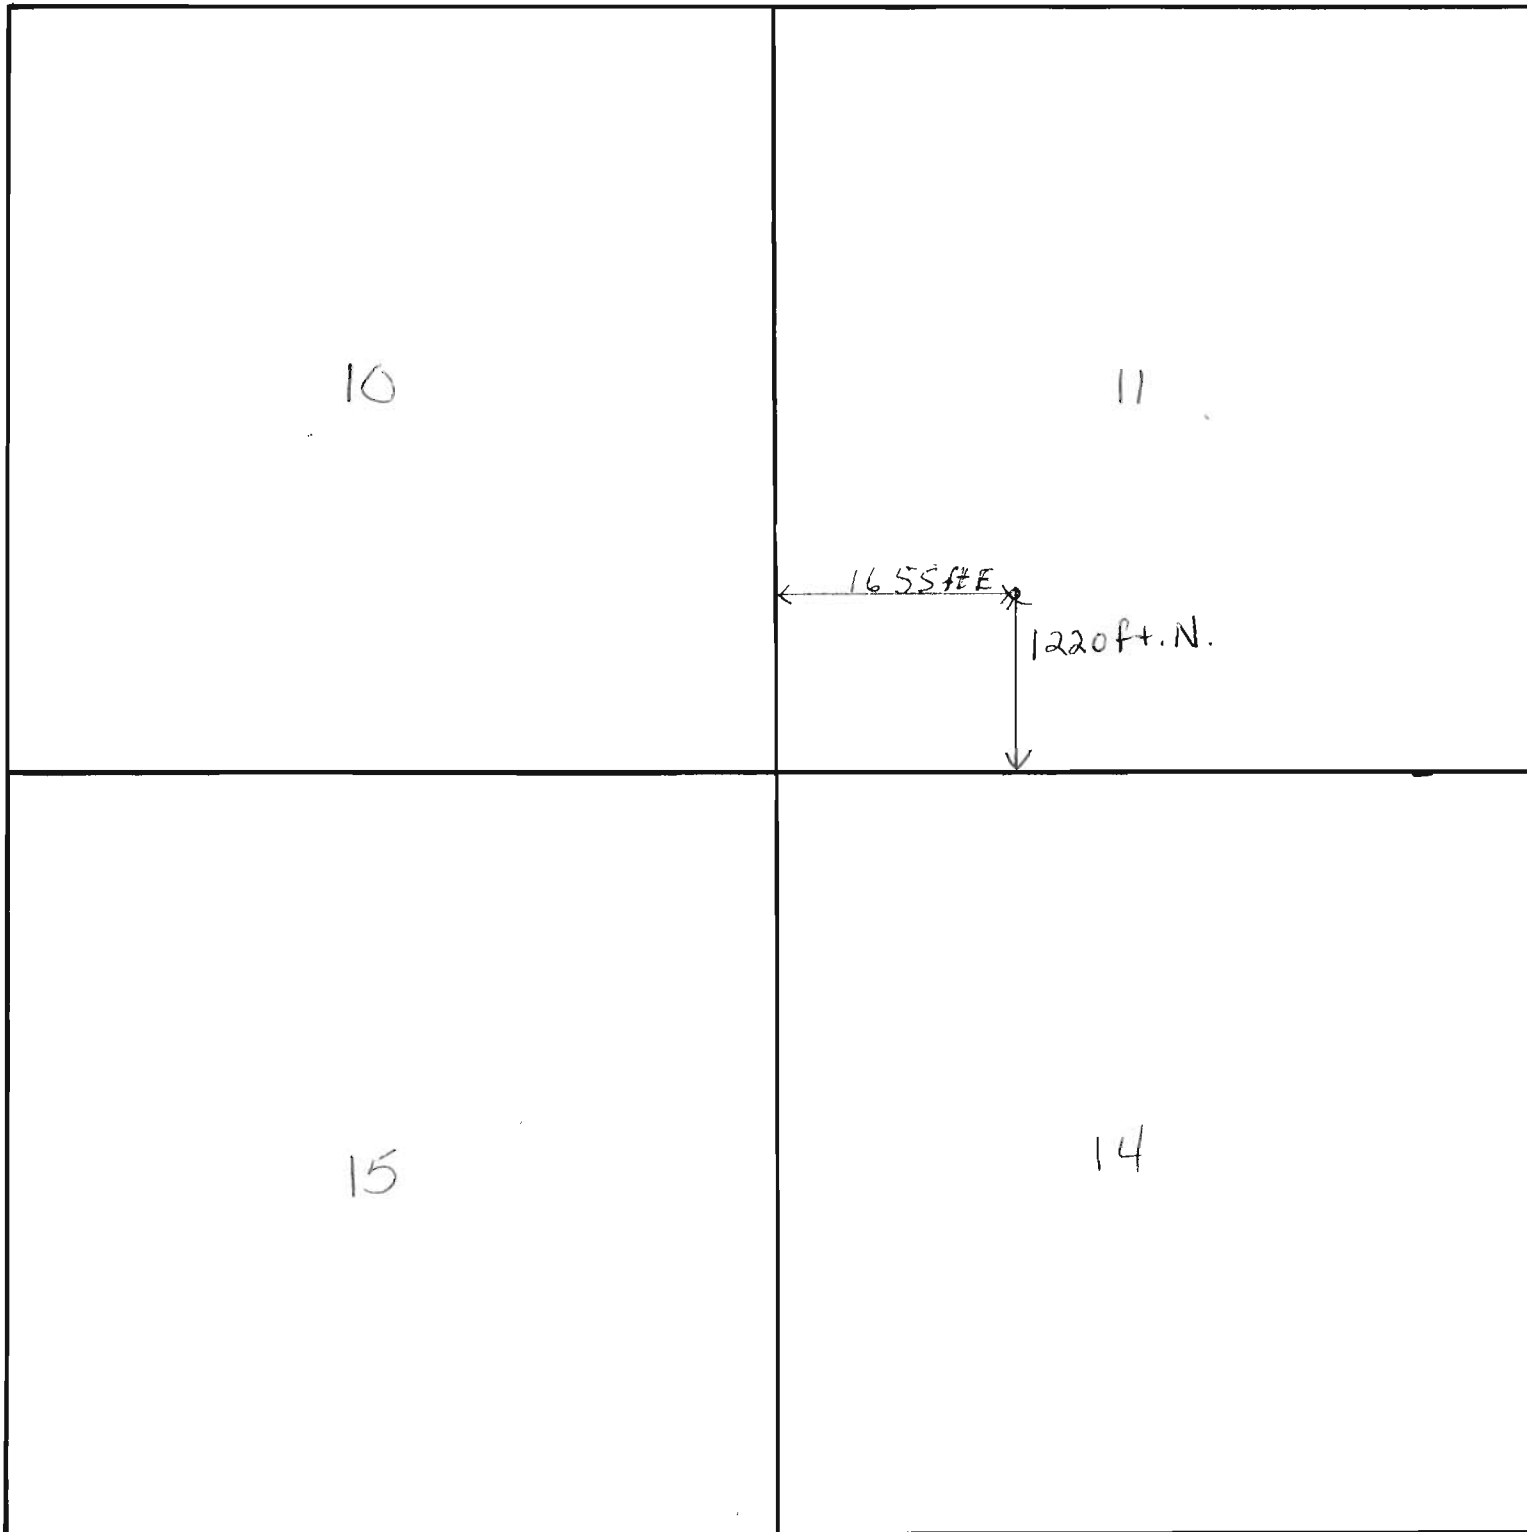

NAME CCC Spring

COUNTY Grant

RECEIVED

JAN 10 1983

Application No. 64705

Permit No. 49160

RECEIVED

WATER RESOURCES DEPT.

SALEM, OREGON

AUG 25 1983

WATER RESOURCES DEPT.

SALEM, OREGON