


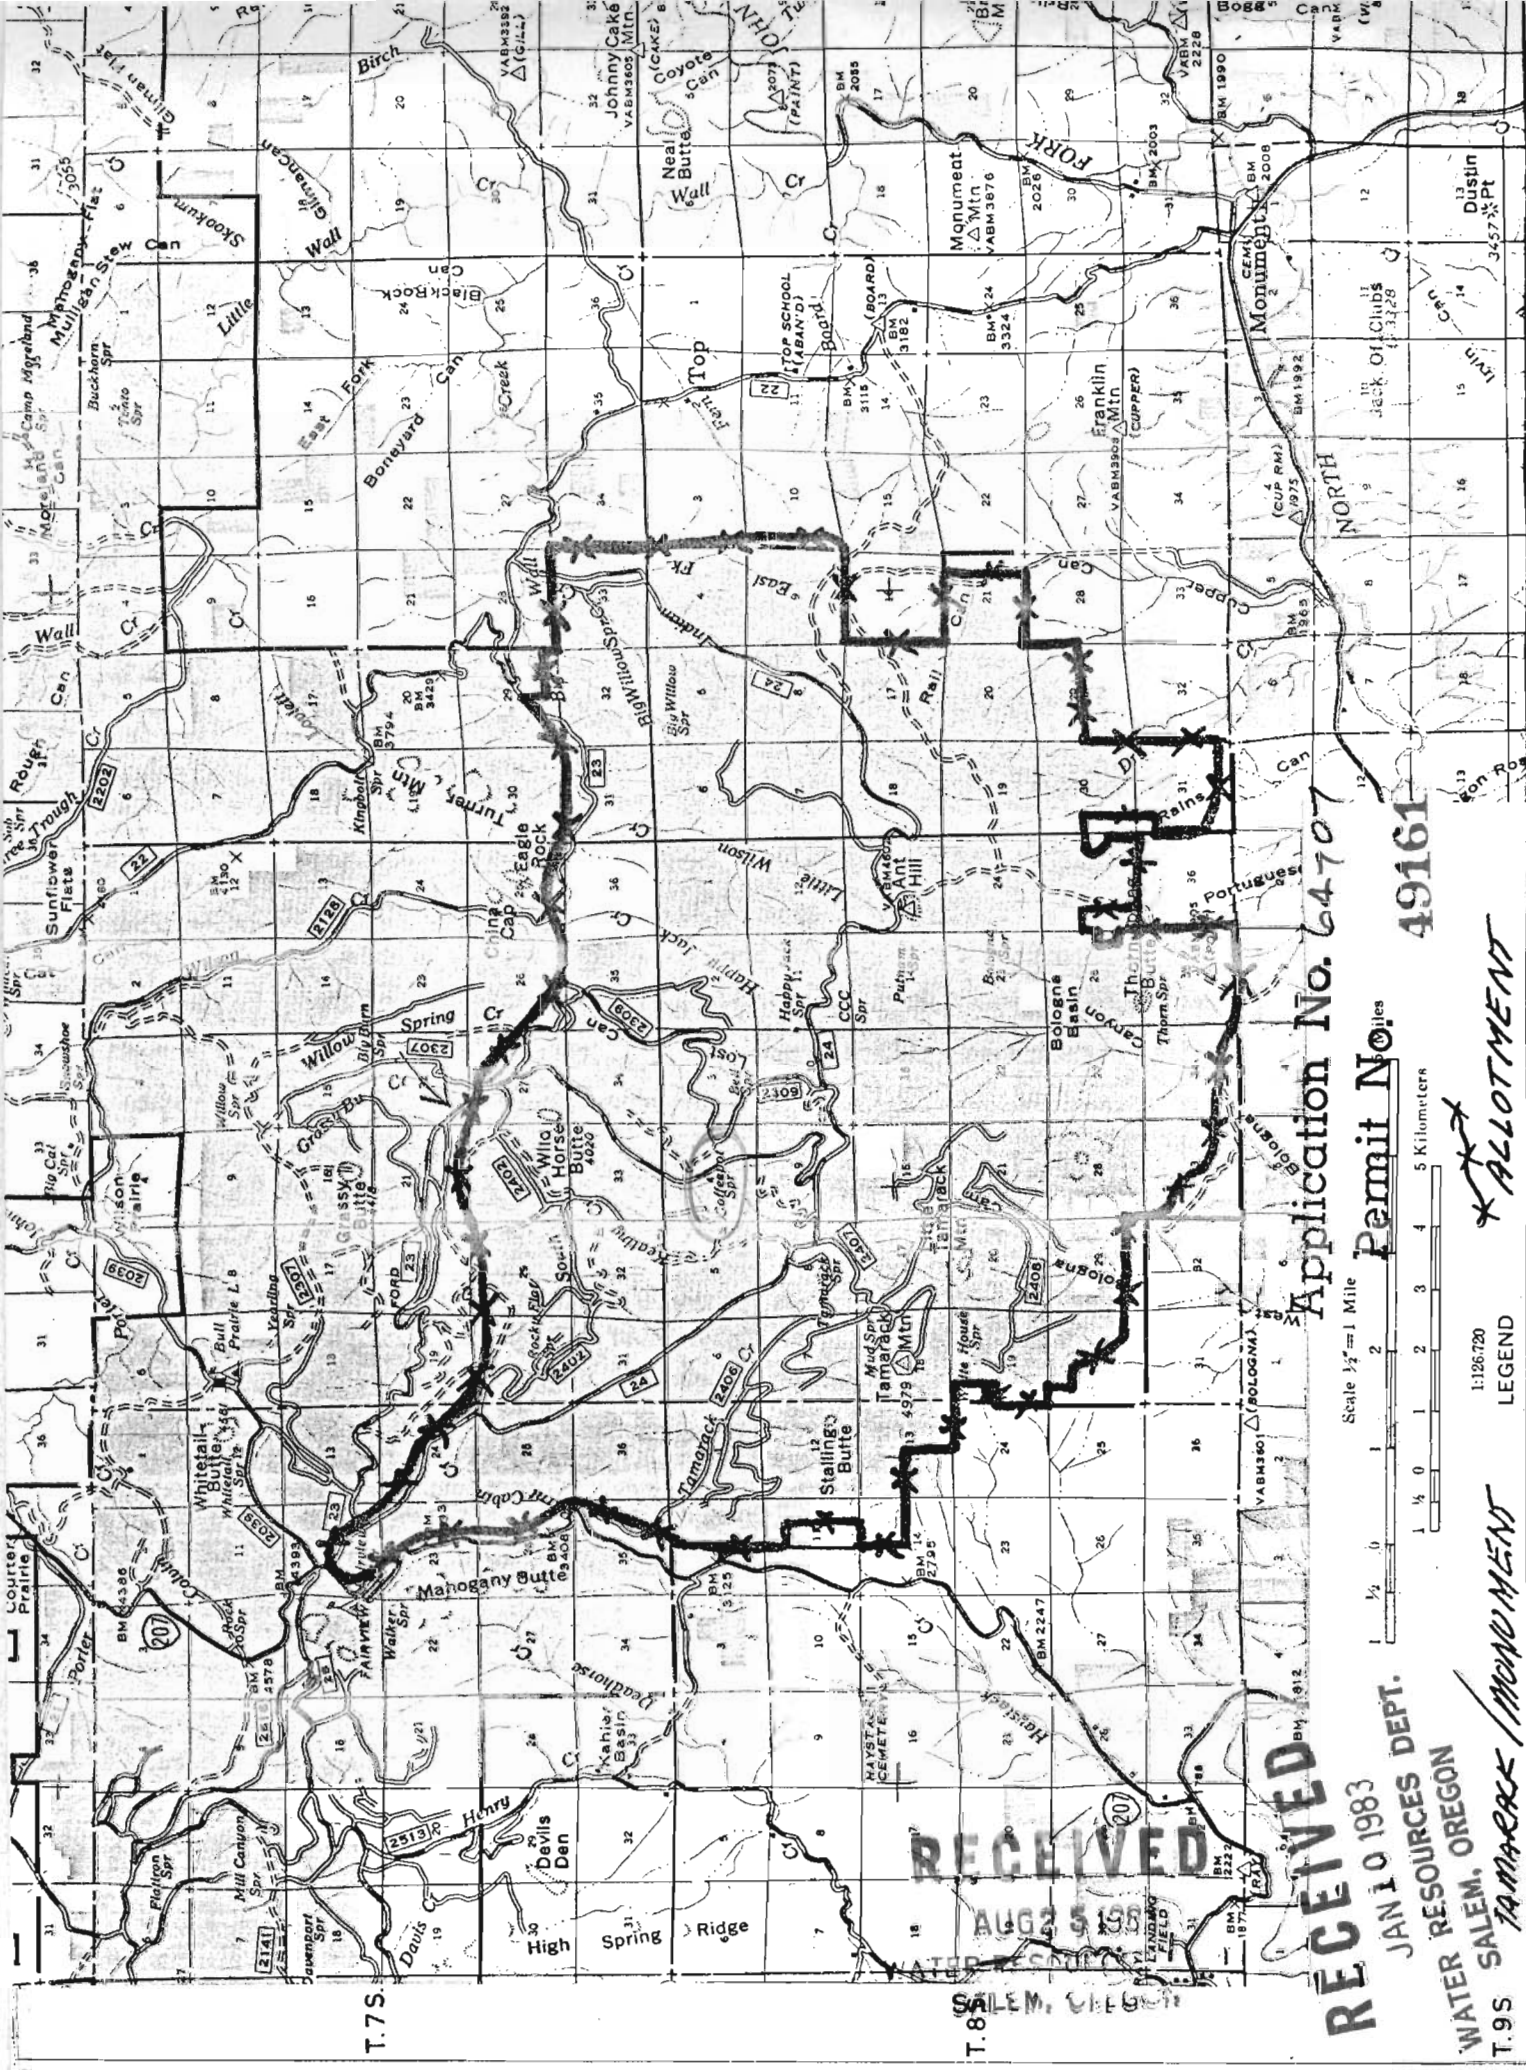



Application No. 64707

Permit No. 49161

Scale 1/2" = 1 Mile




LEGEND

RECEIVED  
JAN 10 1983  
WATER RESOURCES DEPT.  
SALEM, OREGON


\* ALLOTMENT

TAMARACK MONUMENT

R. 25 E.

R. 26 E.

R. 27 E.

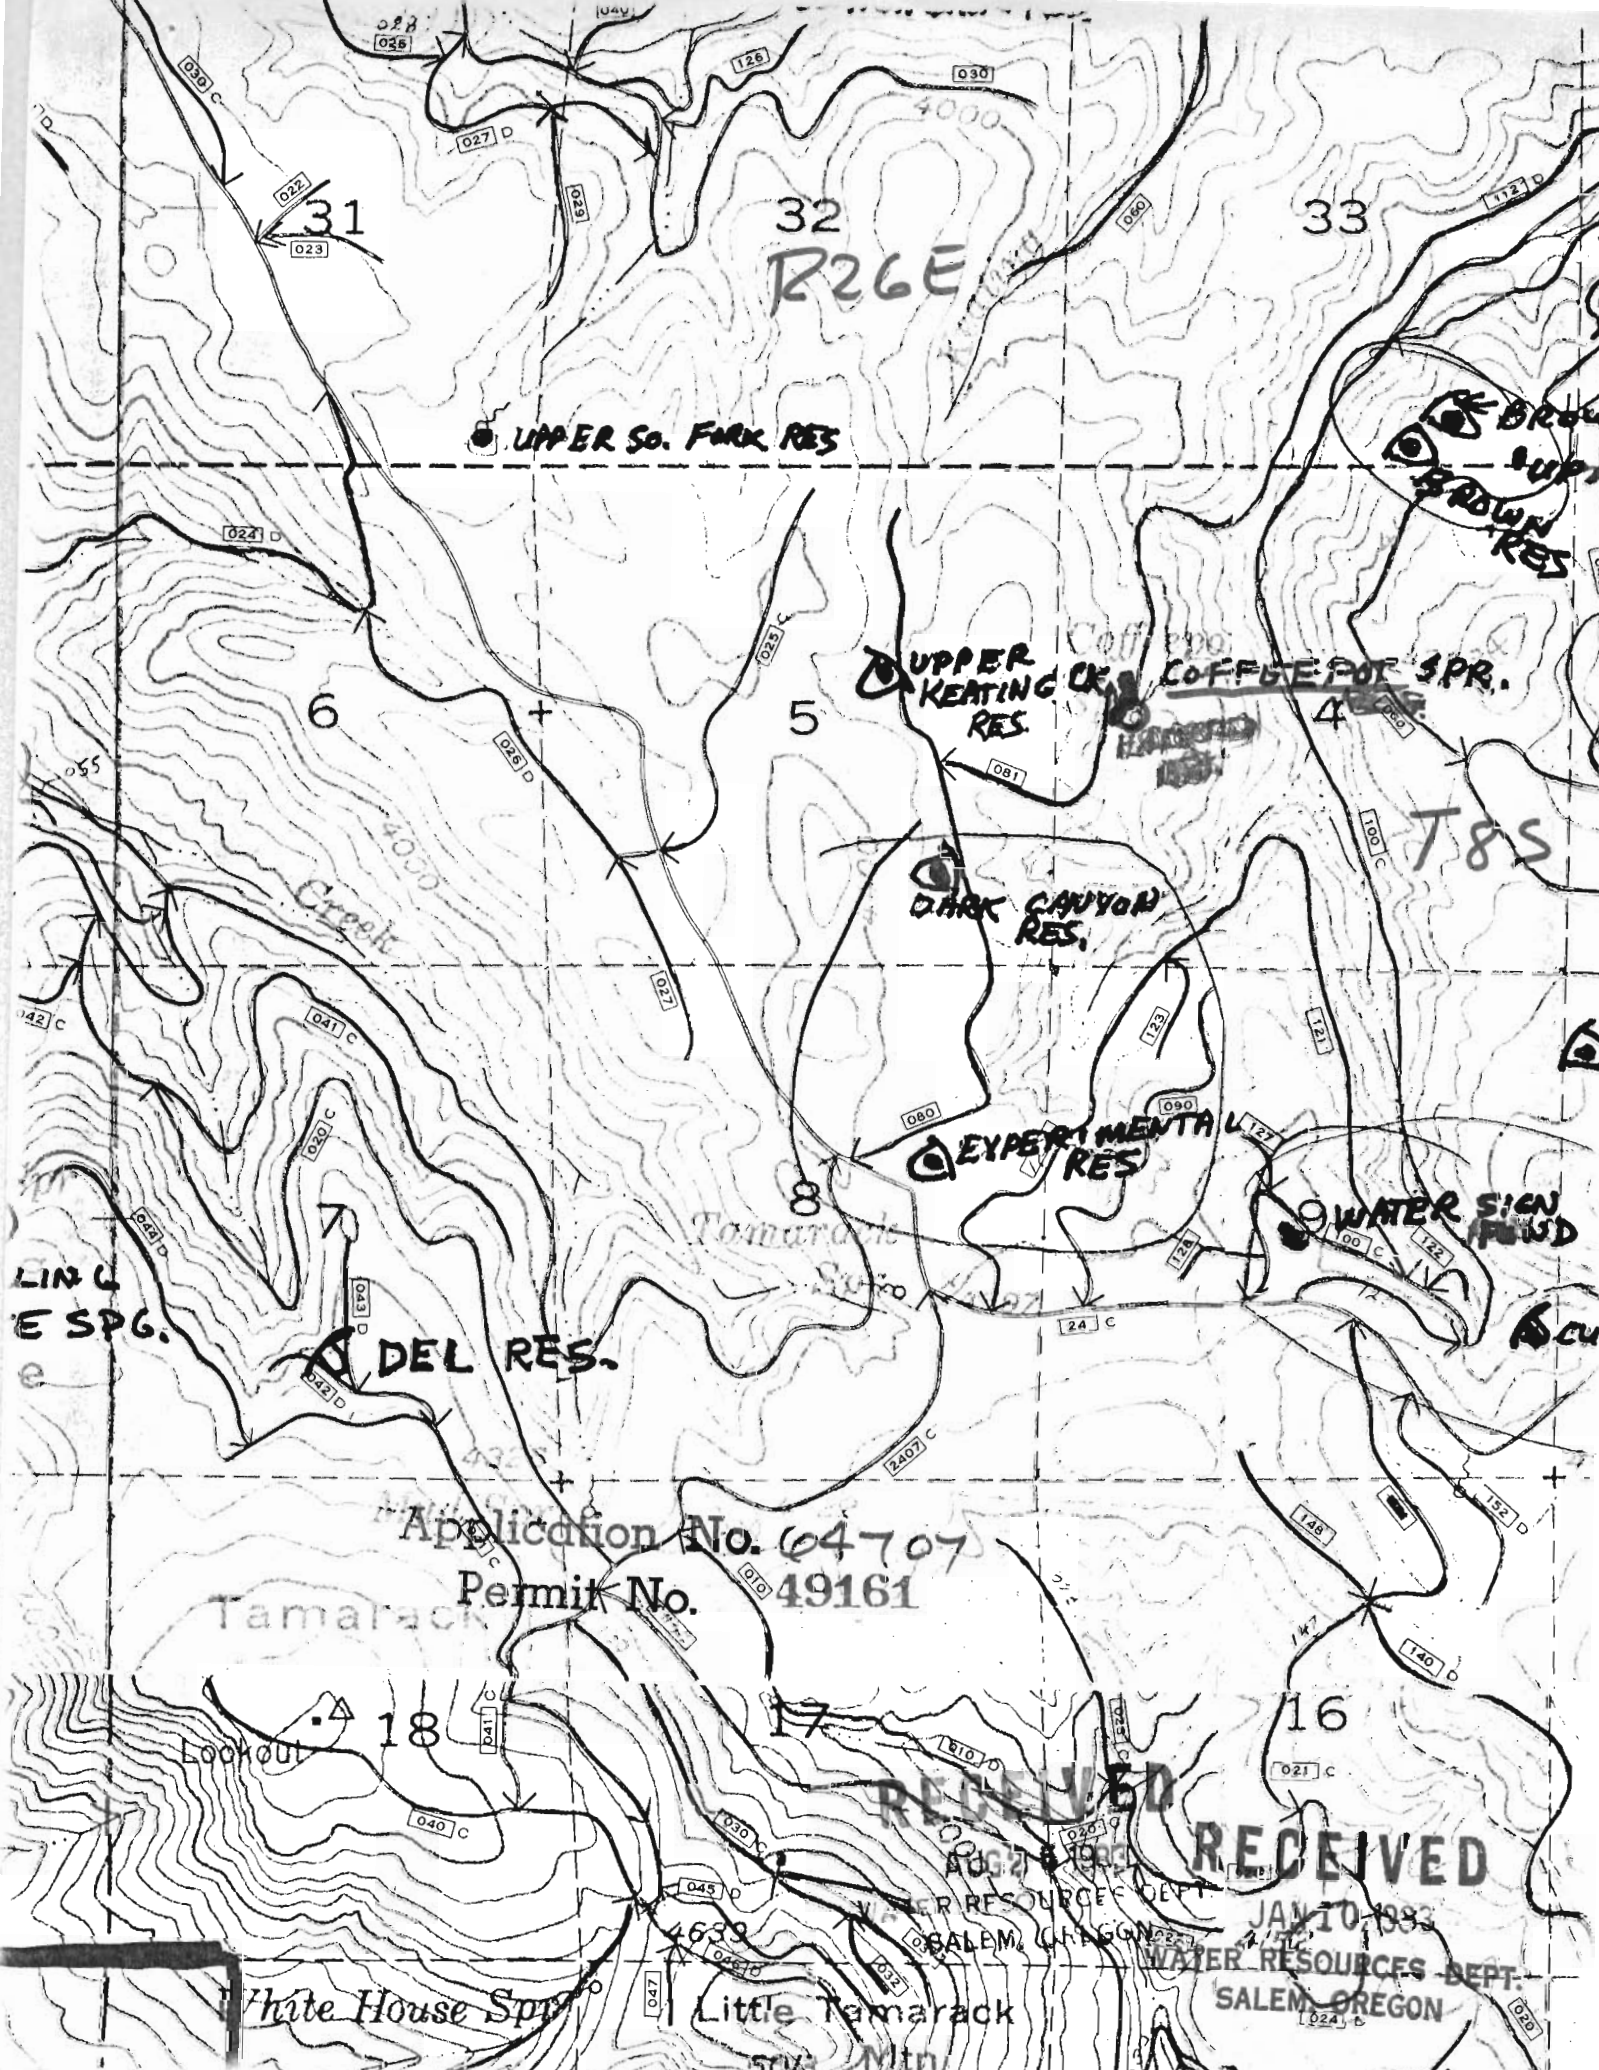

UPPER So. Fork RES

UPPER KEATING CR. RES

COFFEE POT SPR.

DARK CANYON RES.

EXPERIMENTAL RES.

WATER SIGN FOUND

DEL RES.

Application No. 64707

Permit No. 49161

Tamarack

Lookout

White House Spr.

Little Tamarack

RECEIVED

RECEIVED

AUG 28 1983

JAN 10 1983


WATER RESOURCES DEPT.

WATER RESOURCES DEPT.

SALEM, OREGON

SALEM, OREGON

TOWNSHIP 8S, RANGE 26E, SECTION 4, W.M.

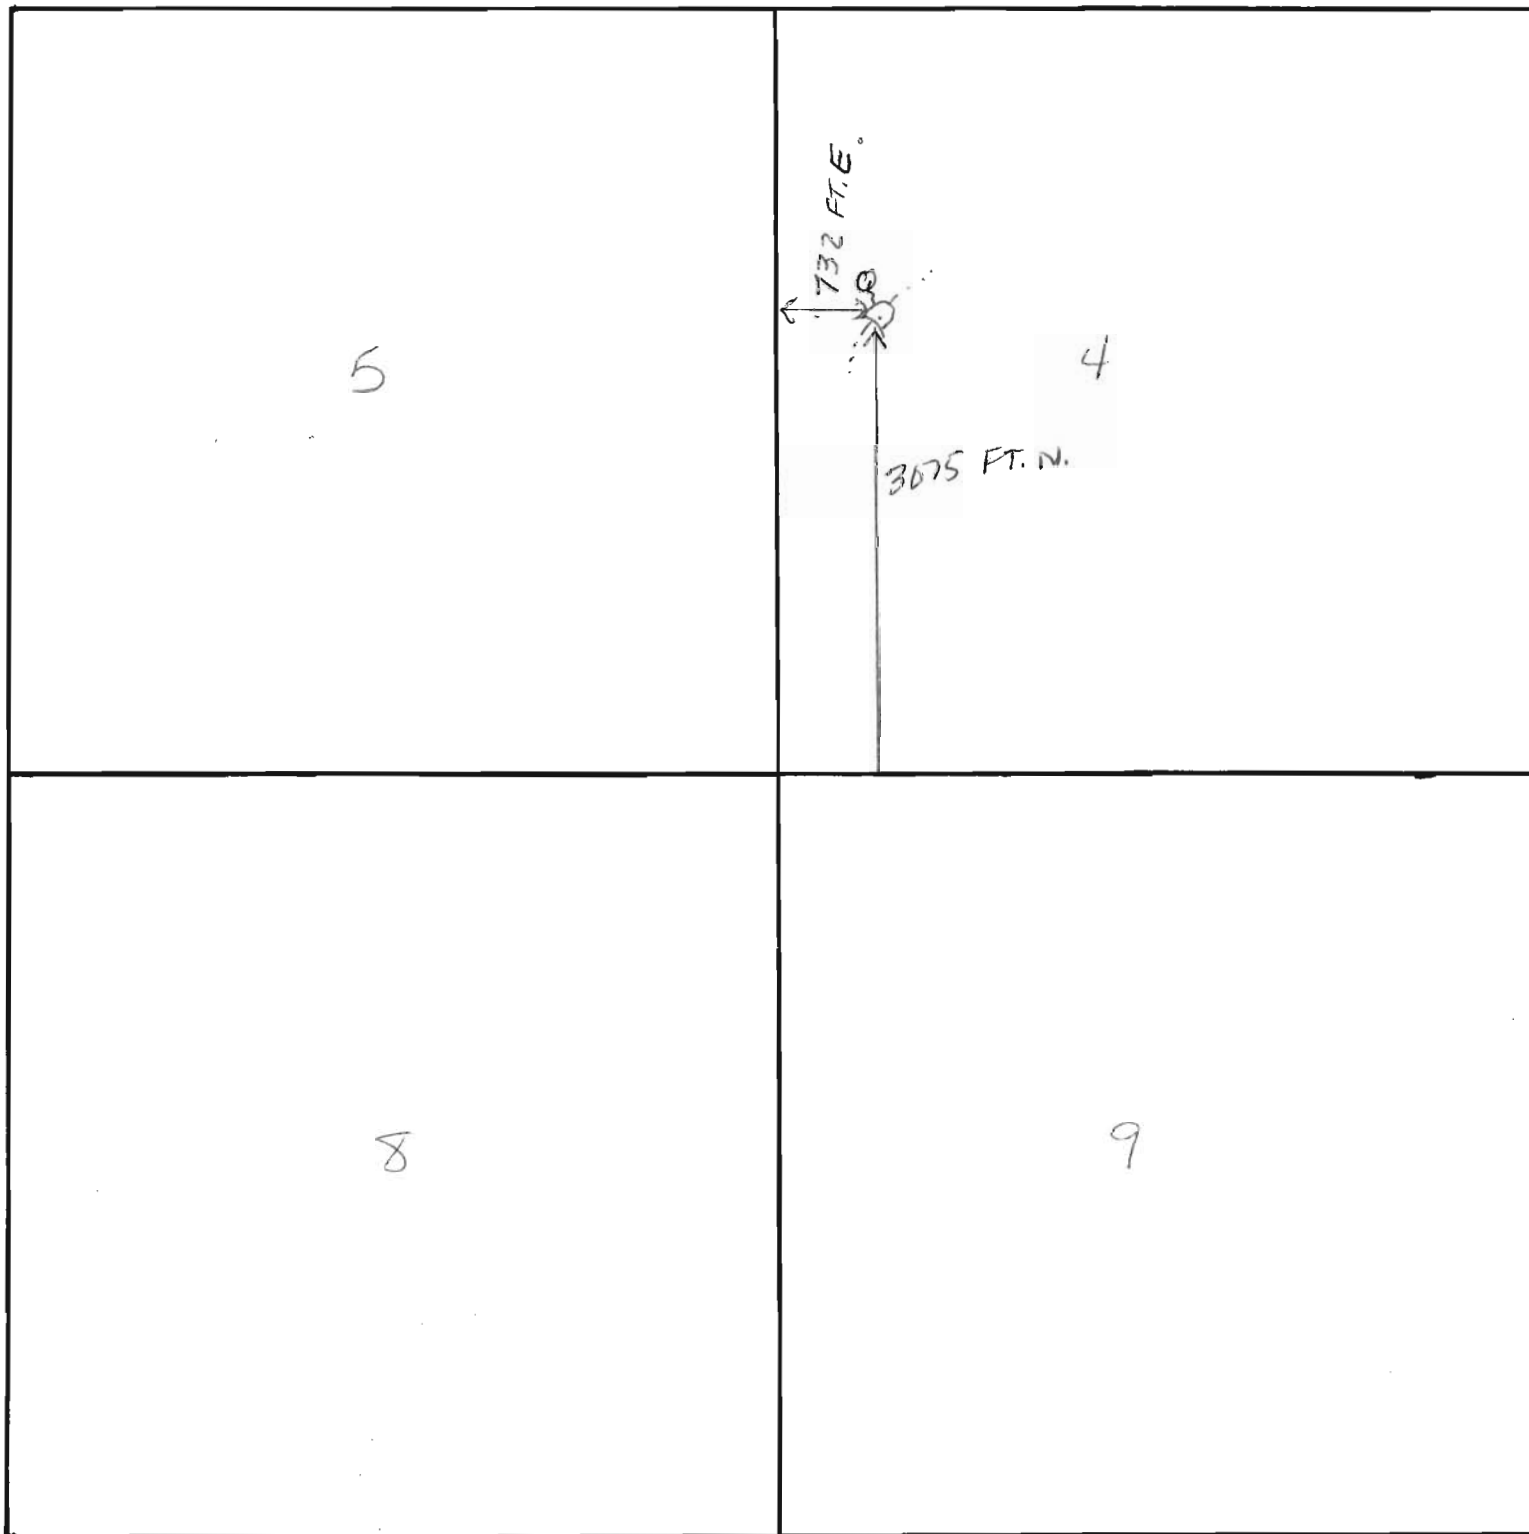

NAME Coffee Pot Spring

COUNTY Grant

Application No. 64707

Permit No. 49161

**RECEIVED**

AUG 25 1983  
WATER RESOURCES DEPT.  
SALEM, OREGON

**RECEIVED**

JAN 10 1983

WATER RESOURCES DEPT.  
SALEM, OREGON