

Application No. 64766
Permit No. 49162

DEATH
PEAK RES.

LOST CANYON
SPG. RES.

ZION
SPG.

TOADSPOND

BIG WILLOW R.
BIG WILLOW SP.

GOLD BUCK
2 SPG.

1. HORSE
CORRAL RES.

6 PICTURE
POND
LITTLE MUD SPG.

UPPER W
SPG.

UPPER LITTLE
MUD RES.

Application No. 64766
Permit No.

CK
G.
11

HAPPYJACK
ROAD RES.

HAPPYJACK
ROAD RES.

RECEIVED

JAN 17 1983

WATER RESOURCES DEPT.
SALEM, OREGON

ROAD RES.

UPPER INDIAN
CK. RES.

SOUTH FORK
INDIAN CK
RES.

Vietnam Spr


MABM

Ant Hill

4602

lockout

4028

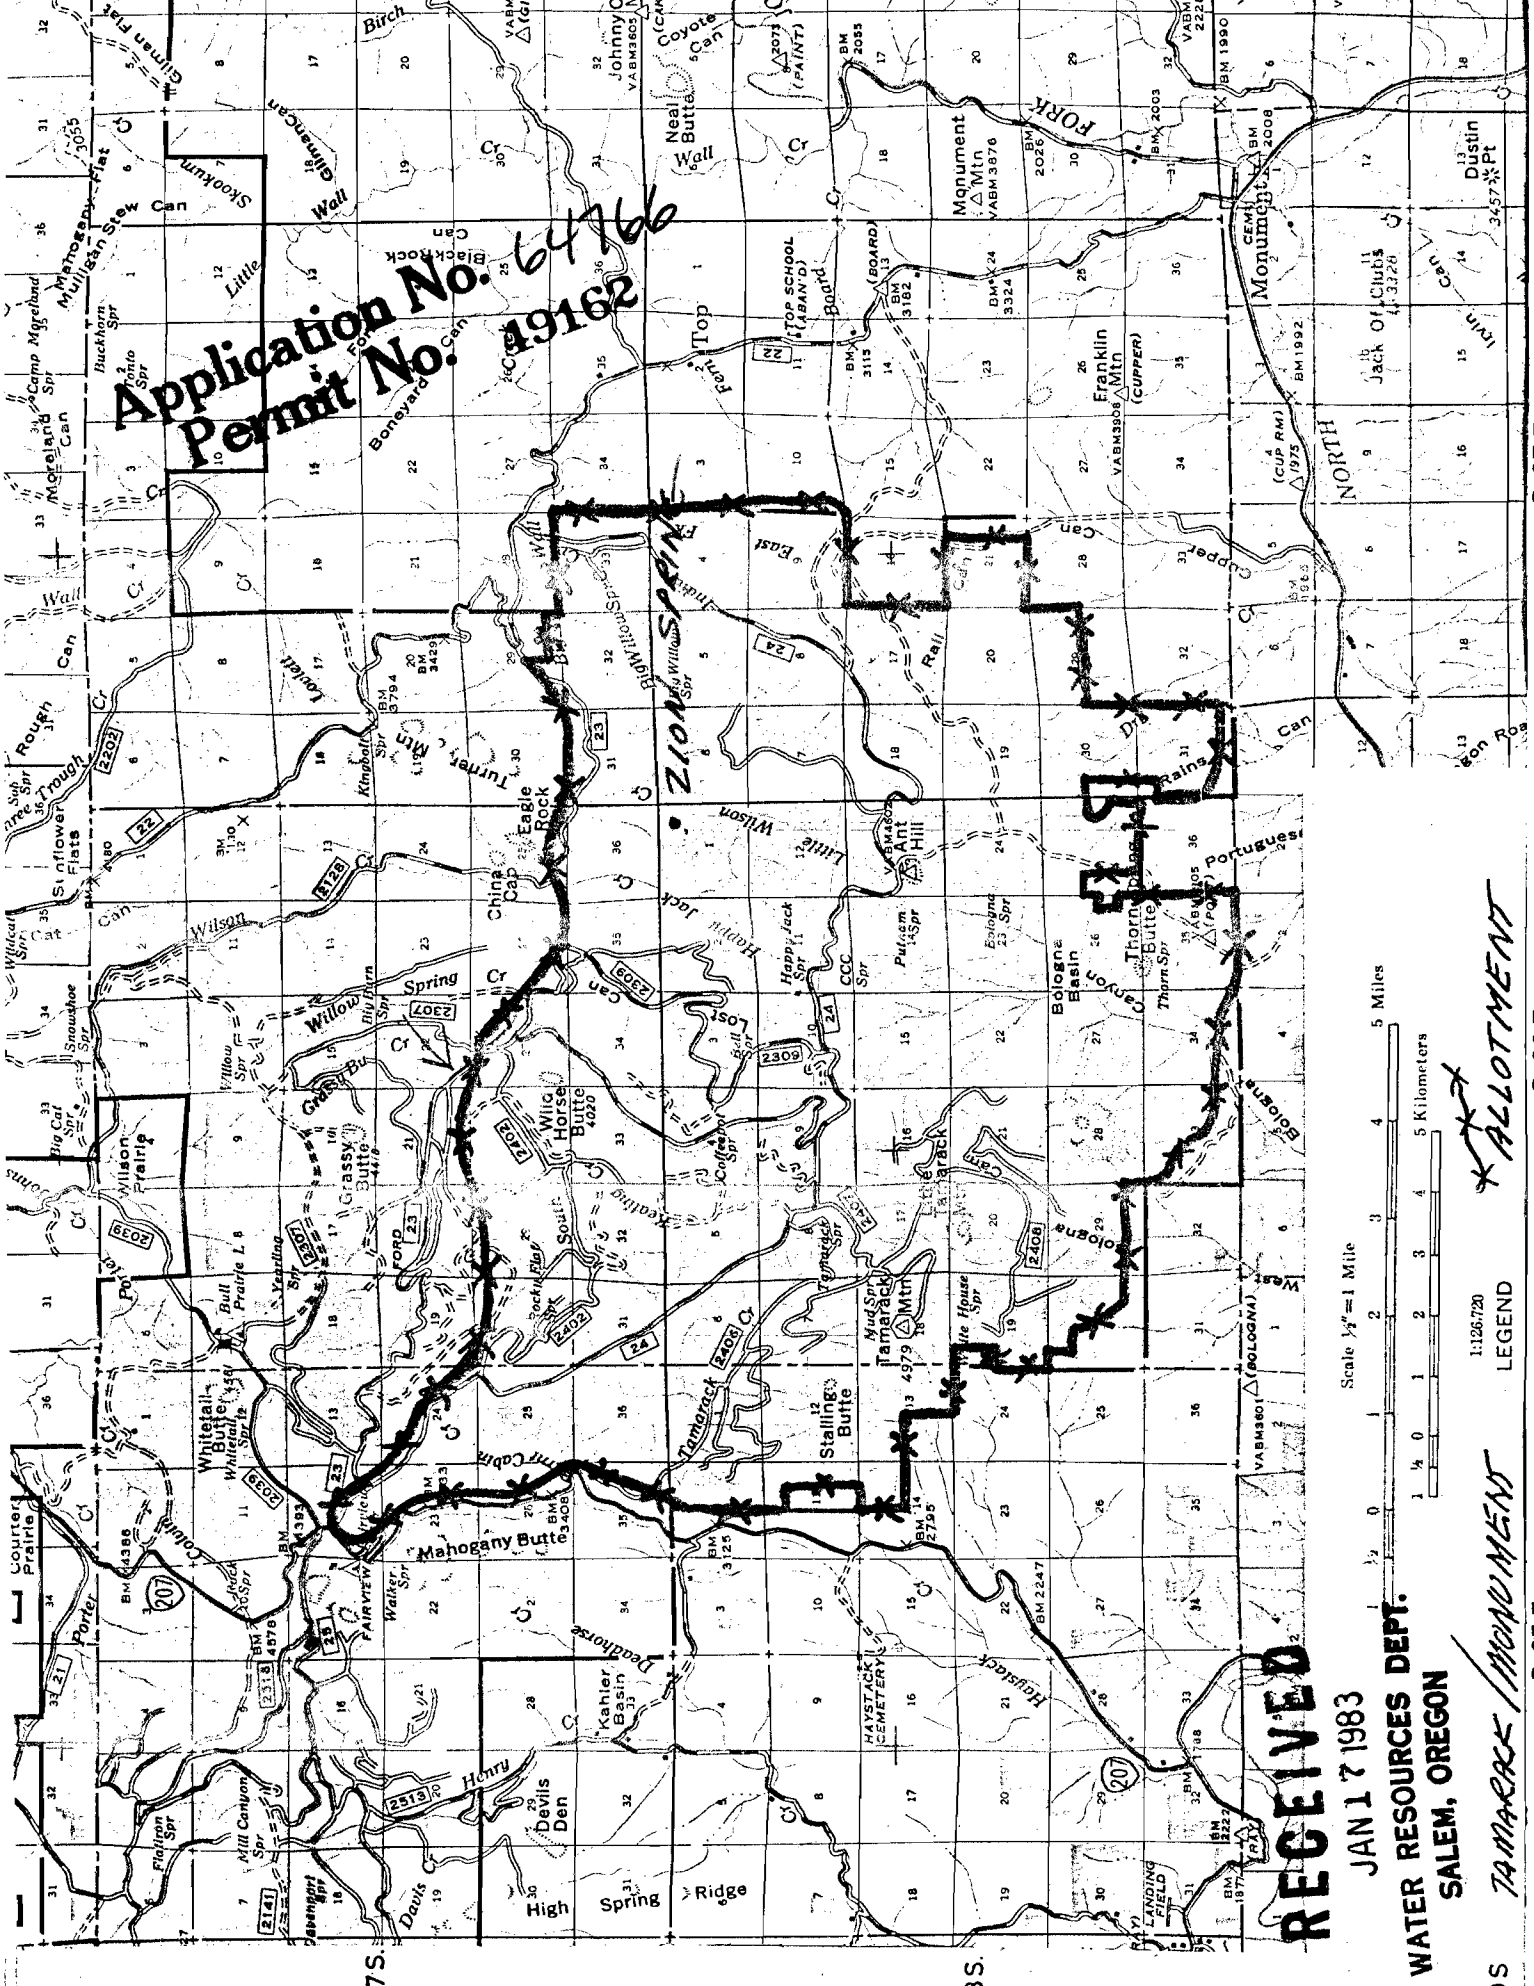

Application No. 64766
Permit No. 49162

RECEIVED

JAN 17 1983

WATER RESOURCES DEPT.
SALEM, OREGON


T.9S Tamarack Monument

R. 25 E.

LEGEND


R. 26 E.

* ALLOTMENT

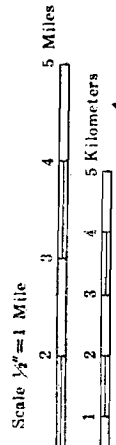

TOWNSHIP 8 S, RANGE 26 E, SECTION 1, W.M.

2

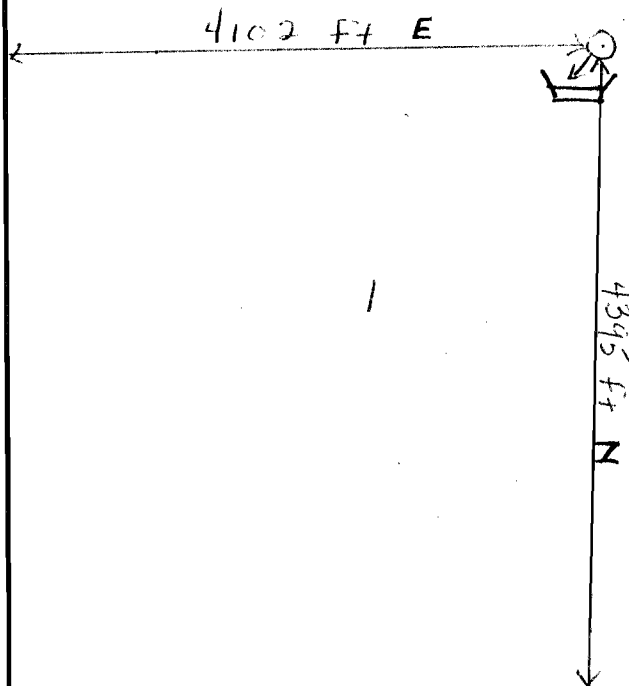

Application No. 64766
Permit No. 49162

11

12

NAME Zion Spring COUNTY Grant

RECEIVED

JAN 17 1983

WATER RESOURCES DEPT.
SALEM, OREGON