

BM

T 8 S

R 25 E

Section 12

11

12

Stalling

Butte

Spr

1300

2600

4000

3600

BM

2795

14

13

N

3600

Application No. 64816

Permit No. 49166

RECEIVED

DEC 19 1983

WATER RESOURCES DEPT.
ORON, OREGON

23

24


Permit No. 49166

Application No. 64816

T.7S.

T.8S.

T.9S.

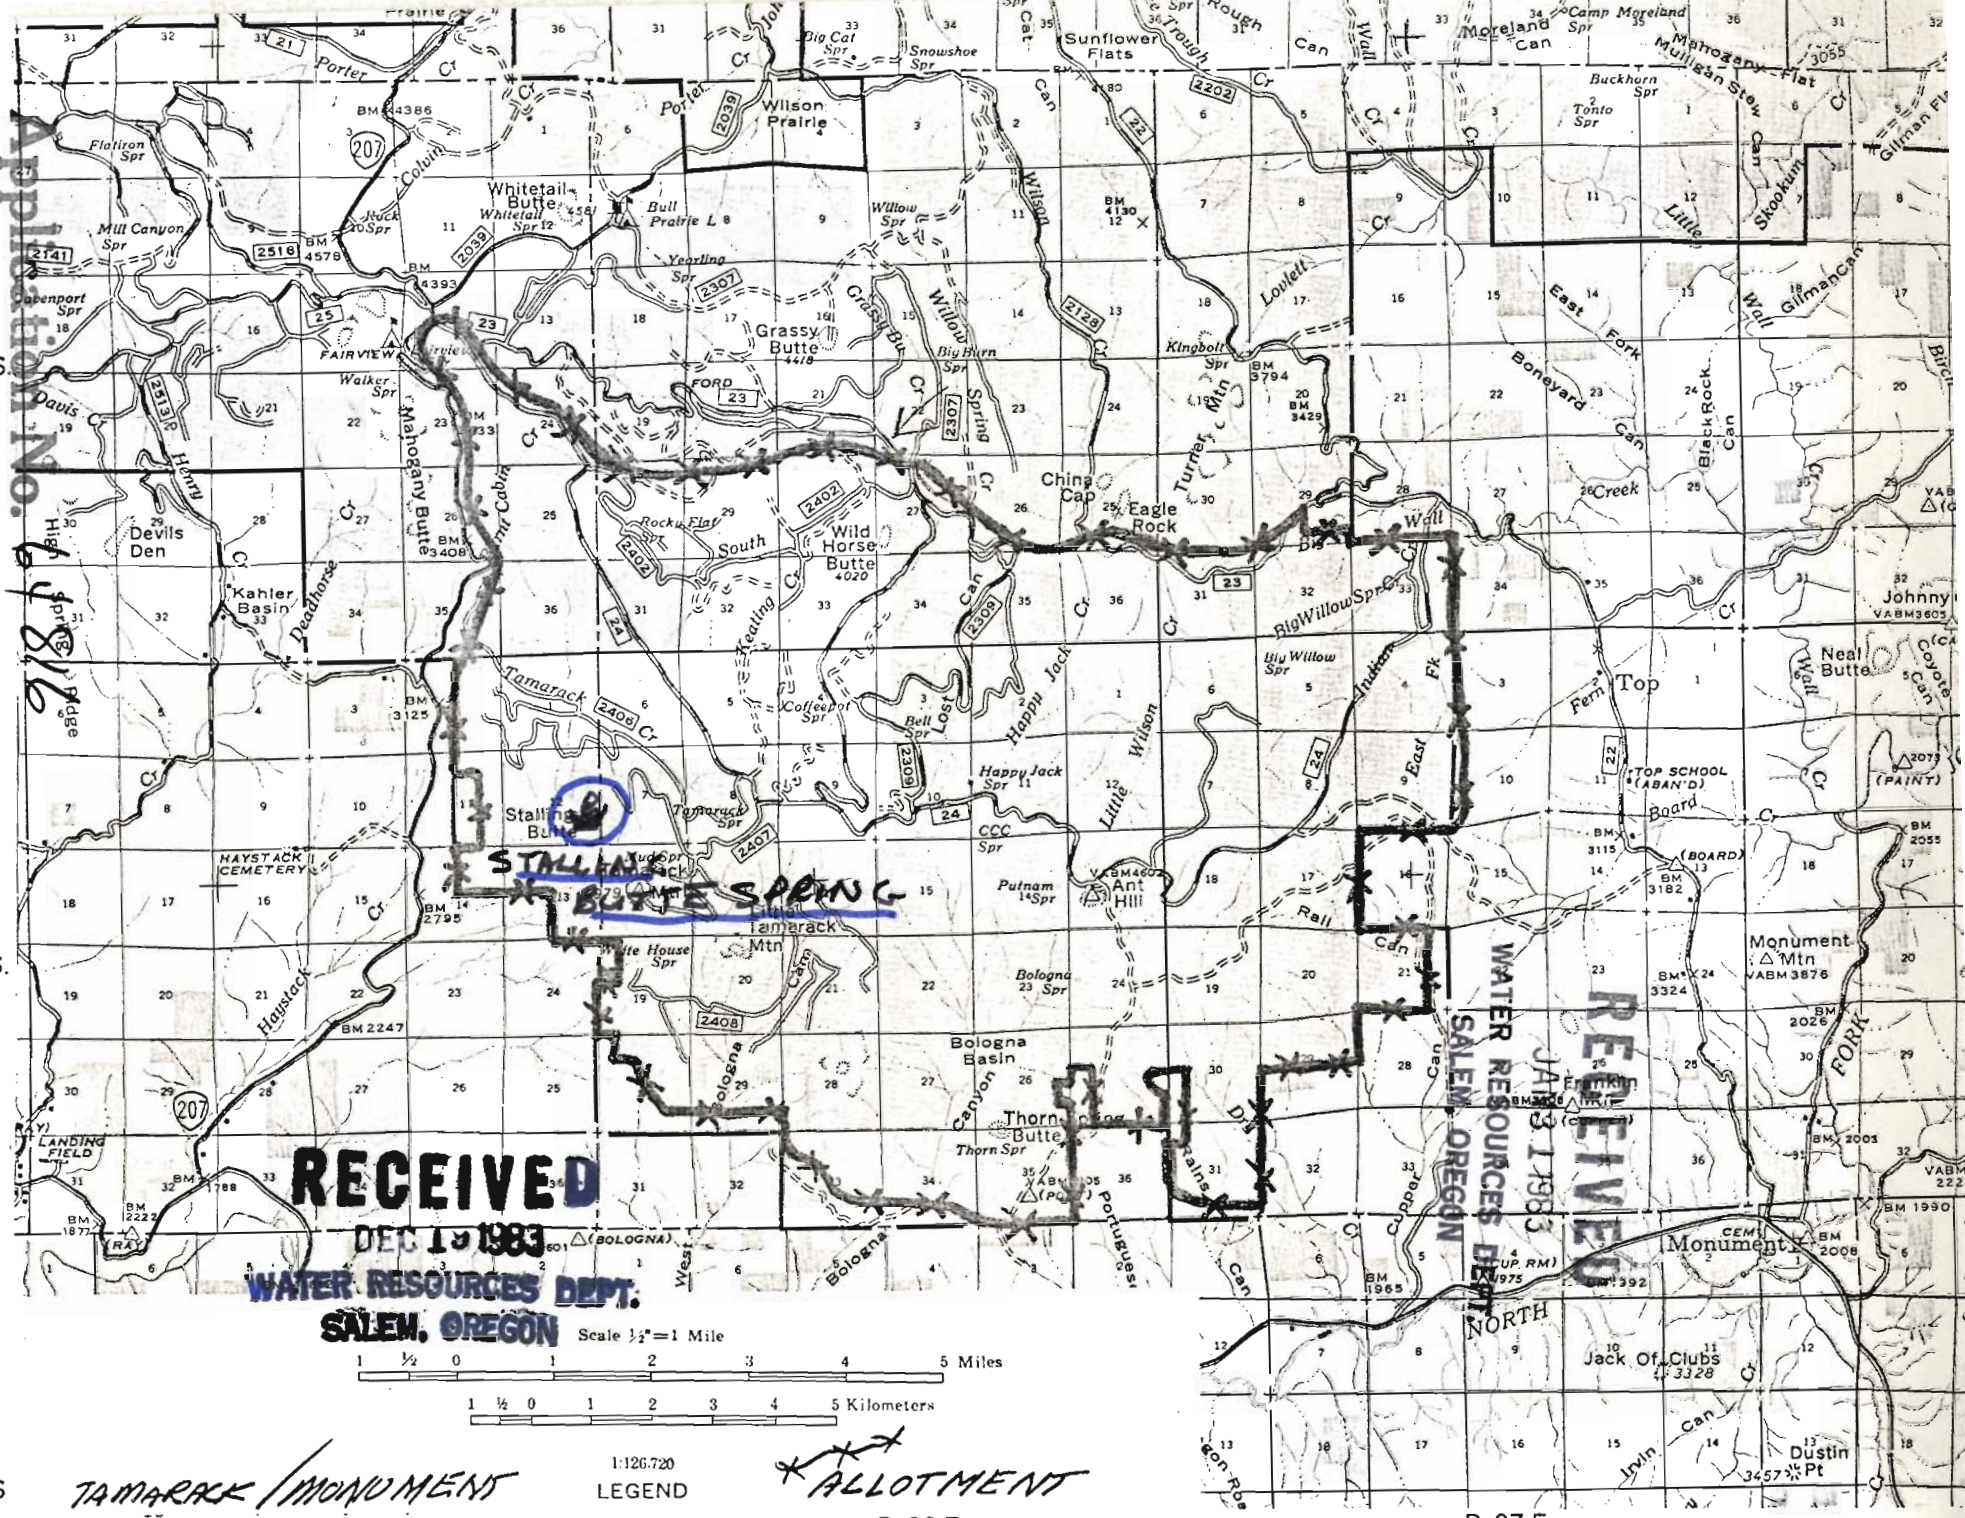

RECEIVED

DEC 19 1983

WATER RESOURCES DEPT.
SALEM, OREGON

Scale 1/2" = 1 Mile

1 1/2 0 1 2 3 4 5 Miles

1 1/2 0 1 2 3 4 5 Kilometers

1:126,720

LEGEND

*** ALLOTMENT

R. 25 E.

R. 26 E.

R. 27 E.