


Scale 2" = 1 mile

WINEMA
NATIONAL
FOREST

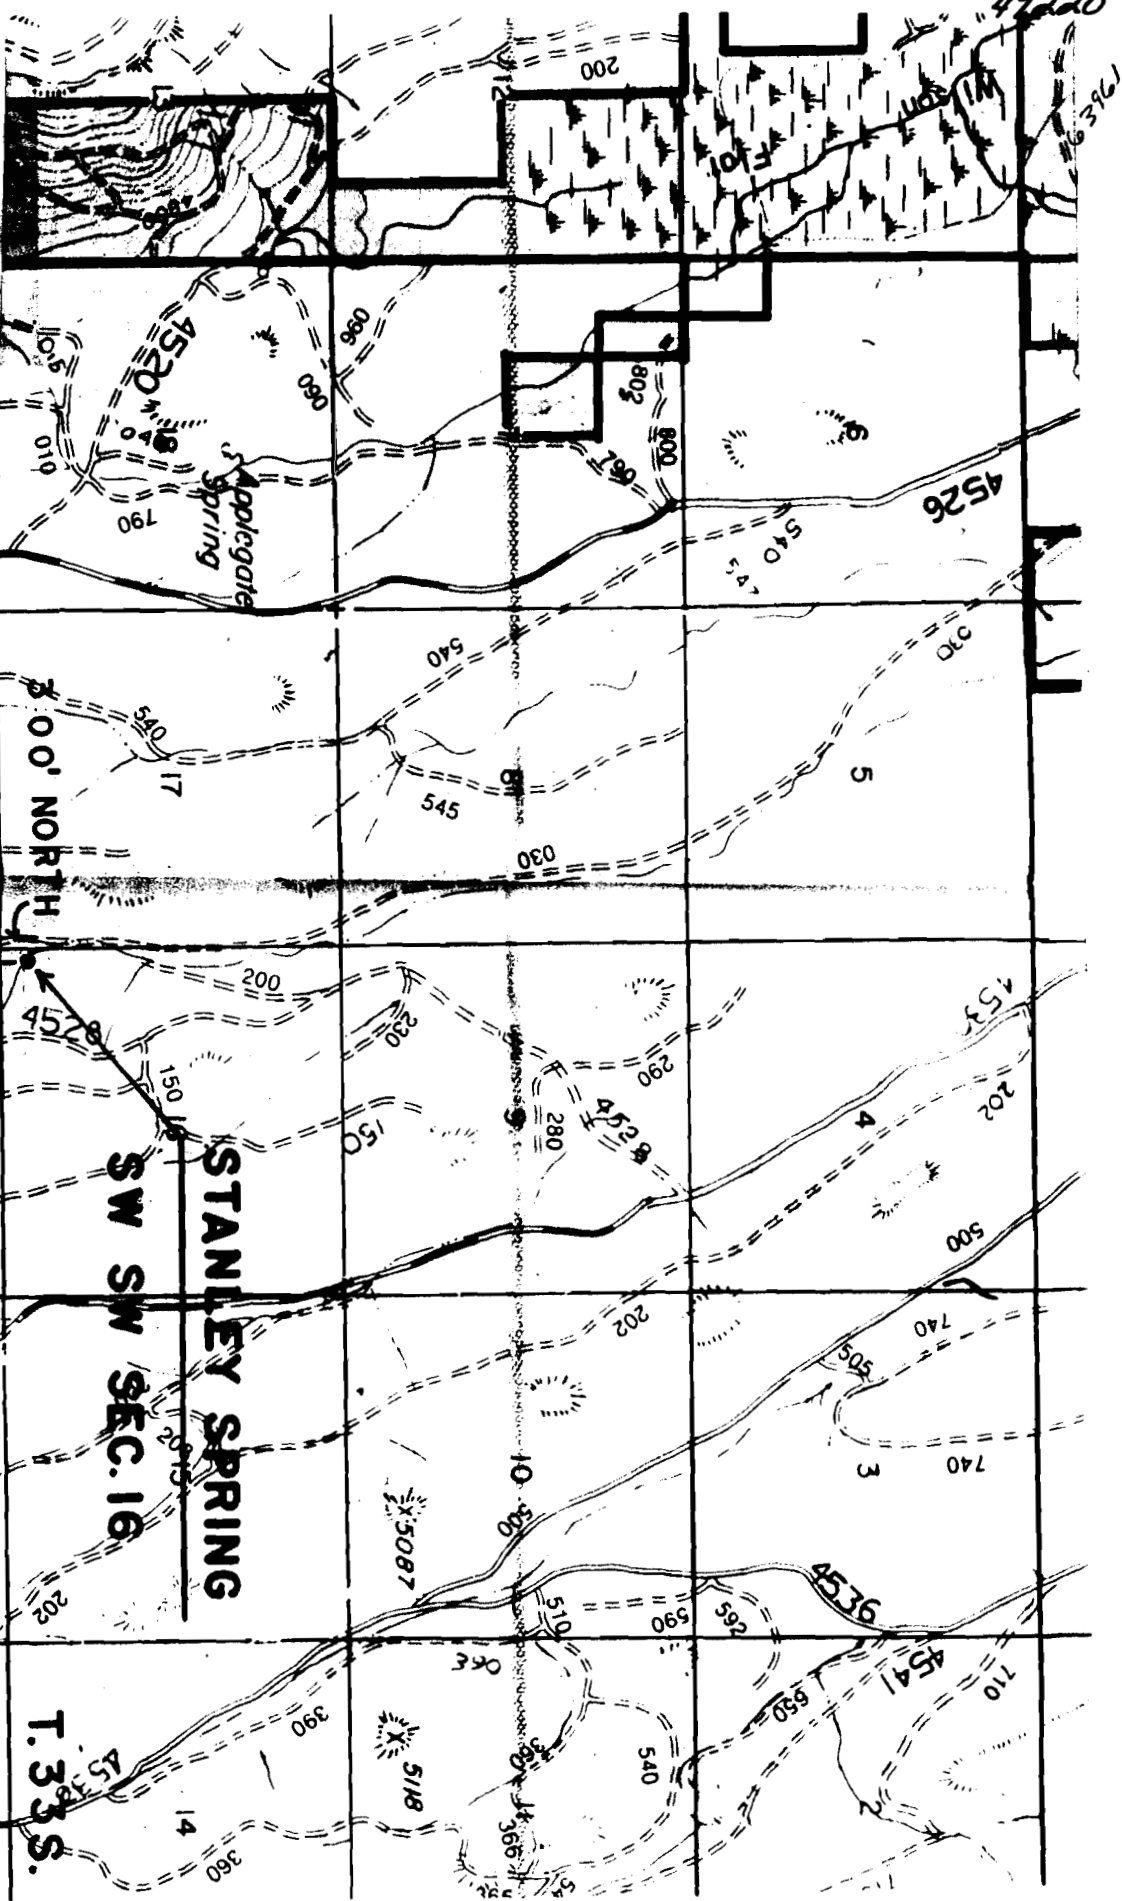

R. 9 E.

Application No. 66693
Per N.D.

STANLEY SPRING
SW SW SEC. 16

T. 33 S.

Williamson Rv. Misc.