


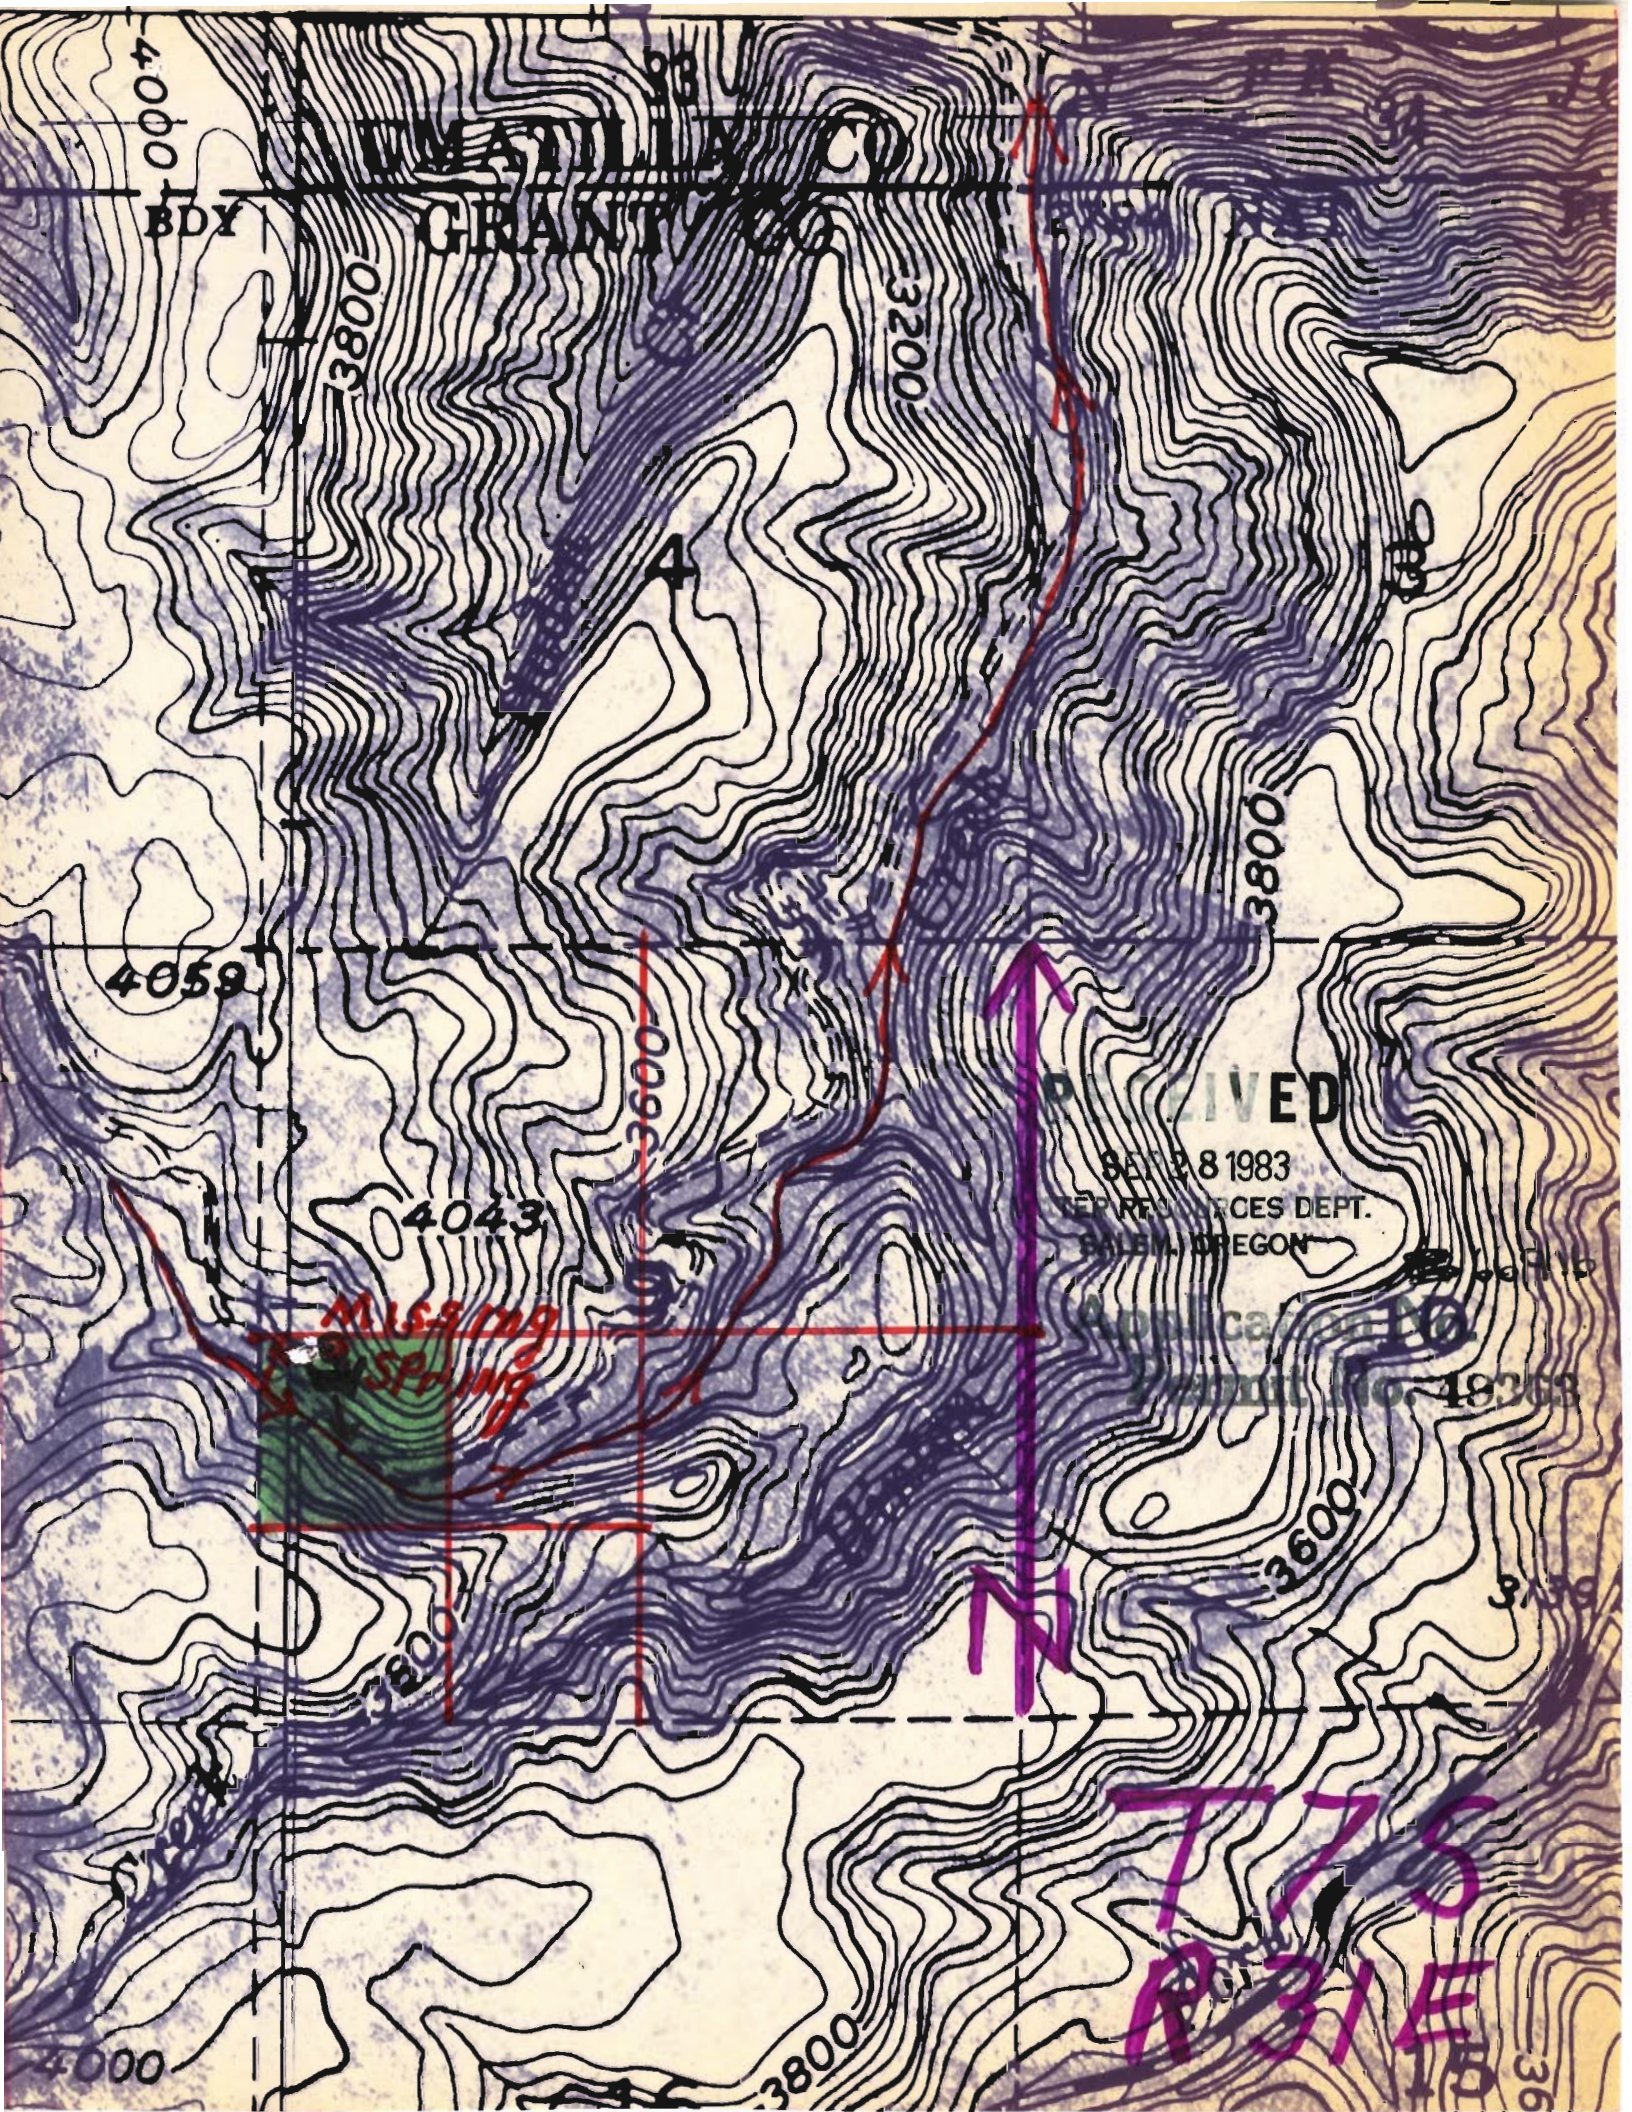

MATILLA CO
GRANT CO

BDY

4059

4043

Missing Spring

RECEIVED

SEP 28 1983
SALEM, OREGON



N

T75
R31E