


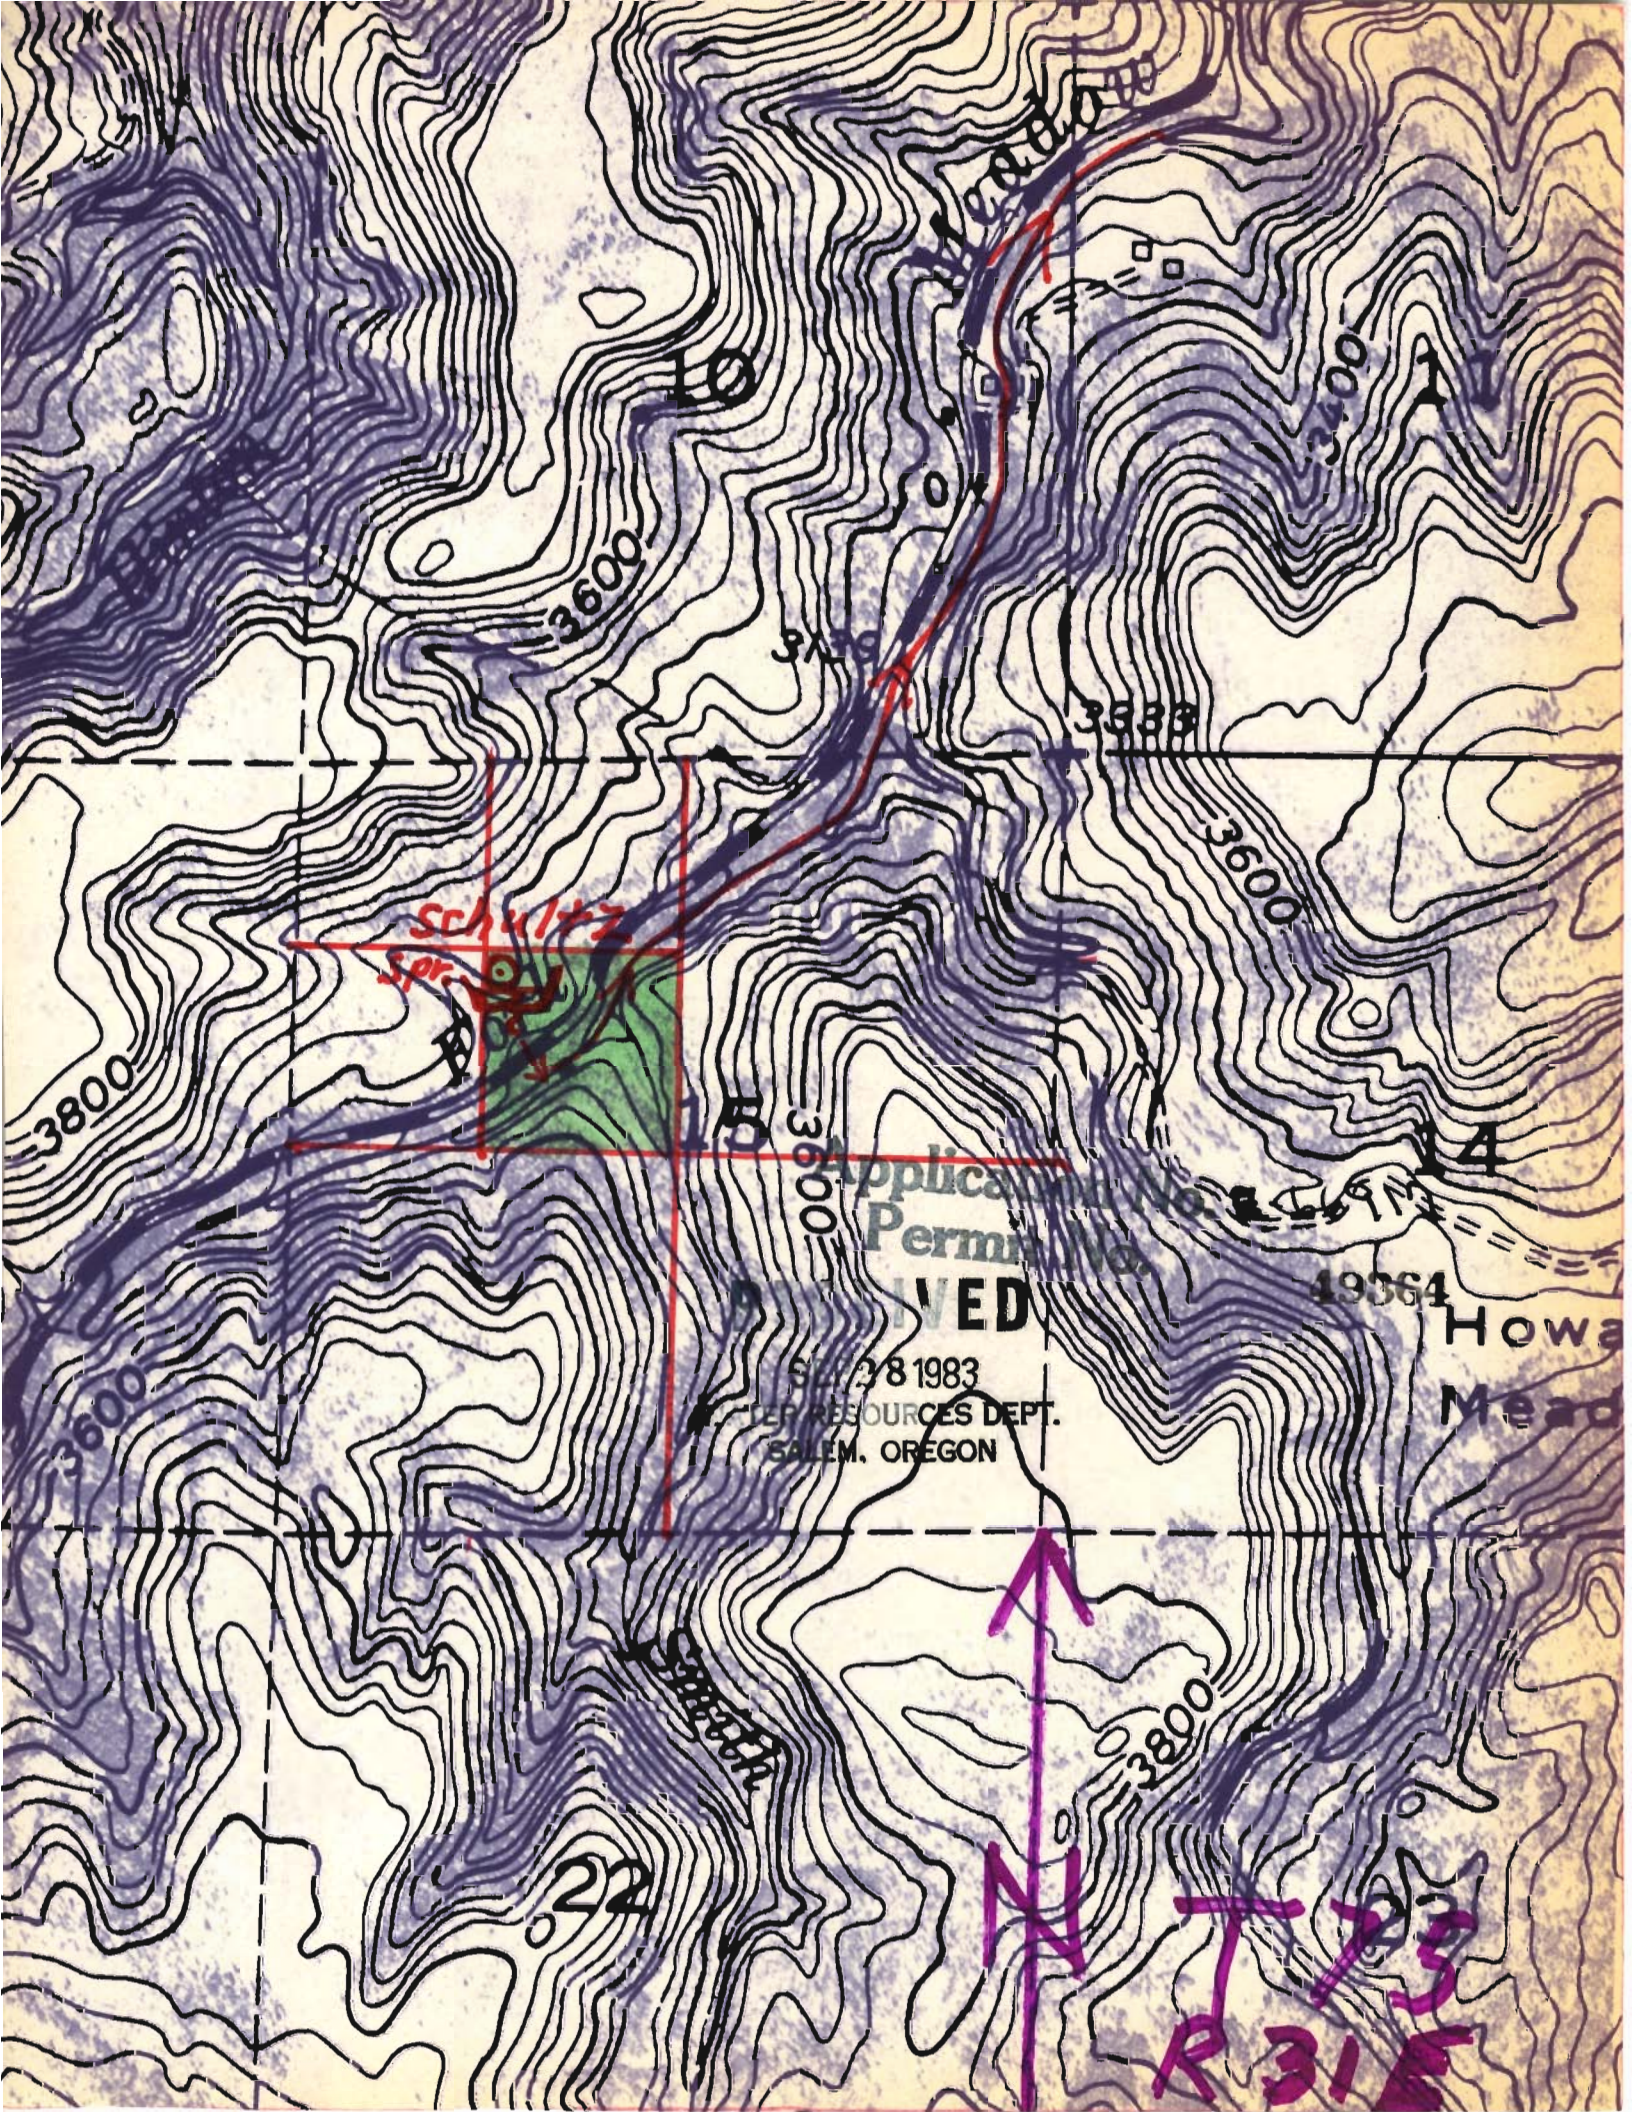

10

3600

3583

3583

3600

3800

15

3600

14

3600

19364

Howa

Mea


WATER RESOURCES DEPT.
SALEM, OREGON

22

3800

N T 23
R 31 E