


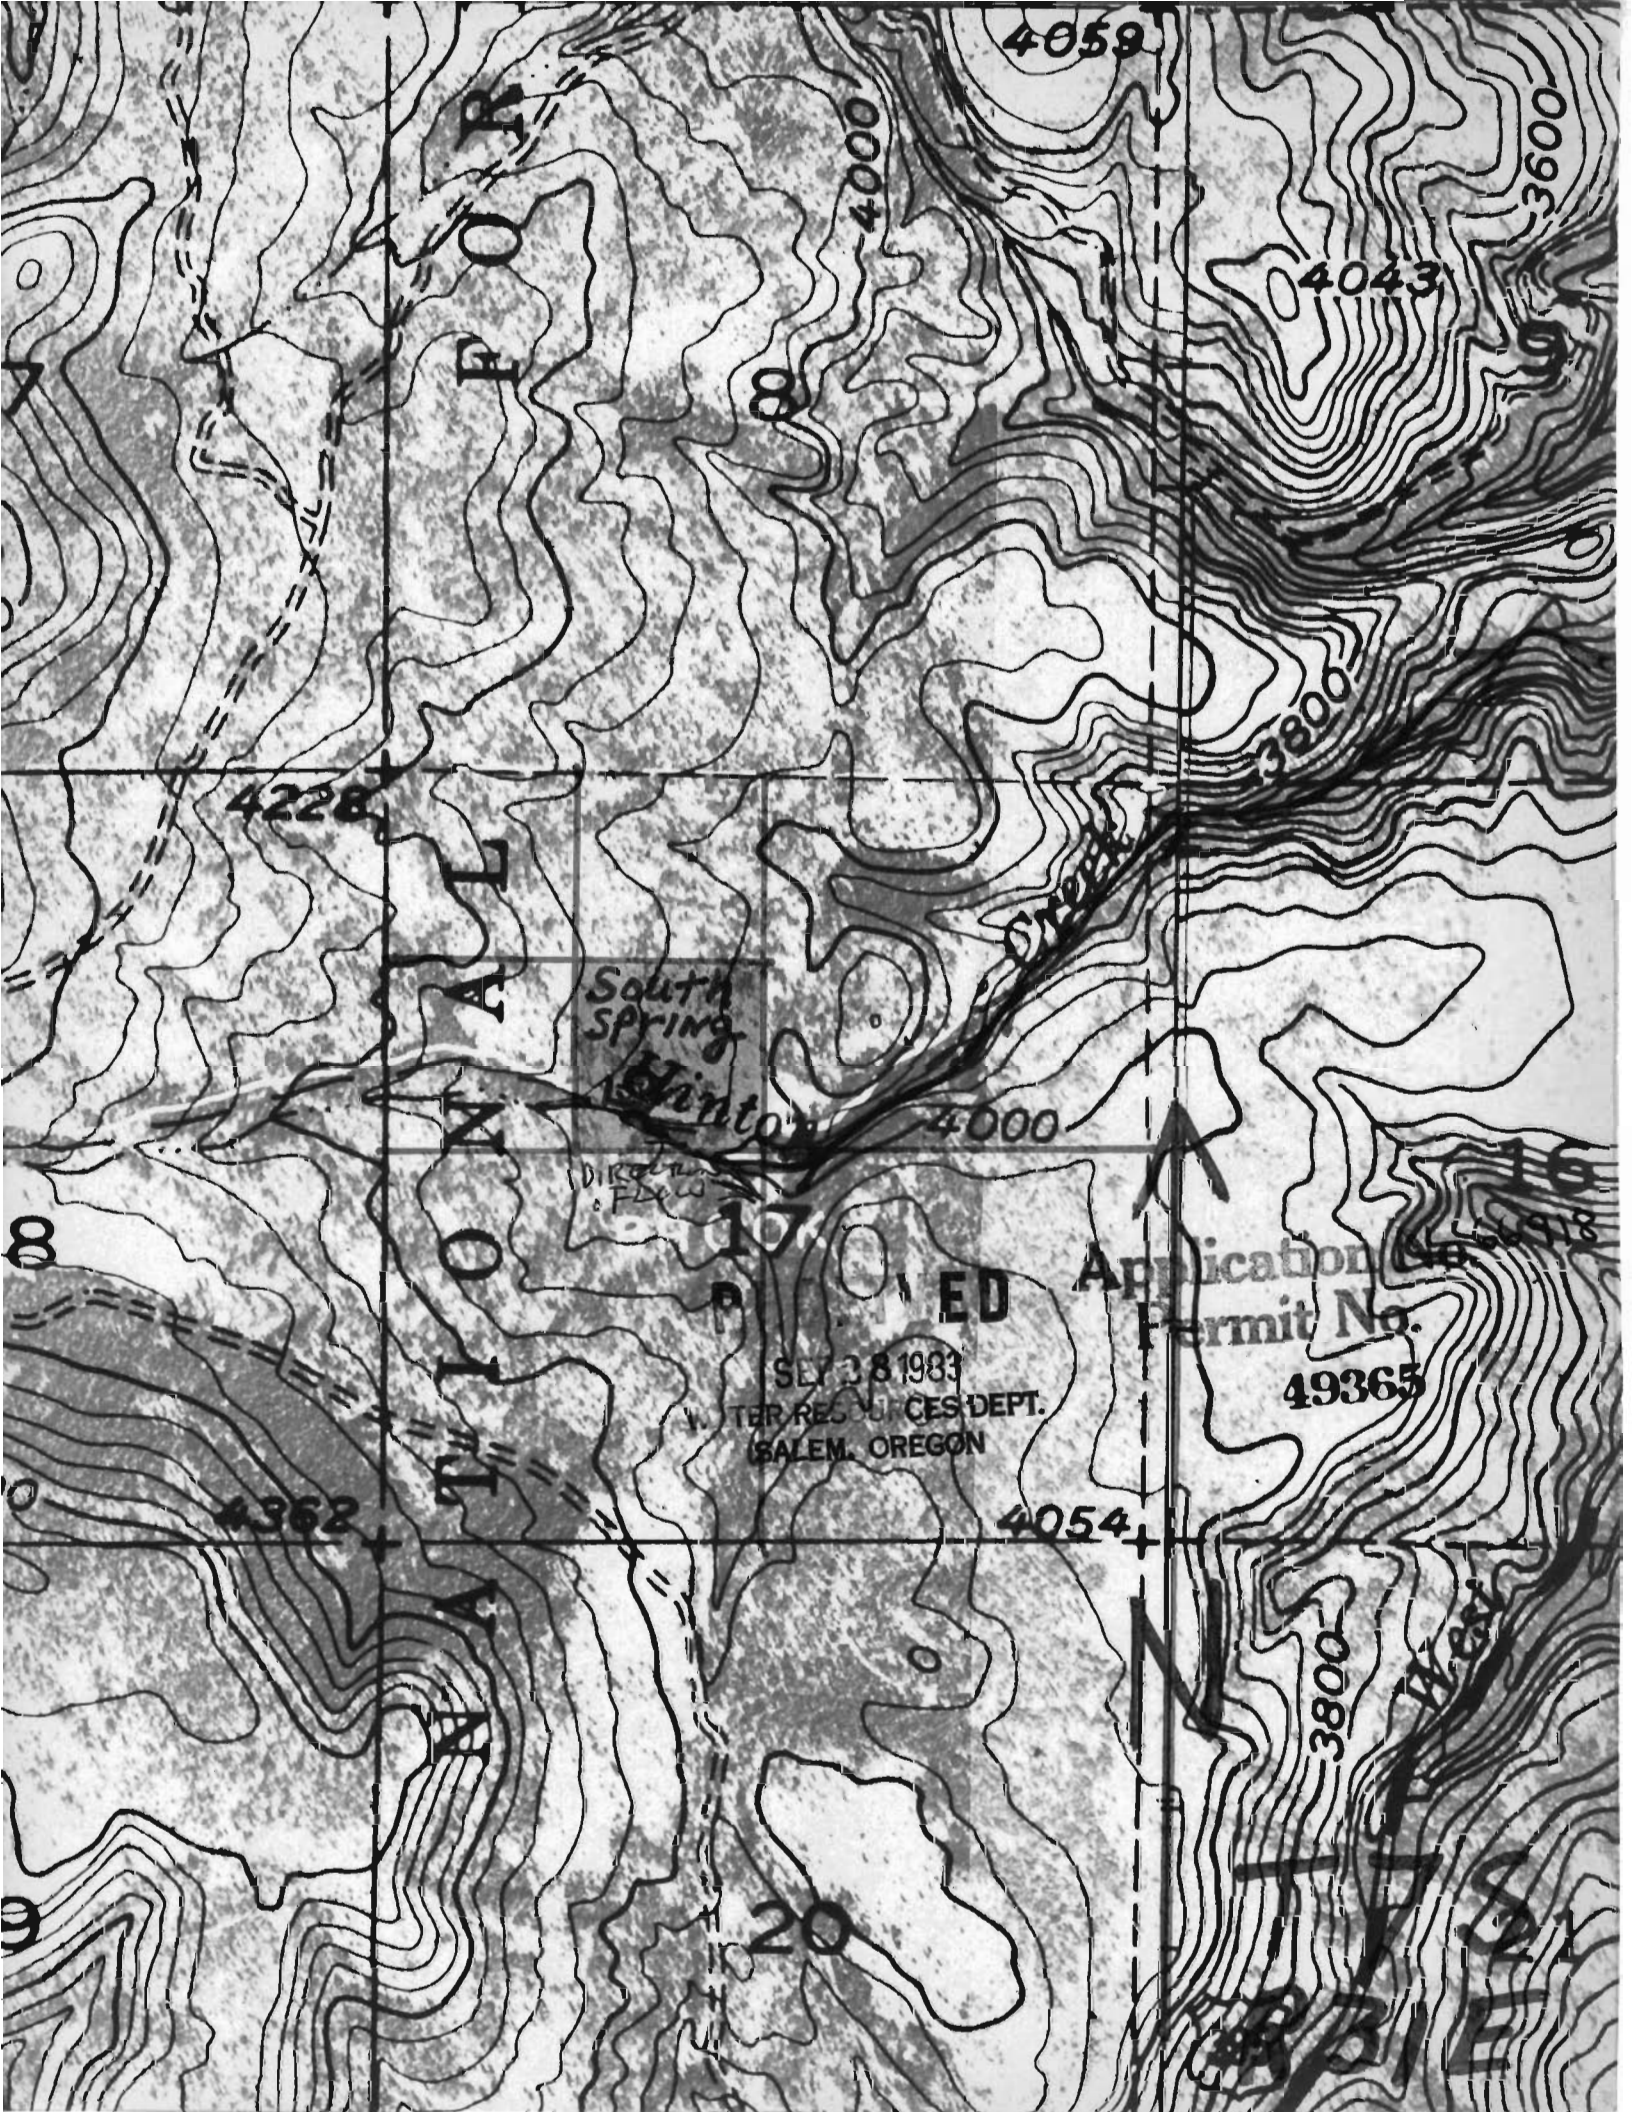

FOR
AL
ON
TIL
A

South
Spring
Winter

DIRECTOR
FDW

SLY 38 1983
WATER RESOURCES DEPT.
SALEM, OREGON

Permit No. 49365

N

CR
B
E